FED. ROAD DIST. NO.	STATE	FED. AID PROJ. NO.	FISCAL YEAR	SHEET NO.	TOTAL SHEETS
HAWAII	HAW.	S-0130(12)	1970	1	53

INDEX TO DRAWINGS

SHEET	DESCRIPTION
1	TITLE SHEET
2	TYPICAL SECTIONS AND OTHER DETAILS
3-10	PLAN AND PROFILE
11	PROFILE & CROSS SECTION OF SIDEROAD - STA. 80+50 RT.
12-13	DRAINAGE DETAILS
14-33	MISCELLANEOUS AND STANDARD DETAILS
34-53	CROSS SECTIONS

STATE OF HAWAII

DEPARTMENT OF TRANSPORTATION

HIGHWAYS DIVISION

"AS BUILT" PLANS OF

KAIMU - PAHOA ROAD

FEDERAL AID SECONDARY PROJECT NO. S-0130(12)

DISTRICT OF PUNA

ISLAND OF HAWAII

SCALES

PLAN		1 INCH = 100 FT.
PROFILE	HOR.	1 INCH = 100 FT.
	VER.	1 INCH = 10 FT.
CROSS SECTION	HOR.	1 INCH = 10 FT.
	VER.	1 INCH = 10 FT.

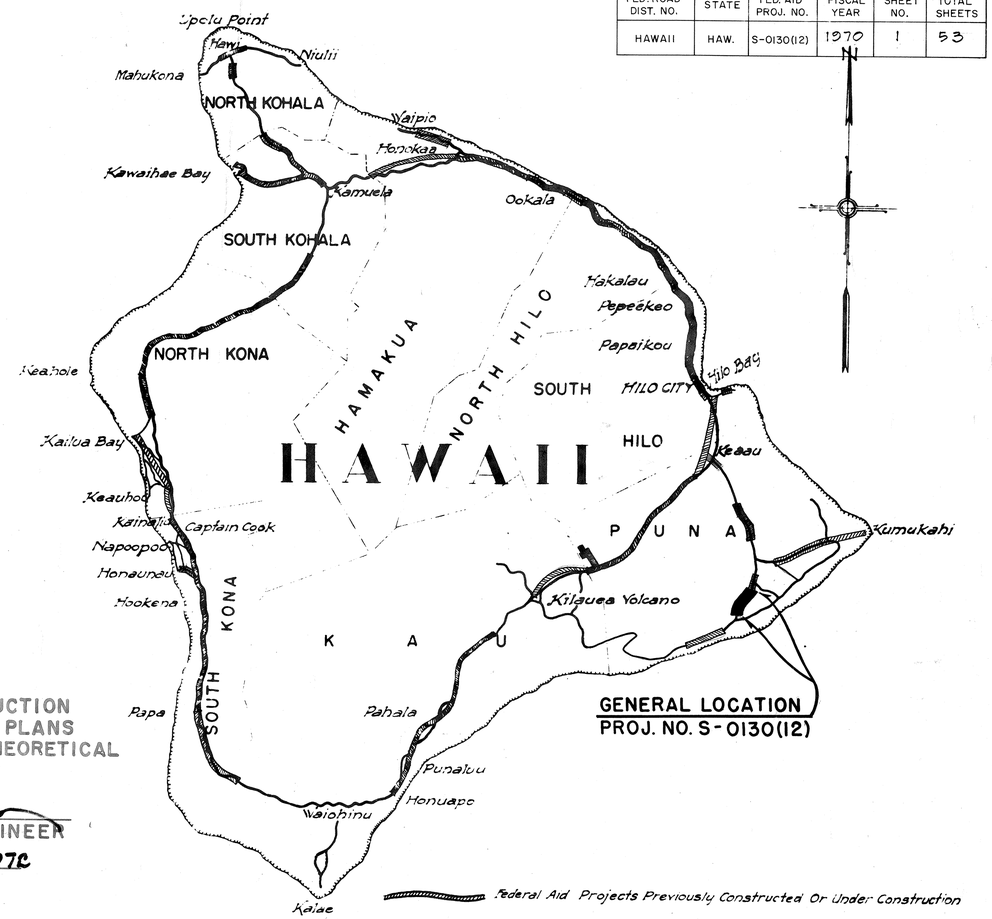

GENERAL LOCATION
PROJ. NO. S-0130(12)

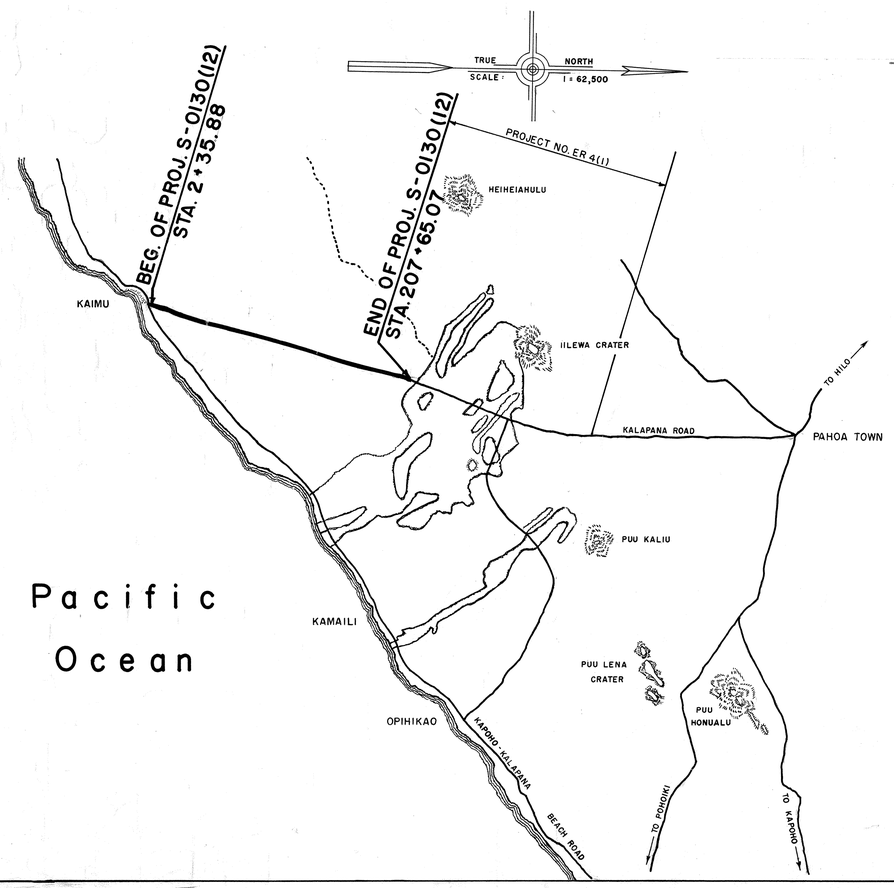

NOTE:

ALL CHANGES MADE DURING CONSTRUCTION HAVE BEEN INCORPORATED ON THESE PLANS EXCEPT CHANGES IN THE ORIGINAL THEORETICAL QUANTITIES.

PROJECT ENGINEER

June 13, 1970

DATE

DESIGN CLASSIFICATION

ADT (1970)	320
Design ADT (1990)	480
DHV	11%
D	65/35
T	4%
V	60 MPH

LAYOUT OF PROJECT

LENGTH OF PROJECT 3.88 Miles

DEPARTMENT OF TRANSPORTATION
STATE OF HAWAII

APPROVED:

E. Alvey Hughes 12/22/70

for DIRECTOR OF TRANSPORTATION DATE

ORIGINAL PLAN	SURVEYS PLOTTED BY	D. BEVIER
	DRAWN BY	
NOTE BOOK	TRACED BY	
	QUANTITIES BY	
	QUANTITIES CHECKED BY	
	CHECKED BY	
		DATE