FED. ROAD DIST. NO.	STATE	FED. AID PROJ. NO.	FISCAL YEAR	SHEET NO.	TOTAL SHEETS
HAWAII	HAW.	RS-0130 (23)	1987	1	5

INDEX TO DRAWINGS

SHEET NO.	DESCRIPTION
1	TITLE SHEET
2	STANDARD PLANS SUMMARY
3	PLAN
4	PANEL AND FRAME LAYOUT
5	CROSS SECTIONS

STATE OF HAWAII

DEPARTMENT OF TRANSPORTATION

HIGHWAYS DIVISION

"AS-BUILT"

PLANS FOR

PAHOA - KALAPANA ROAD

SAFETY IMPROVEMENTS AT KAMAILI ROAD

F.A.S. PROJECT NO. RS-0130(23)

DISTRICT OF PUNA

ISLAND OF HAWAII

130

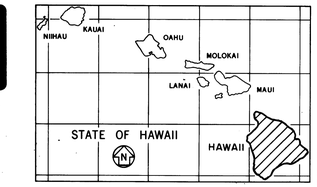

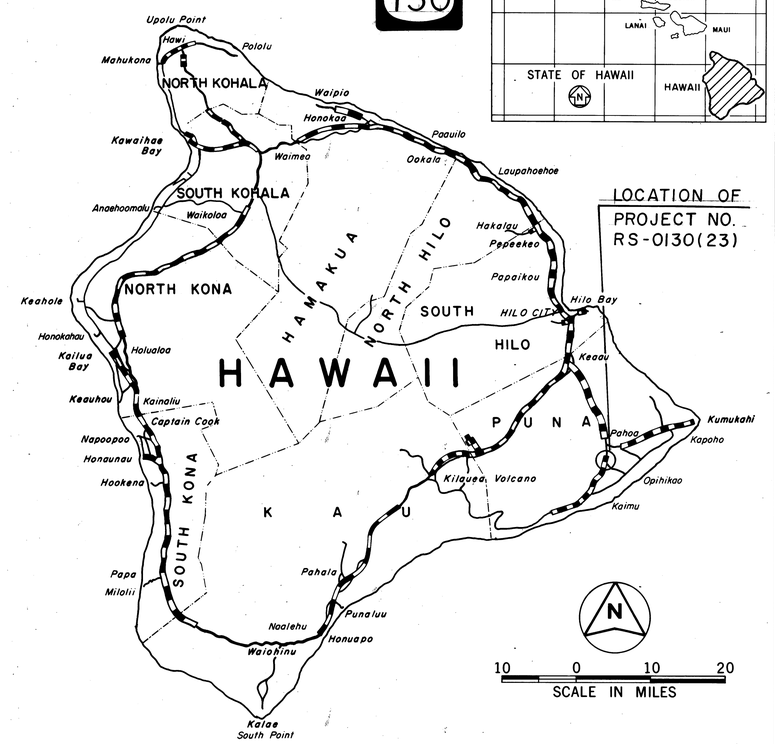

FEDERAL AID PROJECTS PREVIOUSLY CONSTRUCTED OR UNDER CONSTRUCTION

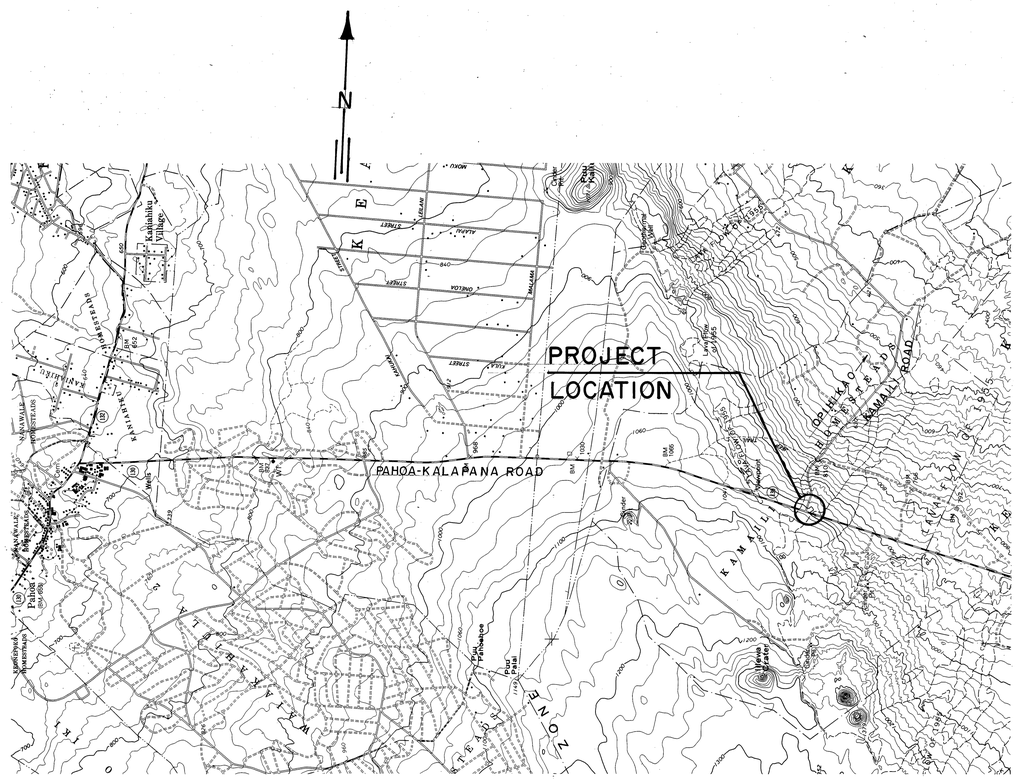
N
PROJECT LOCATION
PAHOA-KALAPANA ROAD
KAMAILI ROAD
OPIHIKAO
Kaimu
Kalapana
Kaimu Village
Pu'u Kamaili
Pu'u Pahoehoe
Pu'u Palali
Hawaiian Cemetery
Wells
