FED. ROAD DIST. NO.	STATE	PROJ. NO.	FISCAL YEAR	SHEET NO.	TOTAL SHEETS
HAWAII	HAW.	130A-01-92M	1992	1	10

INDEX TO DRAWINGS

SHEET NO.	DESCRIPTION
1	TITLE SHEET
2	STANDARD PLANS SUMMARY
3-4	TYPICAL SECTIONS & DETAILS
5-8	ROADWAY & STRIPING PLAN
9	MISCELLANEOUS SCHEDULES
10	CONSTRUCTION SIGN DETAIL, E.P. MARKING & SCHEDULES

STATE OF HAWAII

DEPARTMENT OF TRANSPORTATION

HIGHWAYS DIVISION

HONOLULU, HAWAII

PLANS FOR "AS BUILT" PAHOA - KALAPANA ROAD RESURFACING

KALAPANA TOWARDS PAHOA

PROJECT NO. 130A-01-92M

DISTRICT OF PUNA

ISLAND OF HAWAII

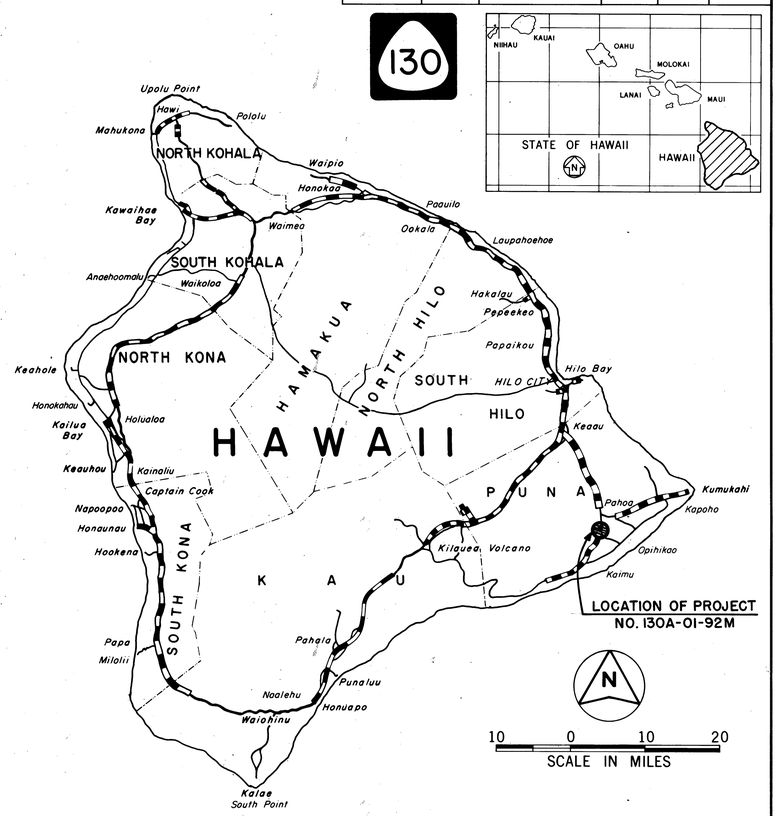

FEDERAL AID PROJECTS PREVIOUSLY CONSTRUCTED OR UNDER CONSTRUCTION

MILE POST 11.70 TO MILE POST 16.70

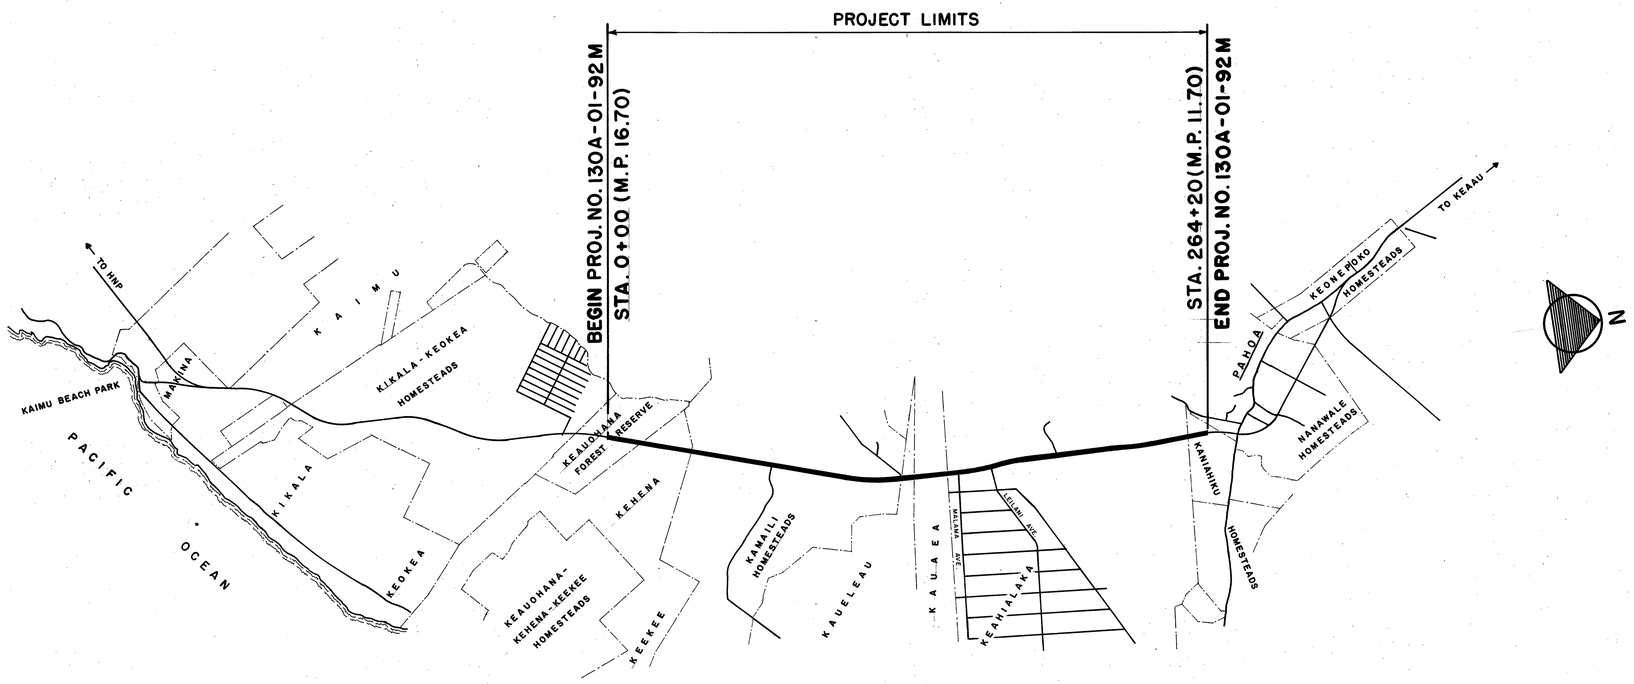

GENERAL LOCATION MAP

0.5 0

SCALE: IN MILES

ALL CHANGES MADE DURING CONSTRUCTION HAVE BEEN NOTED IN RED ON THESE TRACINGS AND CHECKED BY

PROJECT ENGINEER — DATE 2/28/96

HAWAII DISTRICT — DESIGNED BY — JULIUS B. FRONDA — P. S. & E. BY — 587-2246 — PHONE — JAN. 28, 1992 — DATE

DEPARTMENT OF TRANSPORTATION
STATE OF HAWAII

APPROVED:

For DIR. OF TRANSPORTATION — DATE 2/28/92

AS BUILT 1