FED. ROAD DIST. NO.	STATE	PROJ. NO.	FISCAL YEAR	SHEET NO.	TOTAL SHEETS
HAWAII	HAW.	130B-02-94	1994	1	12

130

STATE OF HAWAII

DEPARTMENT OF TRANSPORTATION

HIGHWAYS DIVISION
HONOLULU, HAWAII

"AS-BUILT"

PLANS FOR

KEAAU – PAHOA ROAD HIGHWAY LIGHTING,

BETWEEN HAWAII BELT ROAD AND PAHOA TOWN
PROJECT NO. 13OB-02-94

DISTRICT OF PUNA
ISLAND OF HAWAII

INDEX TO DRAWINGS

SHEET NO.	DESCRIPTION
1	TITLE SHEET
2	SITE PLAN, SYMBOL LIST, SVC DATA
3–10	SITE PLAN
11	STREET LIGHT AND POLE DETAILS
12	STREET LIGHT DETAILS

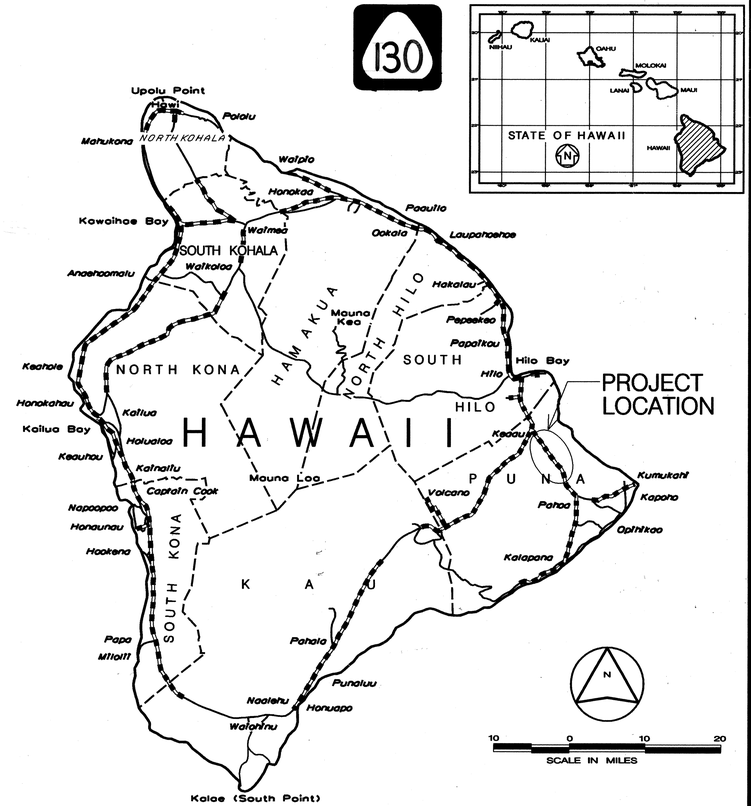

FEDERAL AID PROJECTS PREVIOUSLY CONSTRUCTED OR UNDER CONSTRUCTION

MILE POST 0.34 TO MILE POST 11.31

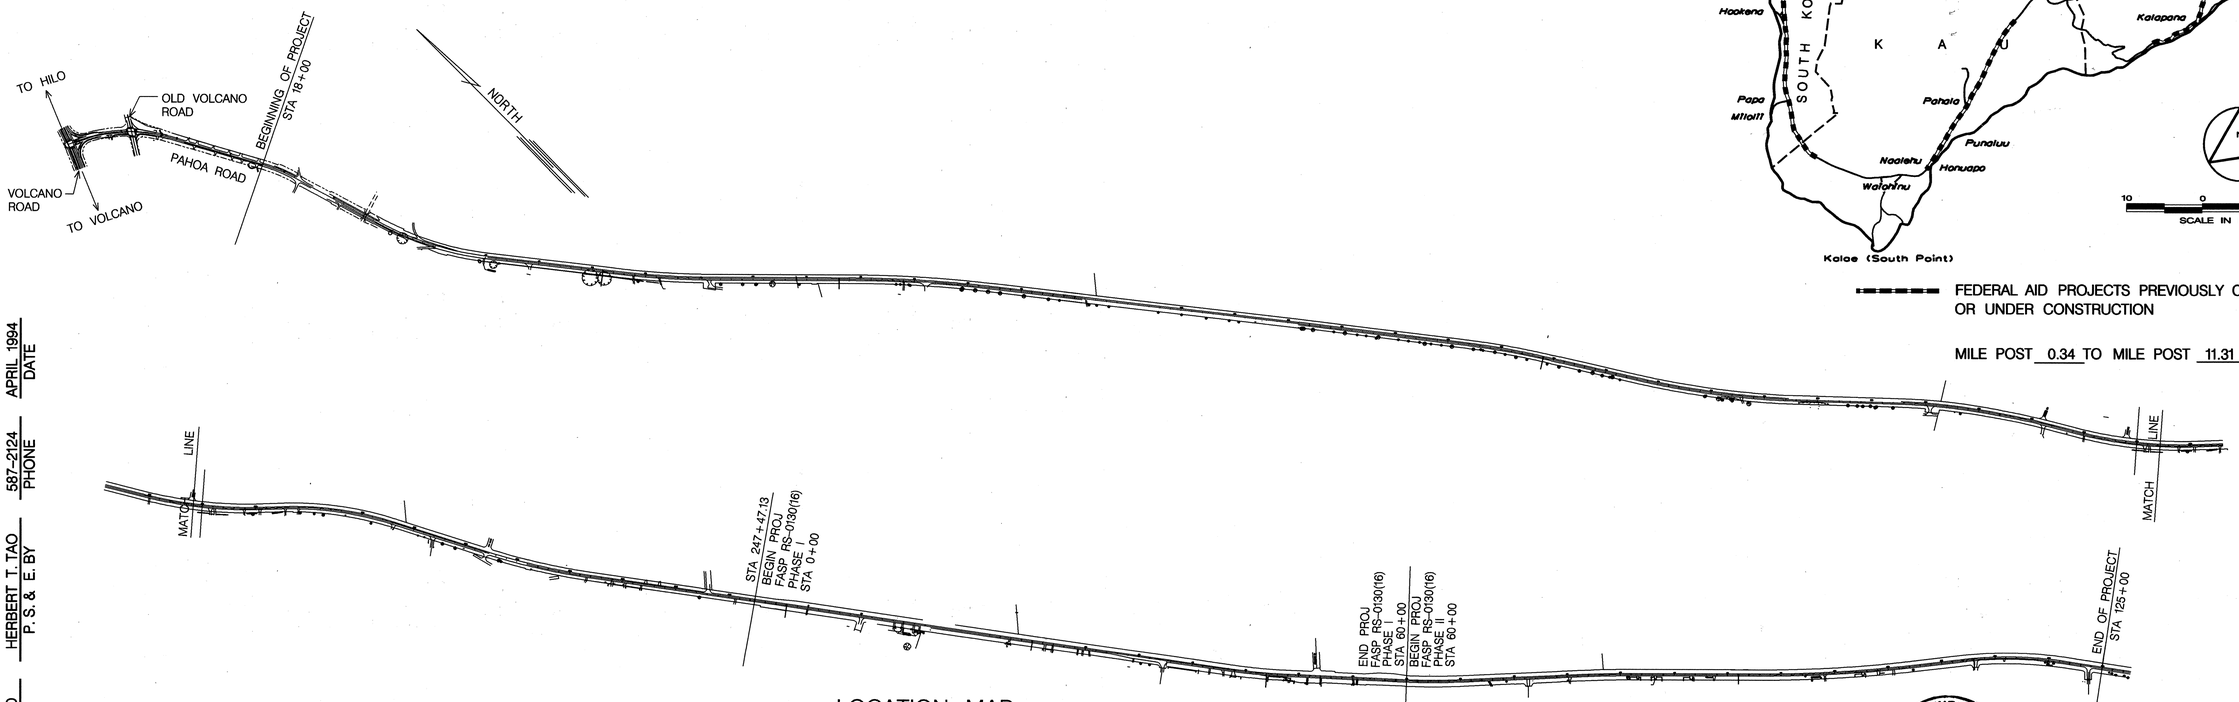

LOCATION MAP
NTS

CHANGES MADE DURING CONSTRUCTION HAVE BEEN INCORPORATED ON THESE PLANS EXCEPT CHANGES IN THE ORIGINAL THEORETICAL QUANTITIES. FOR ACTUAL QUANTITIES, REFER TO PROJECT LEDGER AND/OR COMPUTATION BOOK.

Robert Yee for June 12, 1998
RESIDENT ENGINEER DATE

R.C. KATAHIRA
REGISTERED PROFESSIONAL ENGINEER
No. 3181-E
HAWAII, U.S.A.

THIS WORK WAS PREPARED BY ME OR UNDER MY SUPERVISION.
5/12/94
MK ENGINEERS, LTD.

DEPARTMENT OF TRANSPORTATION
STATE OF HAWAII

APPROVED:
5/18/94
DIR. OF TRANSPORTATION DATE

MK ENGINEERS, LTD	APRIL 1994
DESIGNED BY	DATE
HERBERT T. TAO	587-2124
P. S. & E. BY	PHONE