FED. ROAD DIST. NO.	STATE	PROJ. NO.	FISCAL YEAR	SHEET NO.	TOTAL SHEETS
HAWAII	HAW.	130A-01-99	2000	5	18

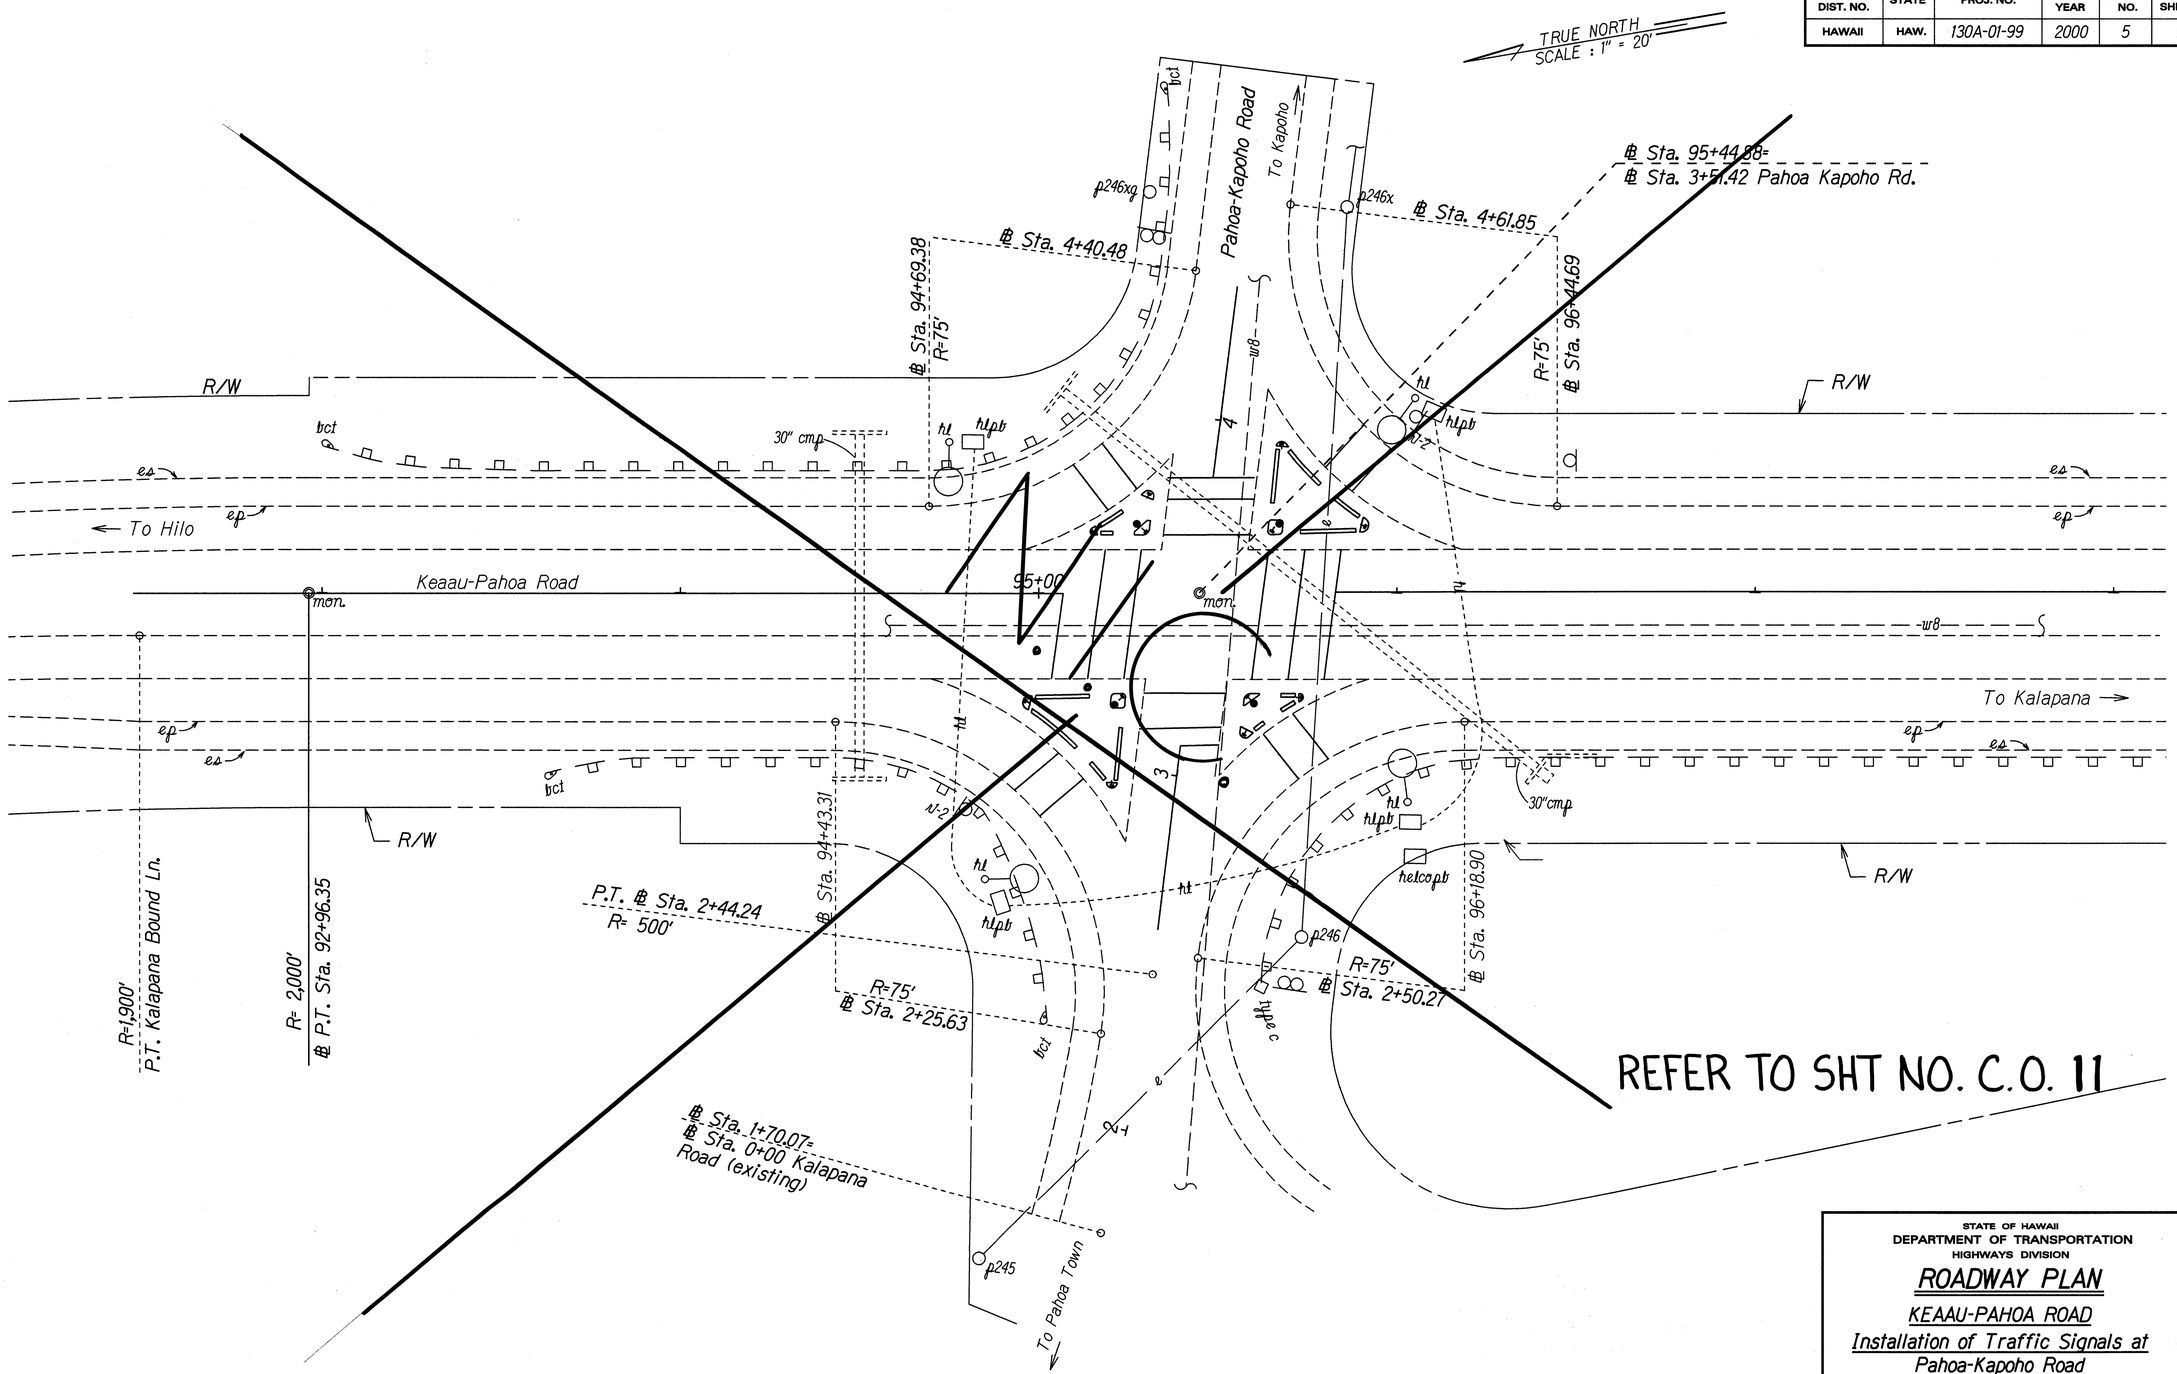

STATE OF HAWAII
DEPARTMENT OF TRANSPORTATION
HIGHWAYS DIVISION

ROADWAY PLAN

KEAAU-PAHOA ROAD

Installation of Traffic Signals at
Pahoa-Kapoho Road
Project No. 130A-01-99

Scale: 1"=20' Date: April, 2000

SHEET No. 1 OF 1 SHEETS

ORIGINAL PLAN | SURVEY PLOTTED BY | DRAWN BY M. Takatsuji | TRACED BY | DESIGNED BY Richard Mesa | QUANTITIES BY | CHECKED BY | DATE 6/10/98
NOTE BOOK | 1d/1.1dy | 3p/rtp | No.

"AS-BUILT"