FED. ROAD DIST. NO.	STATE	FED. AID PROJ. NO.	FISCAL YEAR	SHEET NO.	TOTAL SHEETS
HAWAII	HAW.	R5-0130(24)	2000	55	55

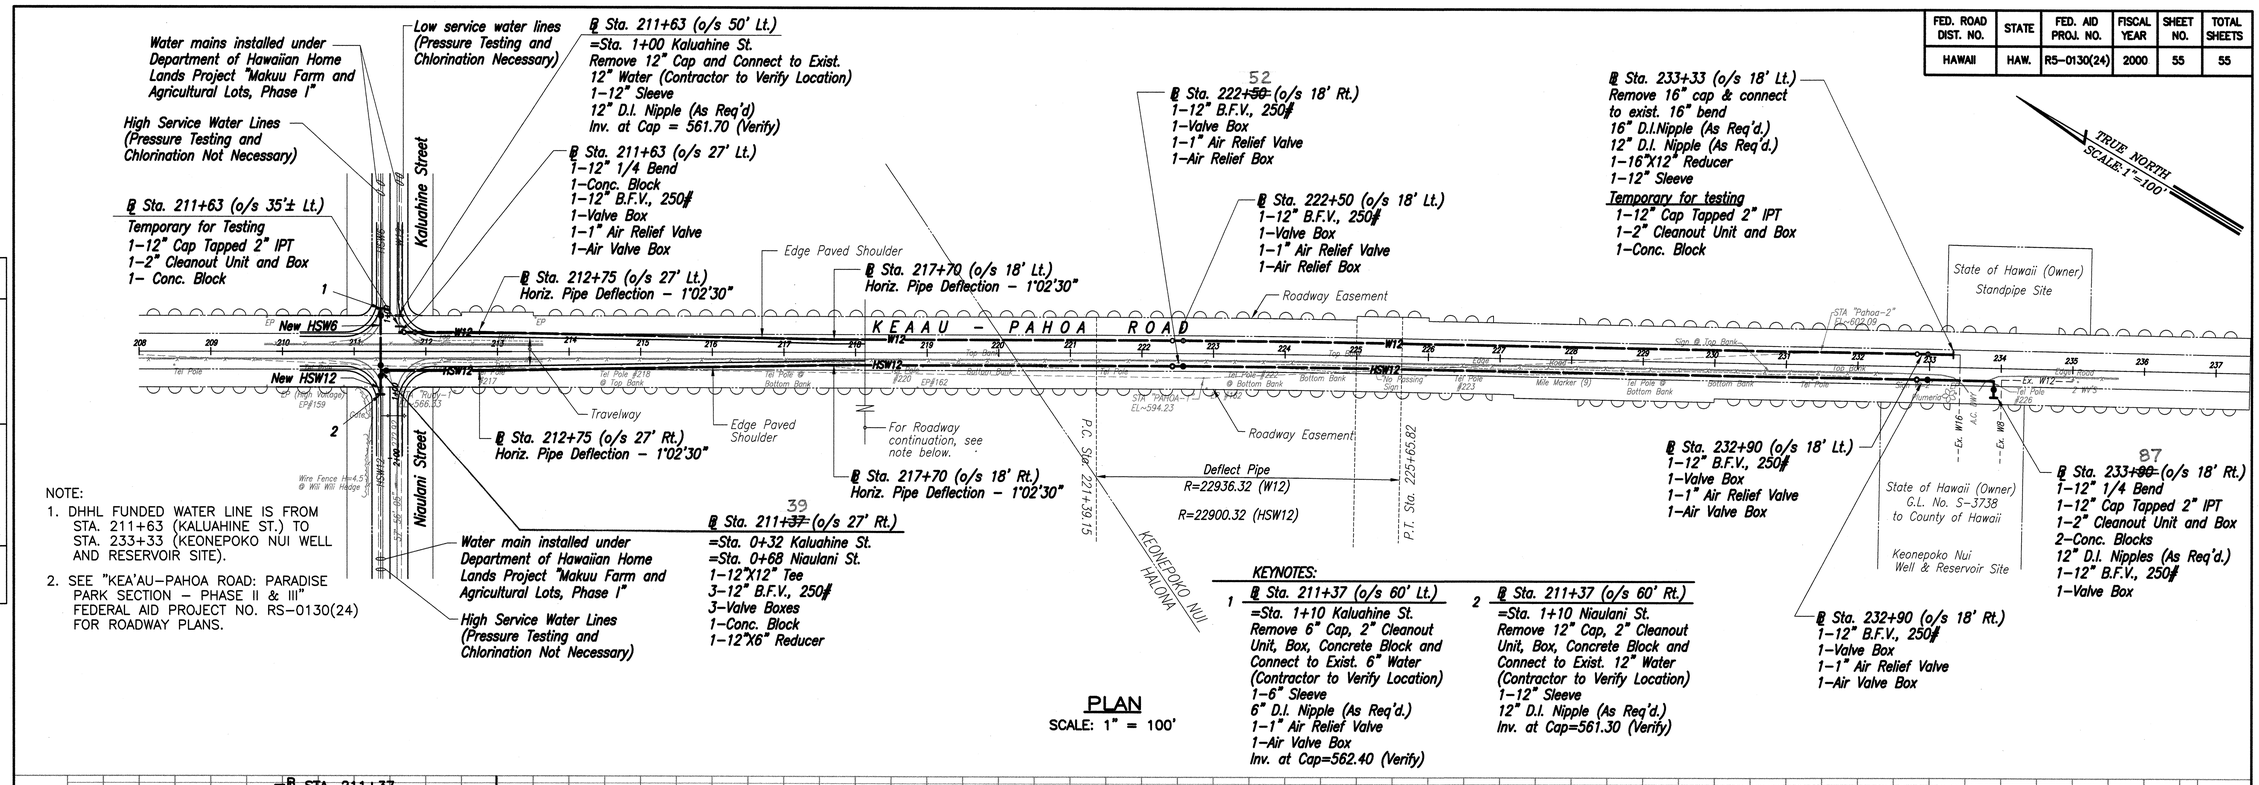

NOTE:

1. DHHL FUNDED WATER LINE IS FROM STA. 211+63 (KALUAHINE ST.) TO STA. 233+33 (KEONEPOKO NUI WELL AND RESERVOIR SITE).
2. SEE "KEA'AU-PAHOA ROAD: PARADISE PARK SECTION - PHASE II & III" FEDERAL AID PROJECT NO. RS-0130(24) FOR ROADWAY PLANS.

KEYNOTES:

1 @ Sta. 211+37 (o/s 60' Lt.)
=Sta. 1+10 Kaluahine St.
Remove 6" Cap, 2" Cleanout Unit, Box, Concrete Block and Connect to Exist. 6" Water (Contractor to Verify Location)
1-6" Sleeve
6" D.I. Nipple (As Req'd.)
1-1" Air Relief Valve
1-Air Valve Box
Inv. at Cap=562.40 (Verify)

2 @ Sta. 211+37 (o/s 60' Rt.)
=Sta. 1+10 Niaulani St.
Remove 12" Cap, 2" Cleanout Unit, Box, Concrete Block and Connect to Exist. 12" Water (Contractor to Verify Location)
1-12" Sleeve
12" D.I. Nipple (As Req'd.)
Inv. at Cap=561.30 (Verify)

PLAN
SCALE: 1" = 100'

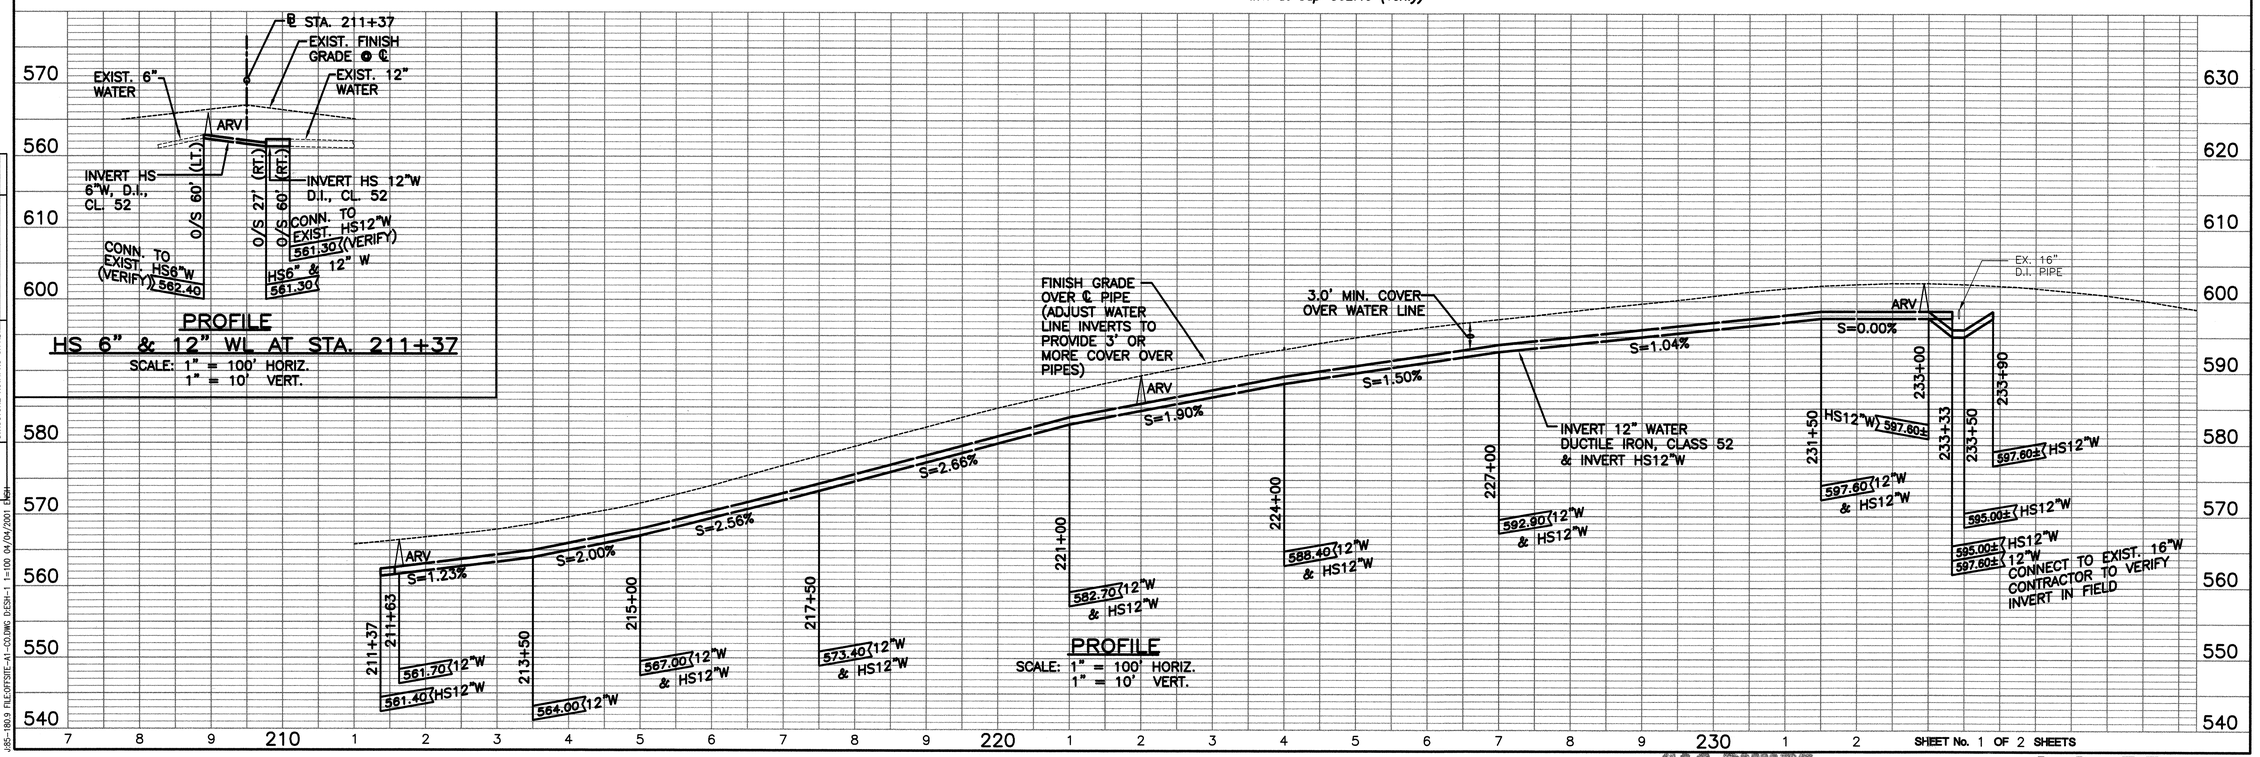

SHEET No. 1 OF 2 SHEETS

"AS-BUILT"

C.O. 55