FISCAL YEAR	STATE	ROUTE NUMBER	SECTION	SHEET	TOTAL SHEETS
1965	HAWAII	S-0160(2) Unit I		1	31

INDEX TO DRAWINGS

SHEET	DESCRIPTION
1	Title Sheet
2	Typical Sections
3-7	Plan and Profile
8-13	Standard Details
14-31	Cross Sections

STATE OF HAWAII
DEPARTMENT OF TRANSPORTATION
HIGHWAYS DIVISION

"AS-BUILT" PLANS FOR
CONSTRUCTION OF

CITY OF REFUGE ROAD

(END OF PROJ. S-0160(1) TO CITY OF REFUGE NATIONAL HISTORICAL PARK)

FEDERAL AID SECONDARY PROJECT NO. S-0160(2)
UNIT I

DISTRICT OF SOUTH KONA
ISLAND OF HAWAII

SCALES

PLAN		1 INCH = 100 FT.
PROFILE	HOR.	1 INCH = 100 FT.
	VER.	1 INCH = 10 FT.
CROSS SECTION	HOR.	1 INCH = 10 FT.
	VER.	1 INCH = 10 FT.

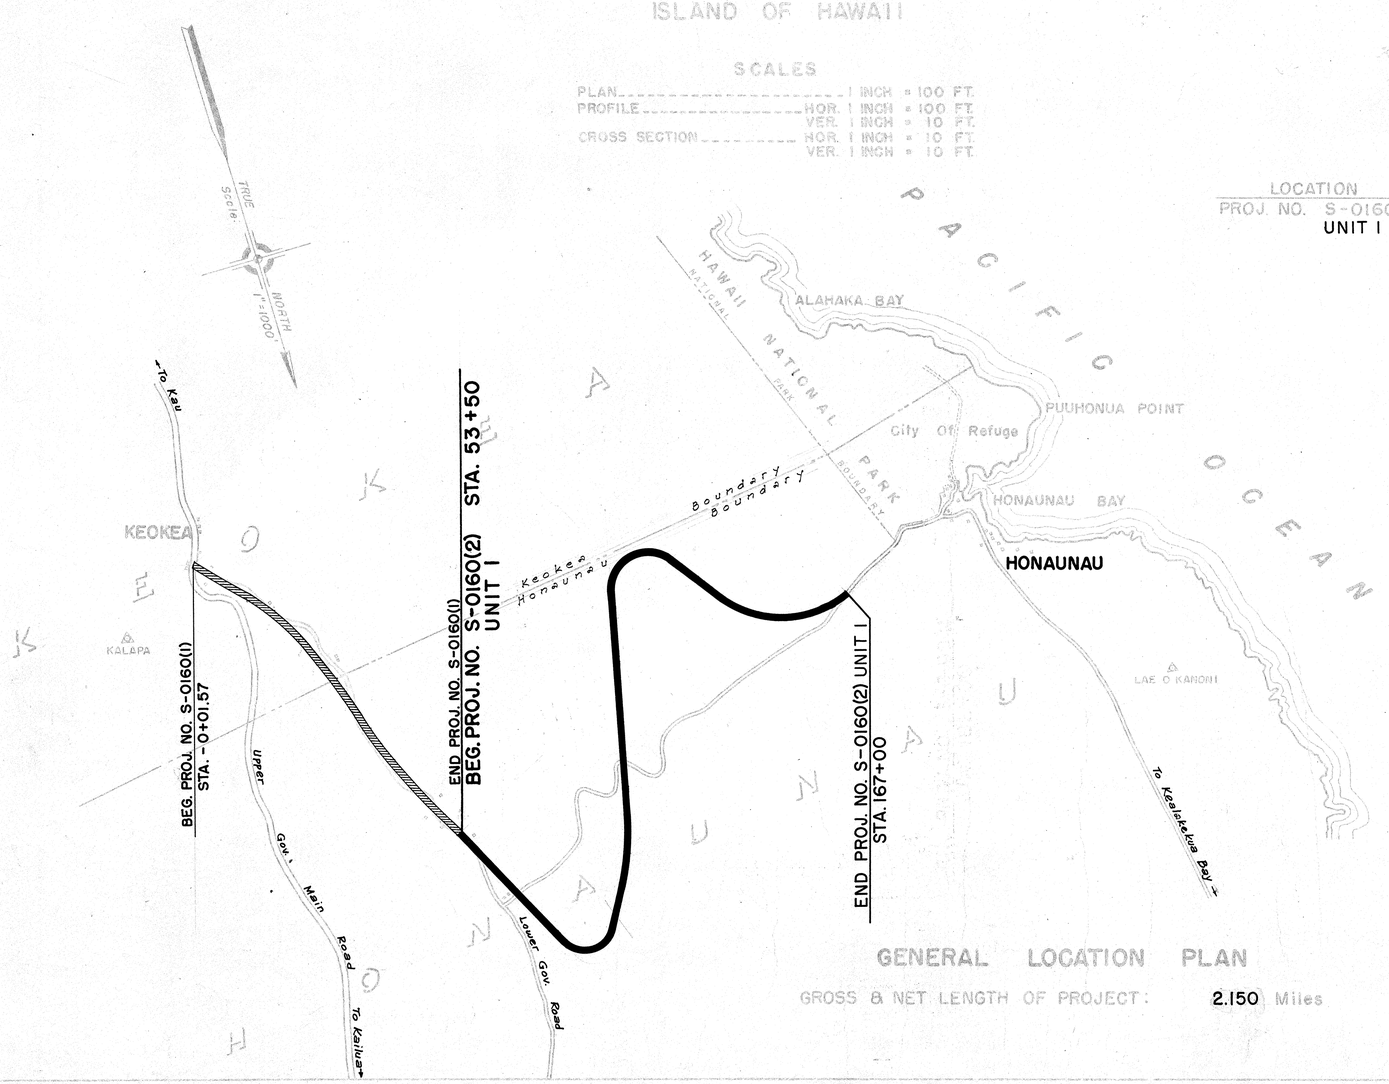

GENERAL LOCATION PLAN

GROSS & NET LENGTH OF PROJECT: 2.150 Miles

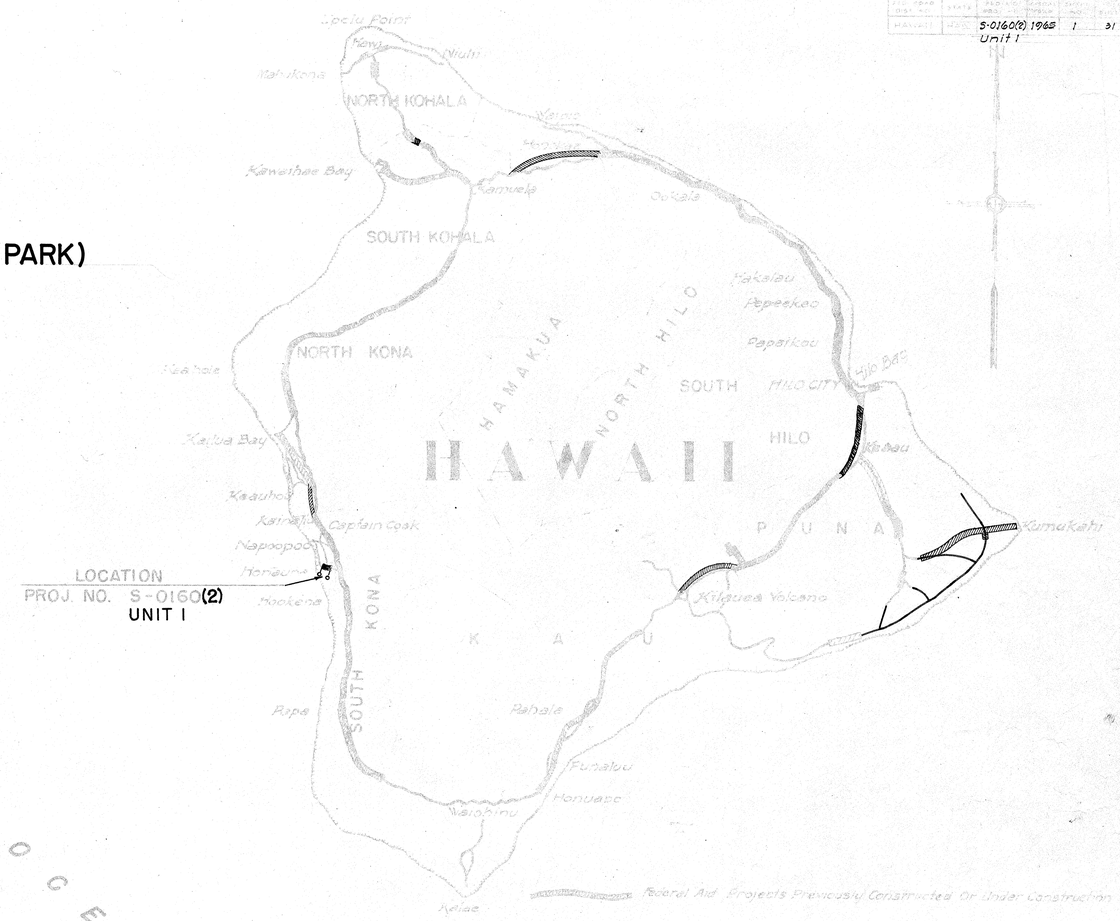

DESIGN CLASSIFICATION

ADT (1964)	150
Design ADT (1982)	1250
DHV	11%
D	60/40
T	9%
V	40 MPH

NOTE

All changes made during construction has been noted in red on these tracings and checked by:

Project Engineer — Date 11/22/66

APPROVED: DATE 23 Aug 65
Lujio Matsuda
DIRECTOR OF TRANSPORTATION

DEPARTMENT OF COMMERCE
BUREAU OF PUBLIC ROADS
APPROVED: John G Dalbom 9/2/65
DIVISION ENGINEER DATE