


PLAN	SURVEYED	BY	DATE
NOTE BOOK	ALIGNED	CHECKED	NO.
NO.	RT. OF WAY	CHECKED	NO.

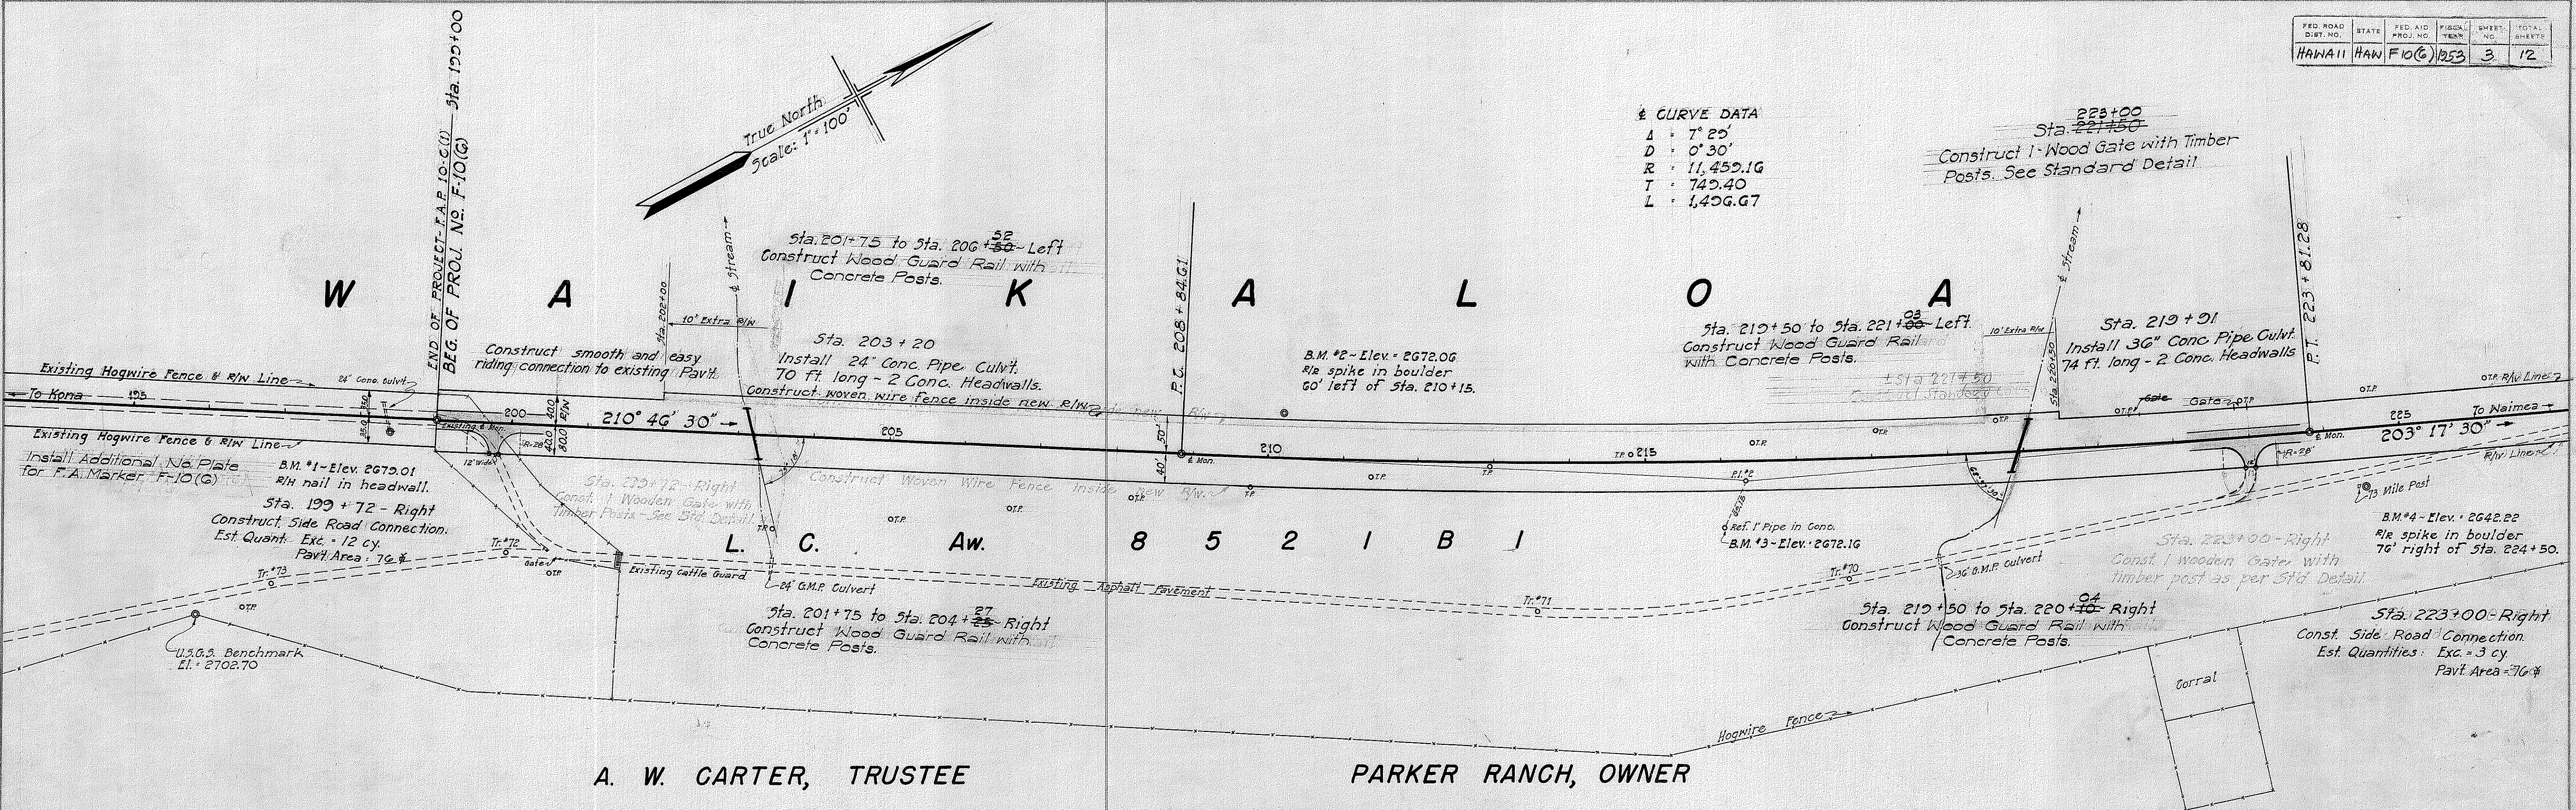

PROFILE	SURVEYED	BY	DATE
NOTE BOOK	GRADES	CHECKED	NO.
NO.	STRUCTURE	NOTES	CHD.

