FED. ROAD DIST. NO.	STATE	PROJ. NO.	FISCAL YEAR	SHEET NO.	TOTAL SHEETS
HAWAII	HAW.	190CD-01-88M	1988	1	8

INDEX TO DRAWINGS

SHEET NO.	DESCRIPTION
1	TITLE SHEET
2	STANDARD PLANS SUMMARY
3	TYPICAL SECTION
4-7	ROADWAY & STRIPING PLAN
7	CONSTRUCTION SIGN PLAN
8	PAVEMENT MARKER, & MONUMENT & CONSTRUCTION SIGN SCHEDULES

STATE OF HAWAII

DEPARTMENT OF TRANSPORTATION

HIGHWAYS DIVISION

HONOLULU, HAWAII

"AS-BUILT"

PLANS FOR

HAWAII BELT ROAD RESURFACING

PUUANAHULU TO WAIKOLOA

PROJ. NO. 190CD-01-88M

DISTRICT OF SOUTH KOHALA AND NORTH KONA

ISLAND OF HAWAII

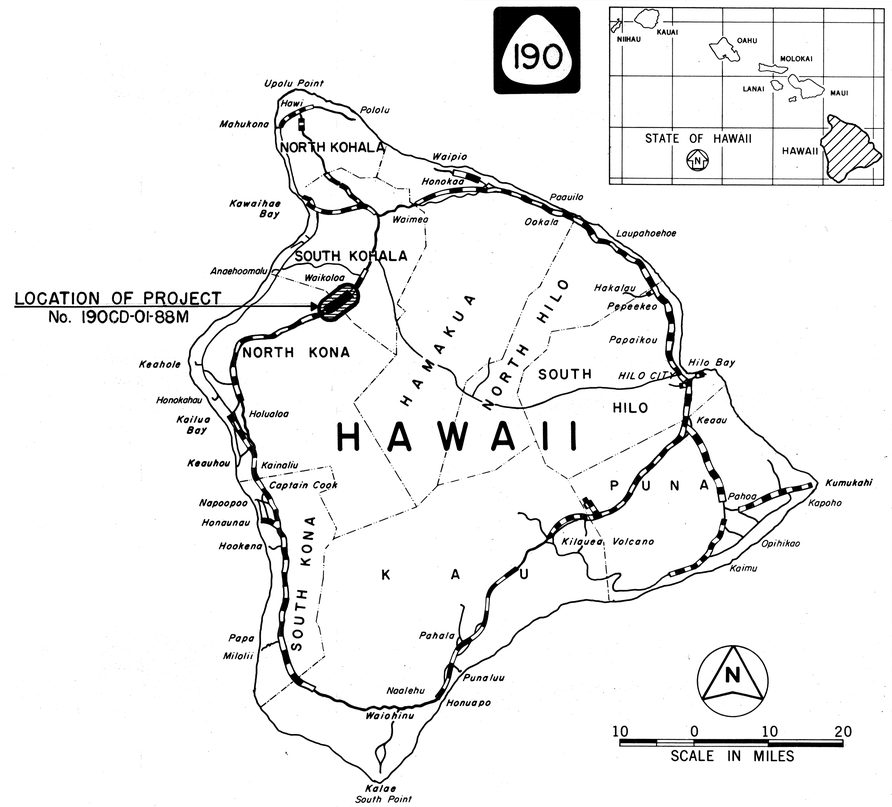

FEDERAL AID PROJECTS PREVIOUSLY CONSTRUCTED OR UNDER CONSTRUCTION

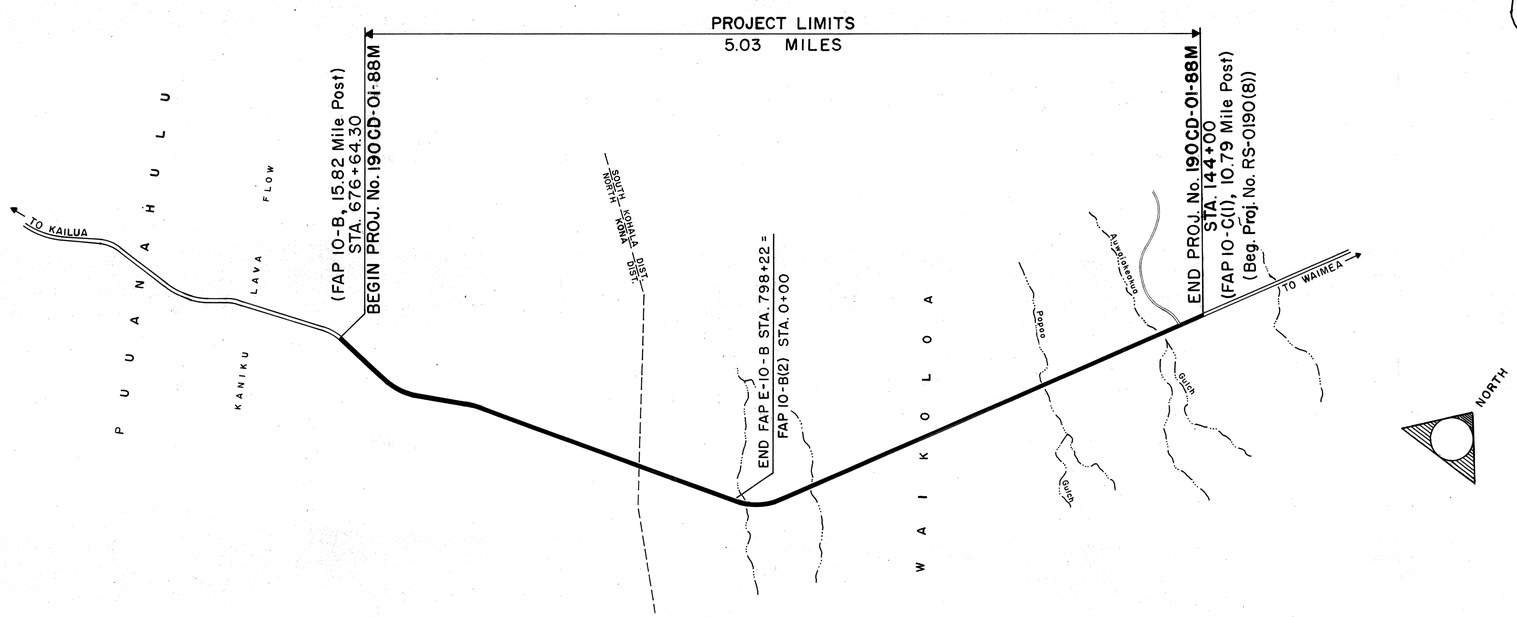

LAYOUT OF PROJECT

1 0 1 2 3 4 5 6 7

SCALE IN THOUSAND FEET

CHANGES MADE DURING CONSTRUCTION HAVE BEEN INCORPORATED ON THESE PLANS EXCEPT CHANGES IN THE ORIGINAL THEORETICAL QUANTITIES. FOR ACTUAL QUANTITIES, REFER TO PROJECT LEDGER AND/OR COMPUTATION BOOK.

Roy Shioji — RESIDENT ENGINEER — 4/24/89 DATE

DEPARTMENT OF TRANSPORTATION
STATE OF HAWAII

APPROVED:

Edward Y. Hirata — DIR. OF TRANSPORTATION — 4/28/88 DATE

HAWAII DISTRICT — DESIGNED BY

ROY T. NAGASAKO — P. S. & E. BY

548-2456 — PHONE

Apr. 1988 — DATE