FED. ROAD DIST. NO.	STATE	PROJ. NO.	FISCAL YEAR	SHEET NO.	TOTAL SHEETS
HAWAII	HAW.	190BC-01-90M	1990	1	10

INDEX TO DRAWINGS

SHEET NO.	DESCRIPTION
1	TITLE SHEET
2	STANDARD PLANS SUMMARY
3	TYPICAL SECTIONS AND DETAILS
4-8	ROADWAY AND STRIPING PLANS
9,10	MICS. SCHEDULES & DETAILS

STATE OF HAWAII

DEPARTMENT OF TRANSPORTATION

HIGHWAYS DIVISION

HONOLULU, HAWAII

"AS BUILT"

PLANS FOR

HAWAII BELT ROAD RESURFACING

PUU WAAWAA TO KAUPULEHU

PROJECT NO. 190BC-01-90M

DISTRICT OF NORTH KONA

ISLAND OF HAWAII

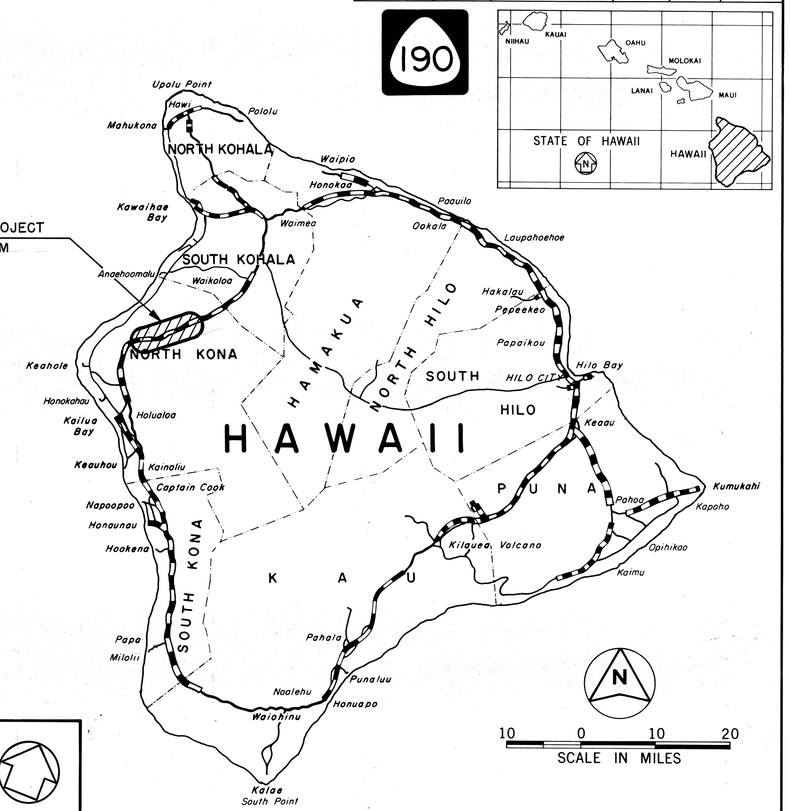

FEDERAL AID PROJECTS PREVIOUSLY CONSTRUCTED OR UNDER CONSTRUCTION

MILE POST 20.48 TO MILE POST 27.62 ~~27.39~~

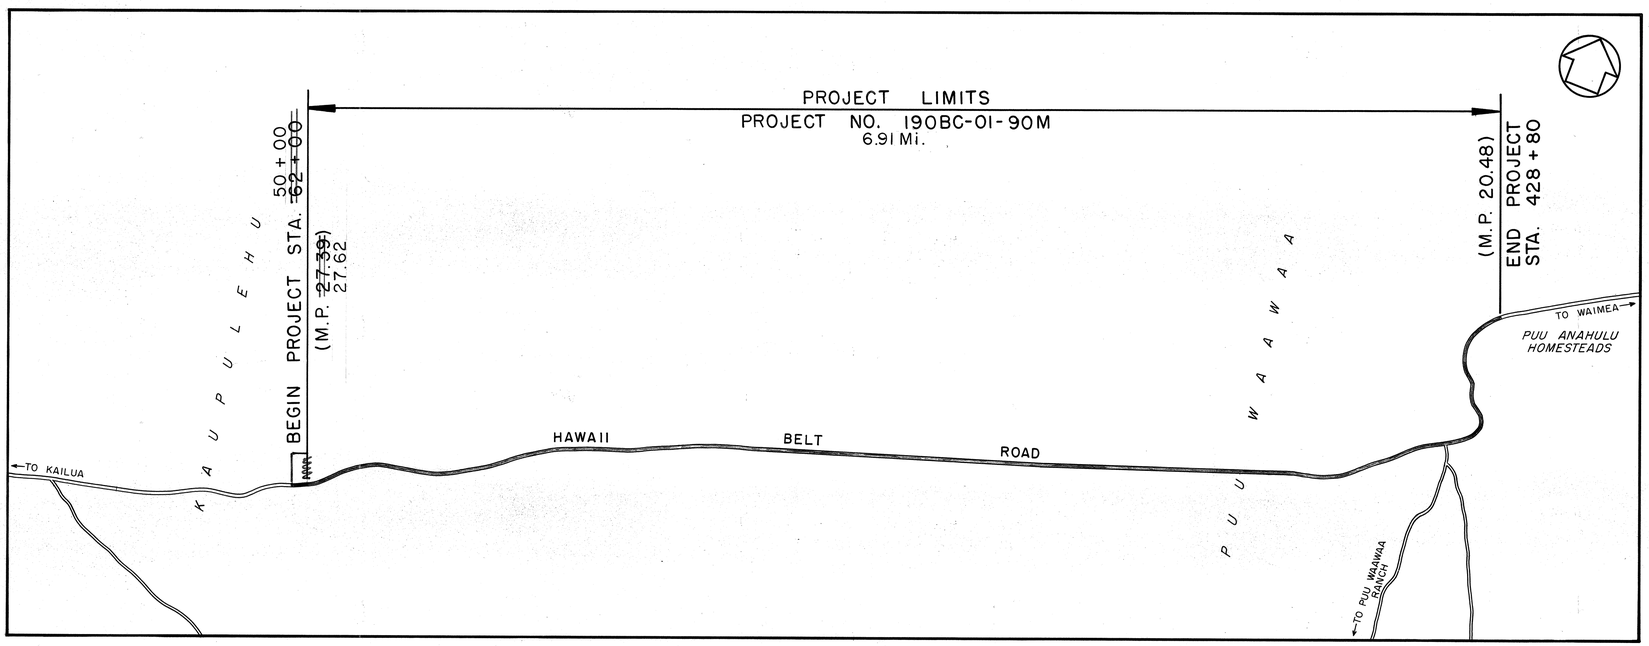

LAYOUT OF PROJECT

2 1 0 2 4 6
SCALE IN THOUSAND FEET

CHANGES MADE DURING CONSTRUCTION HAVE BEEN INCORPORATED ON THESE PLANS EXCEPT CHANGES IN THE ORIGINAL THEORETICAL QUANTITIES. FOR ACTUAL QUANTITIES, REFER TO PROJECT LEDGER AND/OR COMPUTATION BOOK.

E. Ikawa — RESIDENT ENGINEER — 4-30-91 DATE

HAWAII DISTRICT — DESIGNED BY
A. NISHIMURA — P. S. & E. BY
7490 — PHONE
MARCH 19 — DATE

DEPARTMENT OF TRANSPORTATION
STATE OF HAWAII

APPROVED:

Edward Hirata — DIR. OF TRANSPORTATION — 5/13/90 DATE