FED. ROAD DIST. NO.	STATE	~~FED. AID~~ PROJ. NO.	FISCAL YEAR	SHEET NO.	TOTAL SHEETS
HAWAII	HAW.	190B-01-91M	1991	1	10

INDEX TO DRAWINGS

SHEET NO.	DESCRIPTION
1	TITLE SHEET
2	STANDARD PLANS SUMMARY
3	TYPICAL SECTIONS & DETAIL
4-8	ROADWAY & STRIPING PLAN
9	NOTES, DETAILS AND PAVEMENT MARKER SCHEDULE
10	CONSTRUCTION SIGN DETAIL, NOTES & MISC. SCHEDULES

STATE OF HAWAII

DEPARTMENT OF TRANSPORTATION

HIGHWAYS DIVISION

HONOLULU, HAWAII

"AS-BUILT"

PLANS FOR

HAWAII BELT ROAD RESURFACING

HONOKOHAU TO KAUPULEHU

PROJECT NO. 190B-01-91M

DISTRICT OF NORTH KONA

ISLAND OF HAWAII

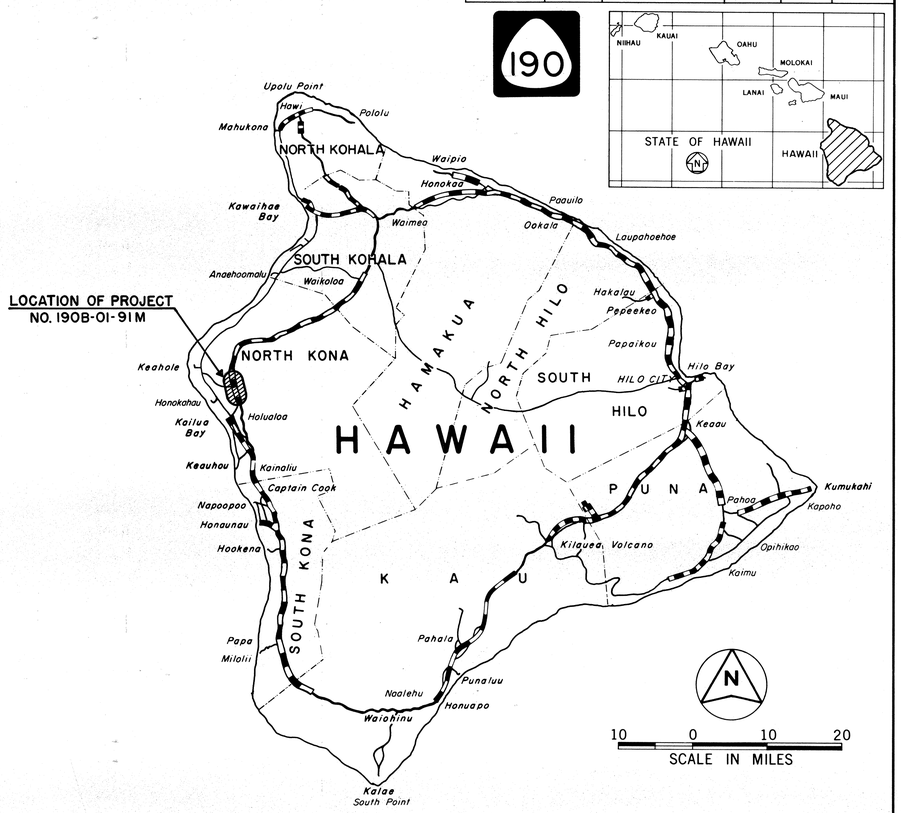

FEDERAL AID PROJECTS PREVIOUSLY CONSTRUCTED OR UNDER CONSTRUCTION

MILE POST 28.40 TO MILE POST 35.32

PROJECT LIMITS

6.92 MILES

BEGIN PROJ. 190B-01-91M

STA. 41+00 (M.P. 35.32)

STA. 406+50 (M.P. 28.40)

END PROJ. 190B-01-91M

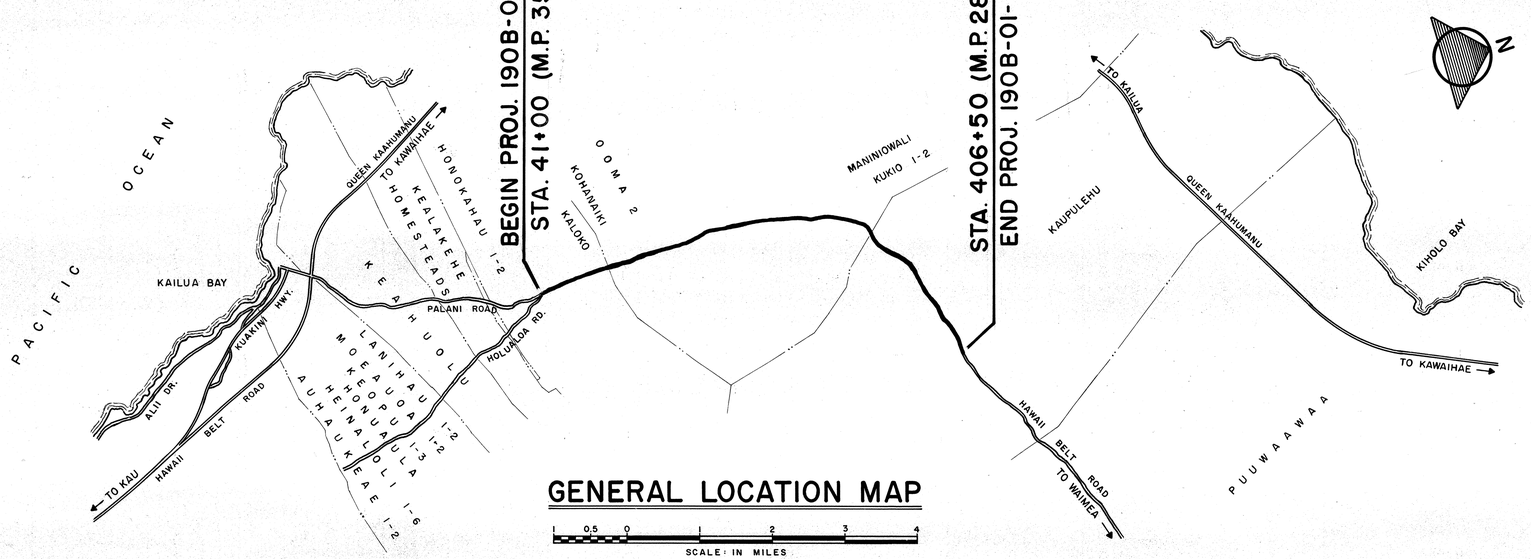

GENERAL LOCATION MAP

CHANGES MADE DURING CONSTRUCTION HAVE BEEN INCORPORATED ON THESE PLANS EXCEPT CHANGES IN THE ORIGINAL THEORETICAL QUANTITIES. FOR ACTUAL QUANTITIES, REFER TO PROJECT LEDGER AND/OR COMPUTATION BOOK.

RESIDENT ENGINEER — DATE 6/10/92

DEPARTMENT OF TRANSPORTATION
STATE OF HAWAII

APPROVED:

DIR. OF TRANSPORTATION — DATE 3/1/91

HAWAII DISTRICT — DESIGNED BY J. KASAMOTO — P. S. & E. BY — 548-7537 PHONE — FEB., 1991 DATE

D-7-5