FED. ROAD DIST. NO.	STATE	FED. AID PROJ. NO.	FISCAL YEAR	SHEET NO.	TOTAL SHEETS
HAWAII	HAW.	STP-0190(016)	2016	8	36

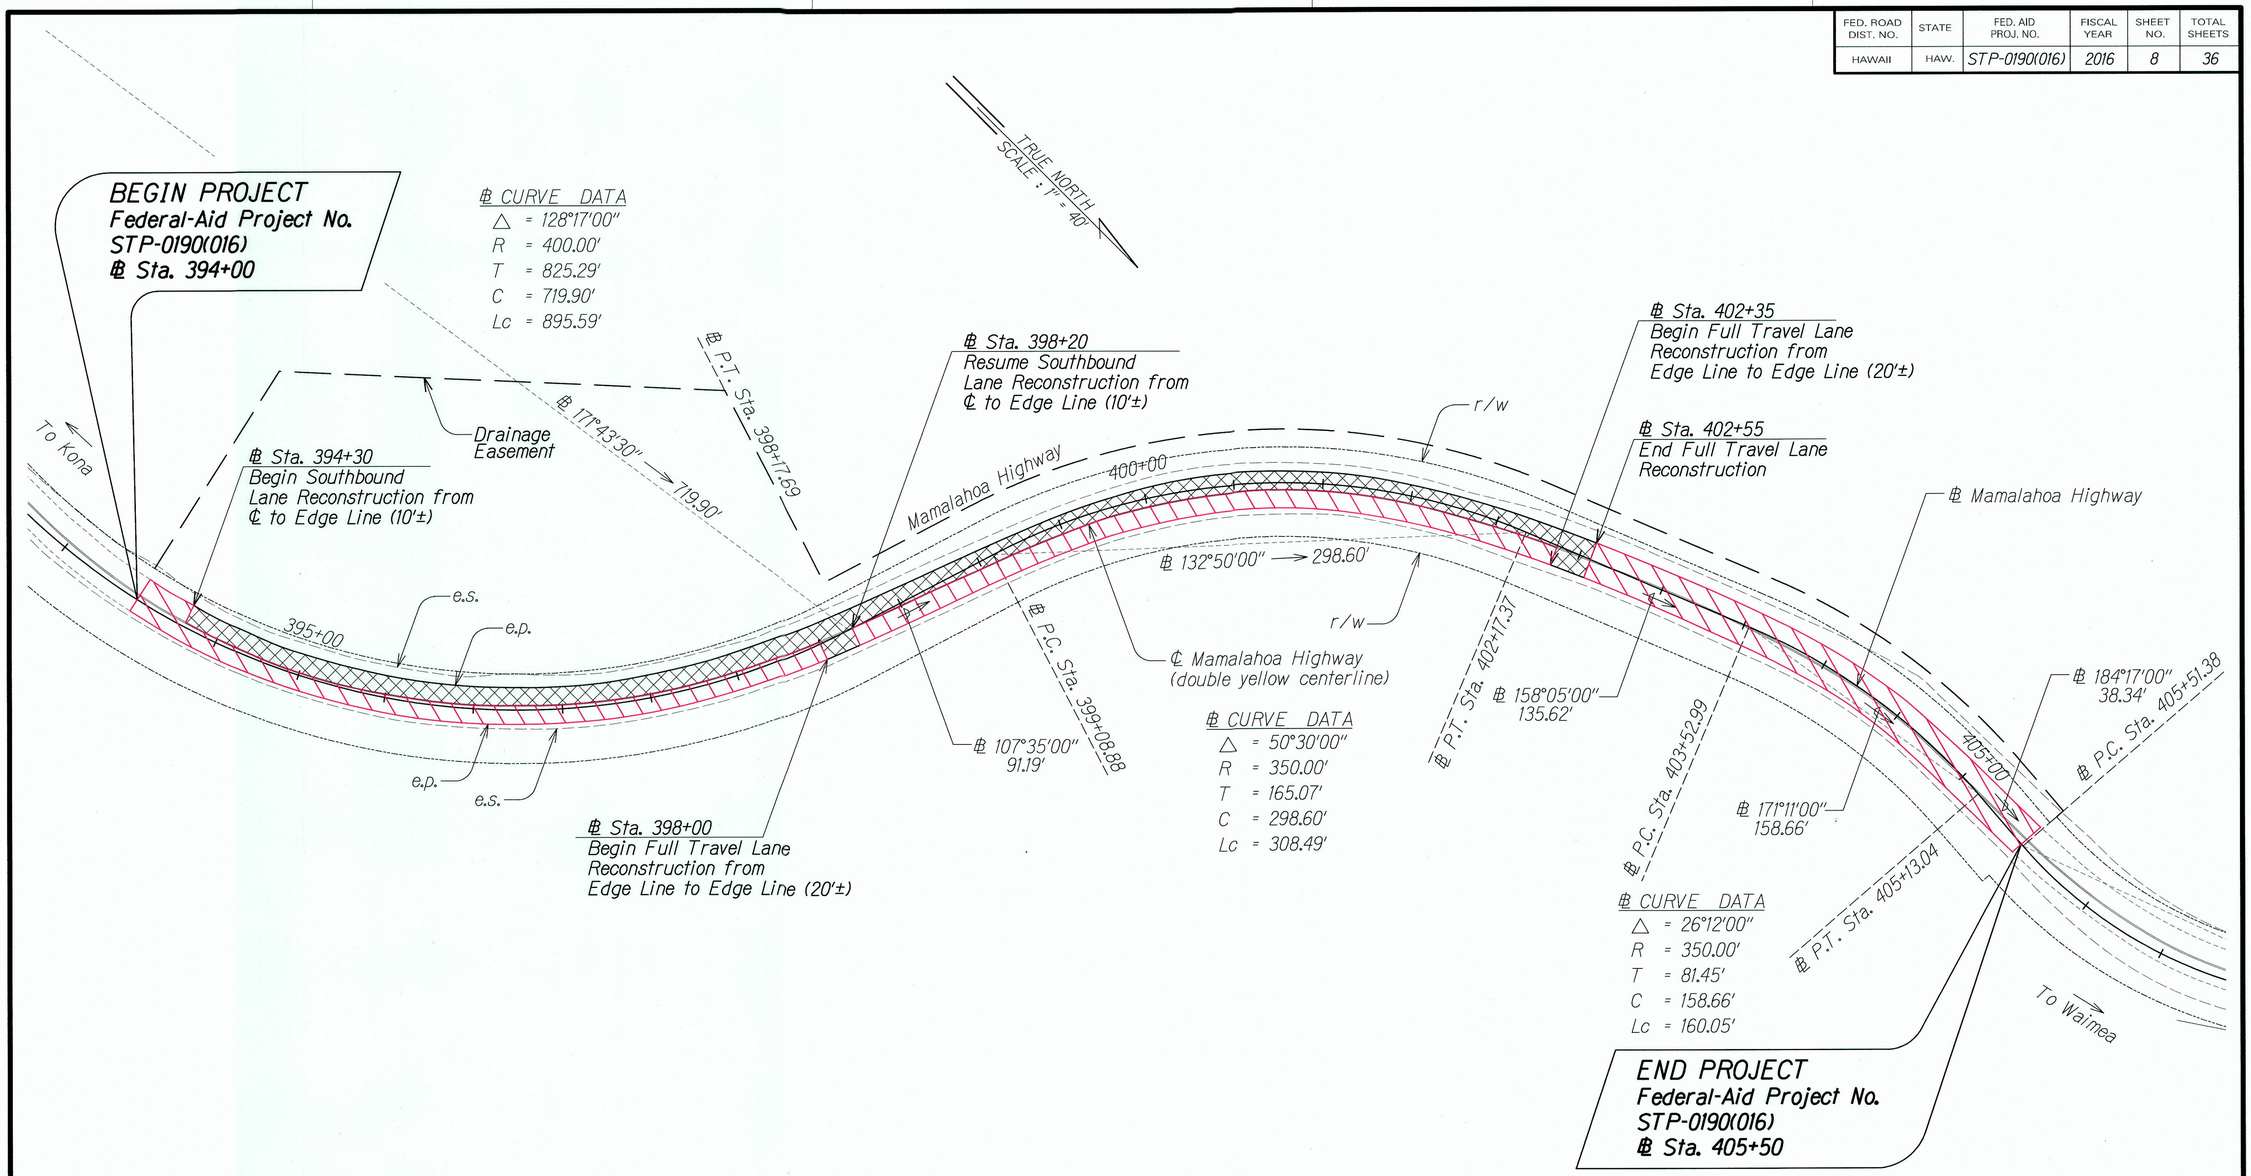

LEGEND

Reconstruction (Cold-Planing & Repaving) Areas See Detail 2/8|15

Additional Reconstruction (Cold-Planing 2" & Repave HMA Mix IV) Areas

LEGEND FOR AS-BUILT POSTINGS

∧∧∧∧	Squiggly line for as-built deletion
~~100.00~~	Double line for as-built deletion
Roadway	Text for as-built posting

Note:

1. The Mamalahoa baseline (℄) is not equivalent to the double yellow centerline (℄) striping.

LENNIE OKANO-KENDRICK
Licensed Professional Engineer
No. 11108-C
HAWAII, U.S.A.

This work was prepared by me or under my supervision.

Lennie Okano-Kendrick

Expiration Date of License 4/18

STATE OF HAWAII
DEPARTMENT OF TRANSPORTATION
HIGHWAYS DIVISION

RECONSTRUCTION ROADWAY PLAN

MAMALAHOA HIGHWAY
DRAINAGE IMPROVEMENTS
Vicinity of Puuwaawaa Ranch Road
Federal-Aid Project No. STP-0190(016)

Scale: 1"=40' Date: April 2016

SHEET No. 1 OF 1 SHEETS

"AS-BUILT"