FED. ROAD DIST. NO.	STATE	FED. AID PROJ. NO.	FISCAL YEAR	SHEET NO.	TOTAL SHEETS
HAWAII	HAW.	STP-0190(019)	2022	1	15

INDEX TO DRAWINGS

SHEET NO.	DESCRIPTION
1	TITLE SHEET
2	STANDARD PLANS SUMMARY
3 – 4	GENERAL NOTES
5 – 7	WATER POLLUTION AND EROSION CONTROL NOTES
8	TYPICAL SECTION
9 – 15	ROADWAY PLANS

STATE OF HAWAII
DEPARTMENT OF TRANSPORTATION
HIGHWAYS DIVISION

HONOLULU, HAWAII

"AS-BUILT"
PLANS FOR

MAMALAHOA HIGHWAY RESURFACING
MILE POST 9.74 TO MILE POST 12.28
FEDERAL-AID PROJECT NO. STP-0190(019)

DISTRICT OF SOUTH KOHALA
ISLAND OF HAWAII

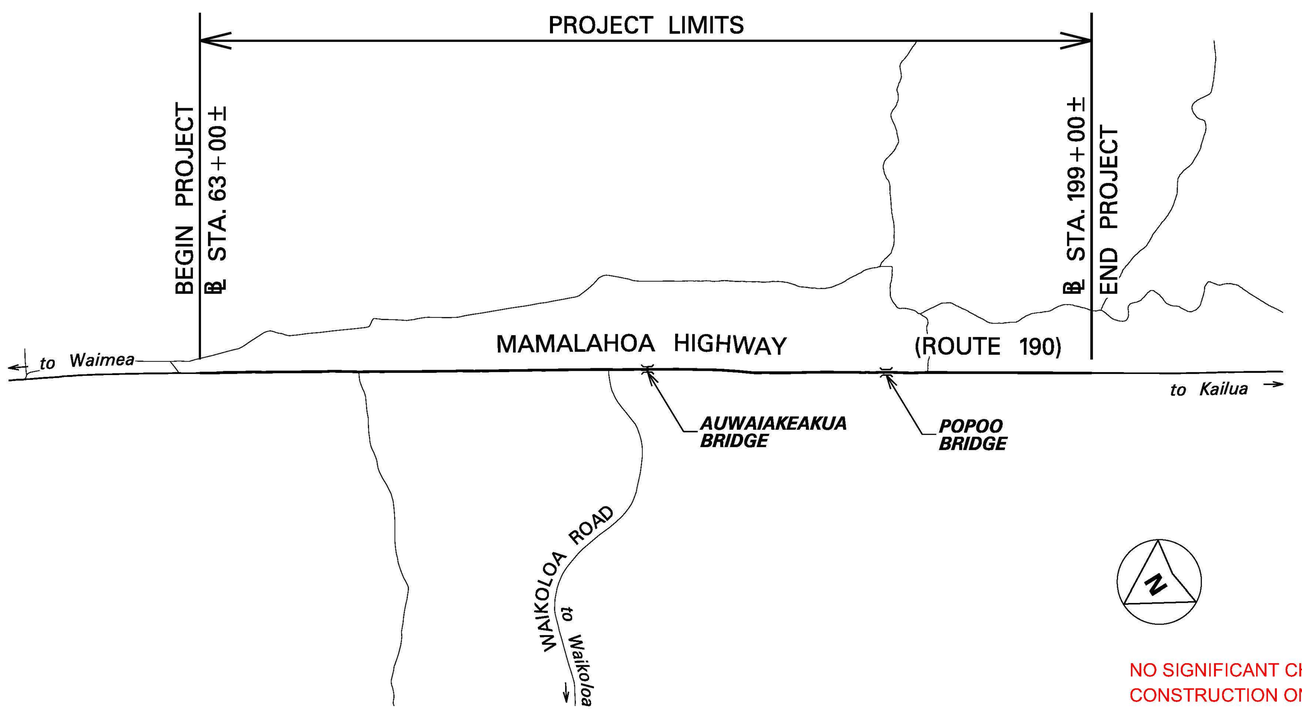

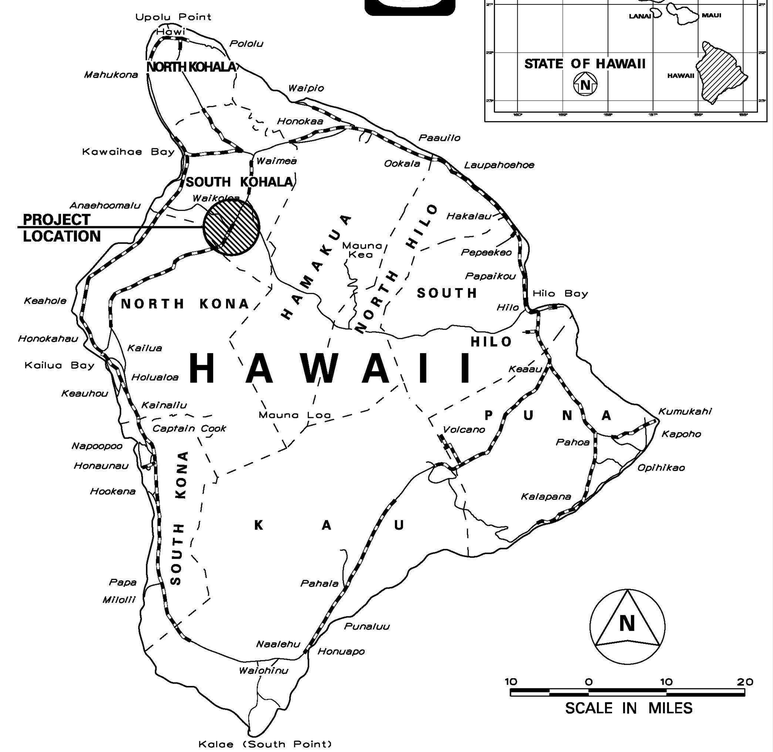

FEDERAL AID PROJECTS PREVIOUSLY CONSTRUCTED OR UNDER CONSTRUCTION

MILE POST 9.74 TO MILE POST 12.28

DESIGN DESIGNATION

ADT (2021) 6,900
ADT (2031) 8,100
DHV 730
D 55/45
T 6.0
T_{24} 7.5
V ..... 60 M.P.H.

NO SIGNIFICANT CHANGES WERE MADE DURING CONSTRUCTION ON THESE PLANS EXCEPT CHANGES IN THE ORIGINAL THEORETICAL QUANTITIES. FOR ACTUAL QUANTITIES, REFER TO PROJECT LEDGER AND/OR COMPUTATION BOOK.

RESIDENT ENGINEER — DATE 4/26/2023

DEPARTMENT OF TRANSPORTATION STATE OF HAWAII	
APPROVED:	May 11, 2022
DIR. OF TRANSPORTATION	DATE

6 0 6 12 18
SCALE IN THOUSAND FEET

LAYOUT PLAN

LENGTH OF PROJECT..... 2.54 MILES

HWY-D	HWY-DD	692-7570	MAY, 2022
DESIGNED BY	MANAGED BY	PHONE	DATE