


STATE	PROJECT	SHEET NO.	TOTAL SHEETS
HI	HI A-AD 6(6)	A4	A18

TMK: 4-4-15:004

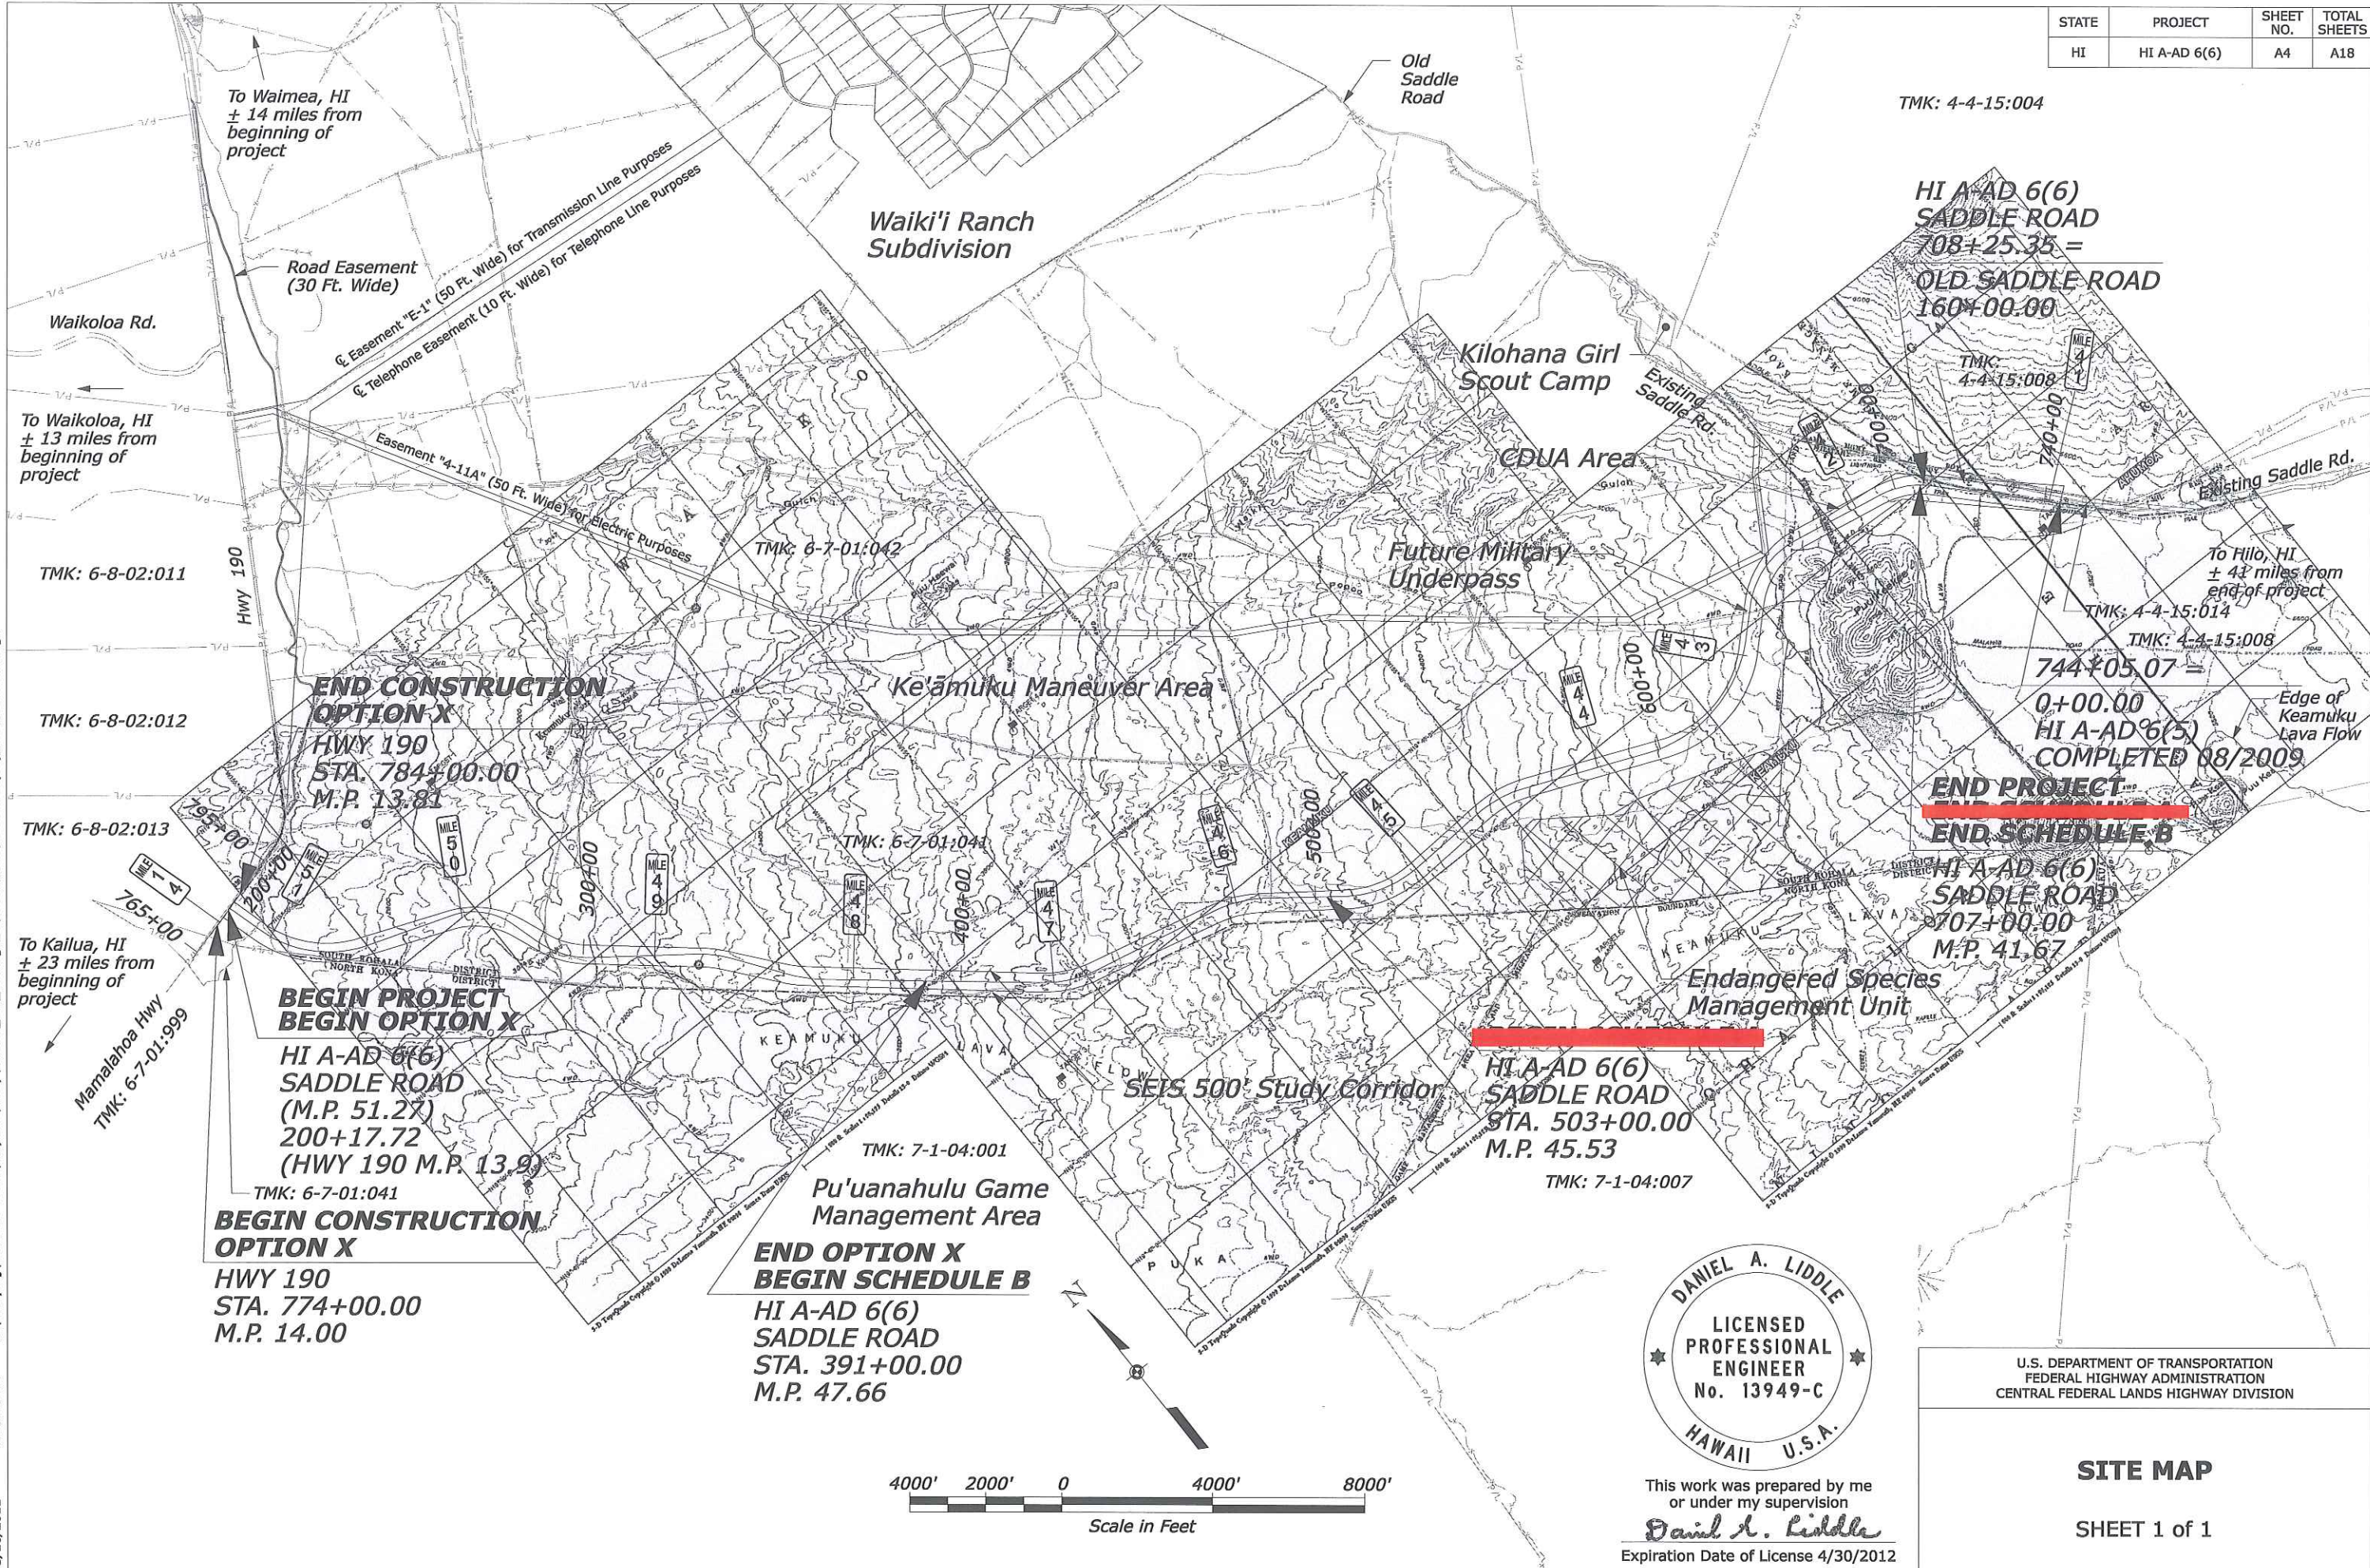

**END CONSTRUCTION
OPTION X**
HWY 190
STA. 784+00.00
M.P. 13.81

**BEGIN PROJECT
BEGIN OPTION X**
HI A-AD 6(6)
SADDLE ROAD
(M.P. 51.27)
200+17.72
(HWY 190 M.P. 13.9)

**BEGIN CONSTRUCTION
OPTION X**
HWY 190
STA. 774+00.00
M.P. 14.00

**END OPTION X
BEGIN SCHEDULE B**
HI A-AD 6(6)
SADDLE ROAD
STA. 391+00.00
M.P. 47.66

HI A-AD 6(6)
SADDLE ROAD
708+25.35 =
OLD SADDLE ROAD
160+00.00

**END PROJECT
END SCHEDULE B**

HI A-AD 6(6)
SADDLE ROAD
707+00.00
M.P. 41.67

HI A-AD 6(6)
SADDLE ROAD
STA. 503+00.00
M.P. 45.53



This work was prepared by me
or under my supervision
Daniel A. Liddle
Expiration Date of License 4/30/2012

U.S. DEPARTMENT OF TRANSPORTATION
FEDERAL HIGHWAY ADMINISTRATION
CENTRAL FEDERAL LANDS HIGHWAY DIVISION

SITE MAP

SHEET 1 of 1

S:\Tranpro\100013746-SR\HwyDes\Draws\Sheets_Bld_Package_1\A-Gen_Sht\HI SR 200(00)_PLA_SITE MAP.dgn
1:28:46 PM
5/16/2011