FED. ROAD DIST. NO.	STATE	PROJ. NO.	FISCAL YEAR	SHEET NO.	TOTAL SHEETS
HAWAII	HAW.	240A-01-78	1978	1	8

INDEX TO DRAWINGS

SHEET NO.	DESCRIPTION
1	TITLE SHEET
2-3	LOCATION NO. 1
4-5	LOCATION NO. 2
6	LOCATION NO. 3
7-8	TYPICAL & ST'D. DETAILS

STATE OF HAWAII

DEPARTMENT OF TRANSPORTATION

LAND TRANSPORTATION FACILITIES DIVISION

"AS-BUILT"

PLANS FOR

MAMANE STREET SLOPE IMPROVEMENT

PROJECT NO. 240A-01-78

DISTRICT OF HAMAKUA
ISLAND OF HAWAII

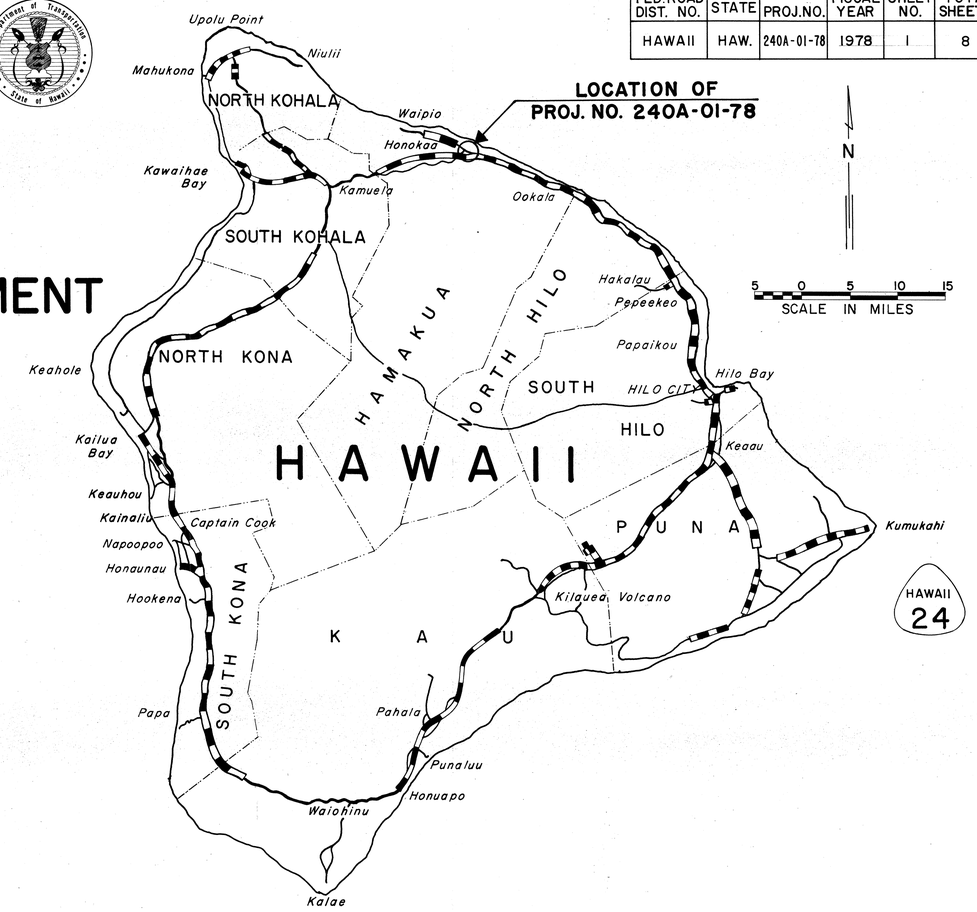

Federal Aid Projects Previously Constructed Or Under Construction

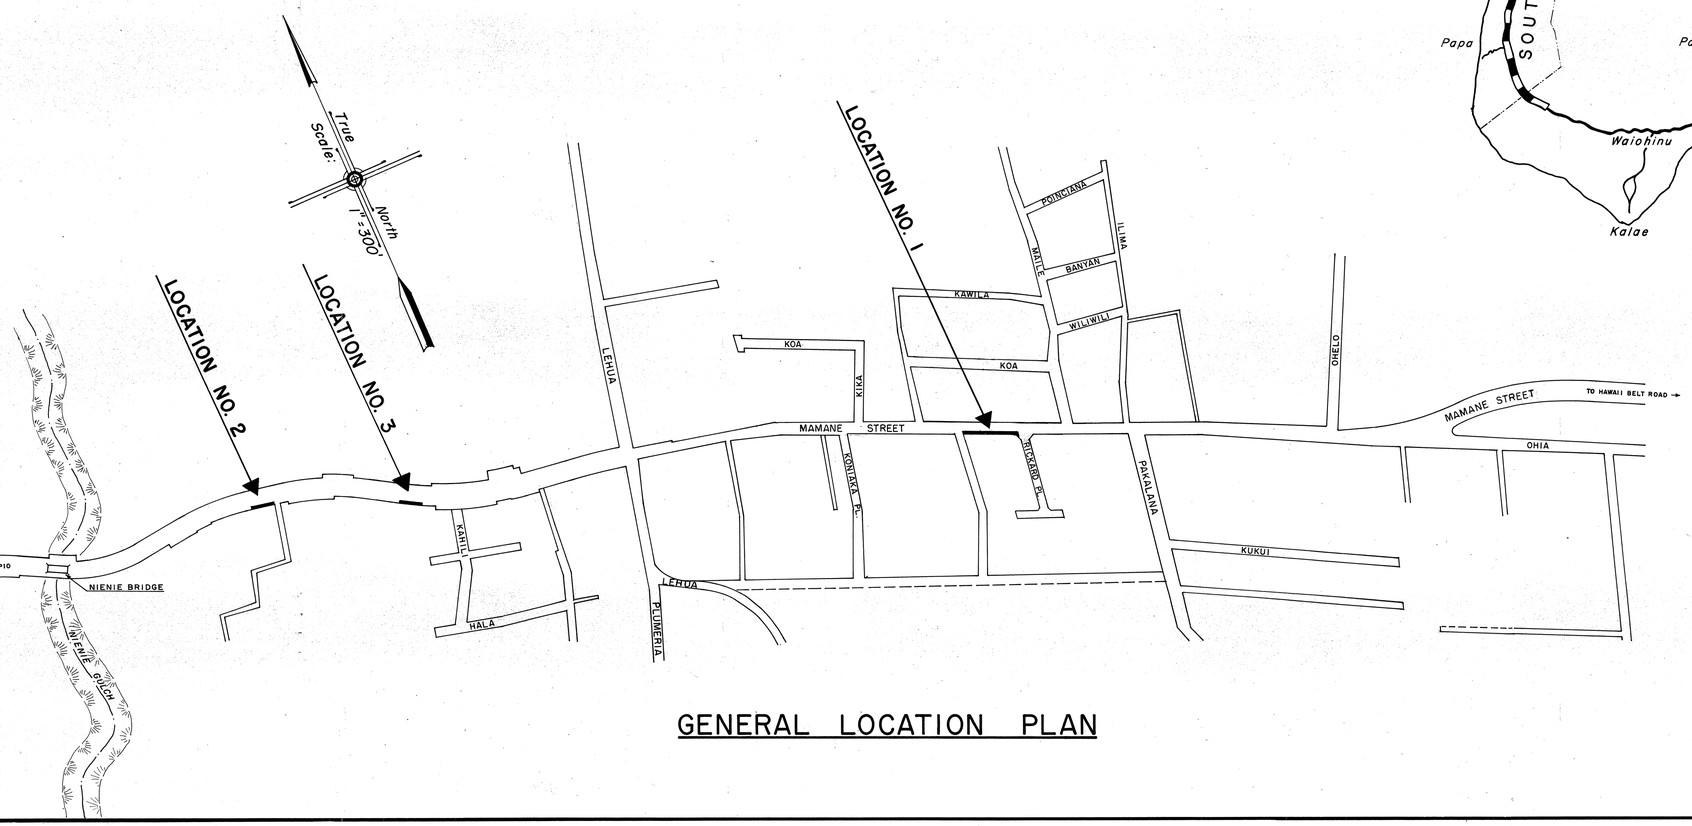

GENERAL LOCATION PLAN

ALL CHANGES MADE DURING CONSTRUCTION HAVE BEEN NOTED IN RED ON THESE TRACINGS AND CHECKED BY

Jango Fujimoto — RESIDENT ENGINEER — 4-30-79 DATE

HAWAII DISTRICT	R. TSUZUKI	548-2456	MAY, 1978
DESIGNED BY	P. S. & E. BY	PHONE	DATE

DEPARTMENT OF TRANSPORTATION
STATE OF HAWAII
APPROVED:
Ryokichi Higashionna 9/22/78
DIR. OF TRANSPORTATION — DATE