FED. ROAD DIST. NO.	STATE	FED. AID PROJ. NO.	FISCAL YEAR	SHEET NO.	TOTAL SHEETS
HAWAII	HAW.	S 239(1)	1954	1	19

INDEX TO DRAWINGS

SHEET	DESCRIPTION
1	TITLE SHEET
2	TYPICAL SECTION
3-6	PLAN AND PROFILE
7-11	STANDARD DETAILS
12-19	CROSS SECTIONS

TERRITORY OF HAWAII

TERRITORIAL HIGHWAY DEPARTMENT

HONOLULU T.H.

PLANS OF

KOHALA MOUNTAIN ROAD

FEDERAL AID SECONDARY PROJECT NO. S 239 (1)

DISTRICTS OF NORTH & SOUTH KOHALA

ISLAND OF HAWAII

SCALES

PLAN		1 INCH = 100 FT.
PROFILE	HOR.	1 INCH = 100 FT.
	VER.	1 INCH = 10 FT.
CROSS SECTION	HOR.	1 INCH = 10 FT.
	VER.	1 INCH = 10 FT.

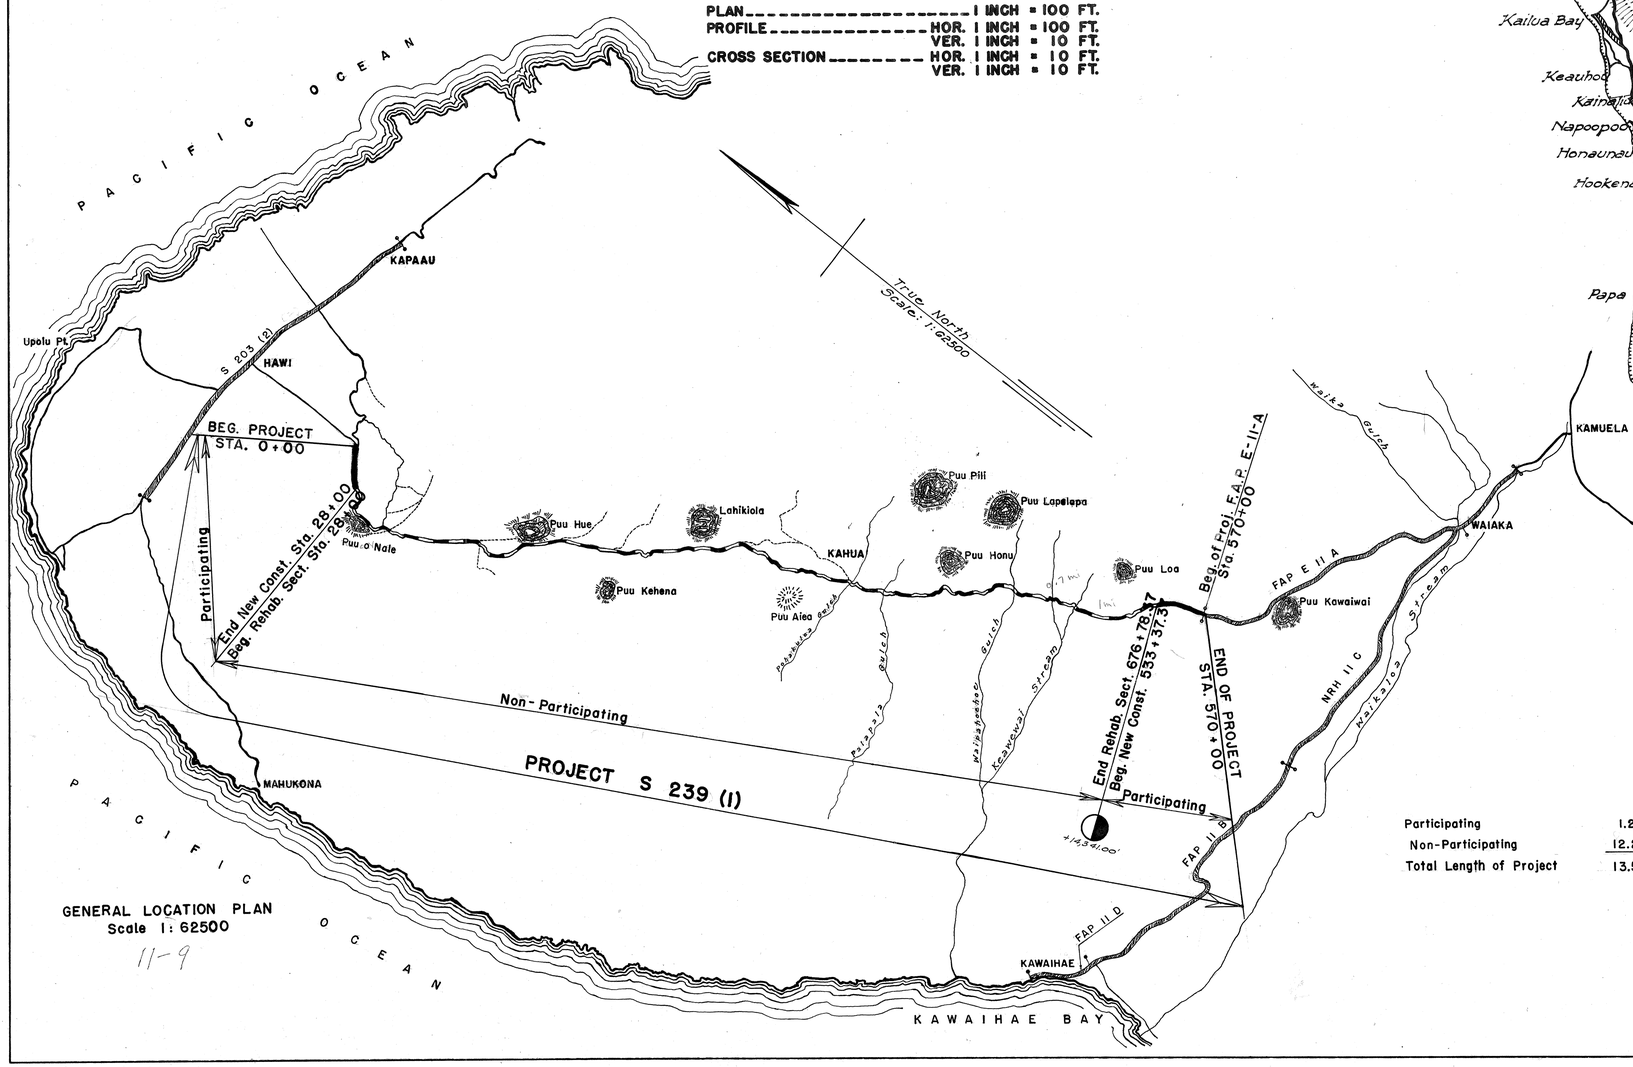

GENERAL LOCATION PLAN
Scale 1: 62500

11-9

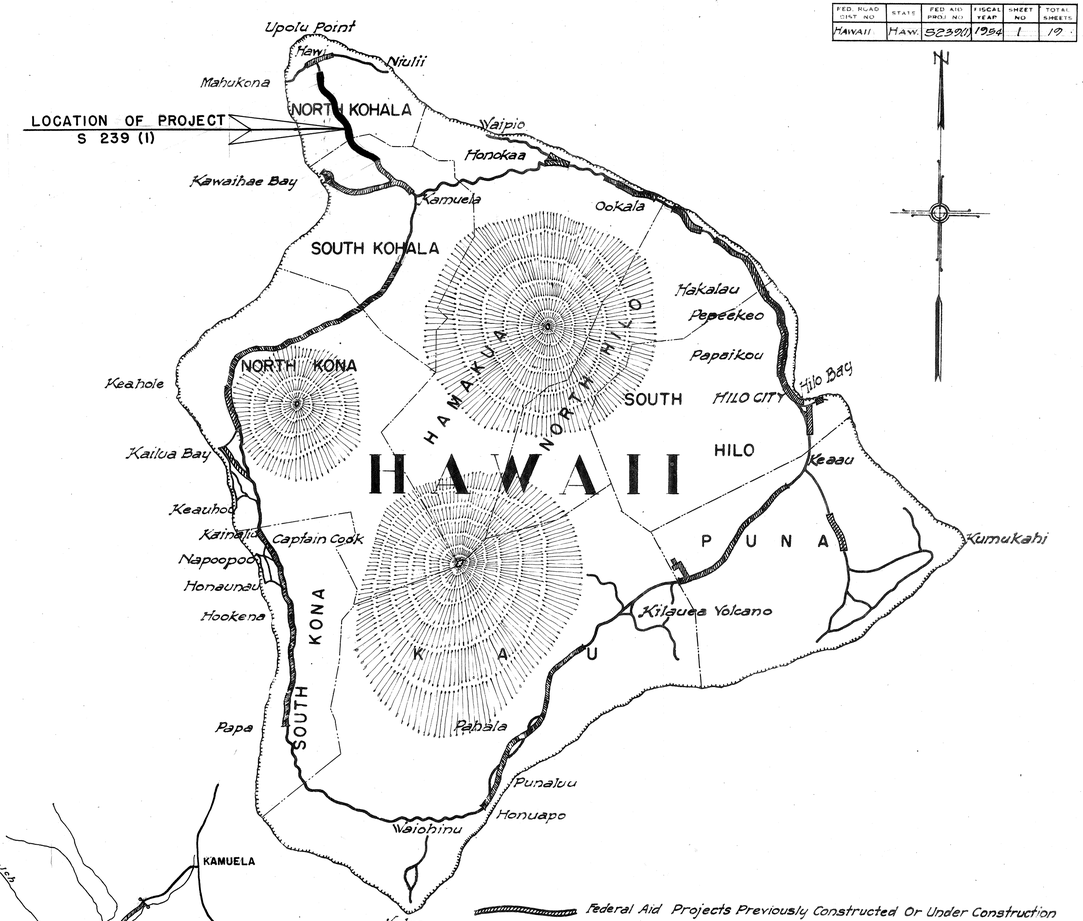

NOTE:

ALL CHANGES MADE DURING CONSTRUCTION HAVE BEEN NOTED IN RED ON THESE TRACINGS AND CHECKED BY:

PROJECT ENGINEER

10/30/56
DATE

Participating	1.224 Mile
Non-Participating	12.288 Miles
Total Length of Project	13.512 Miles

APPROVED: DATE 10/13/1954

TERRITORIAL HIGHWAY ENGINEER

DEPARTMENT OF COMMERCE
BUREAU OF PUBLIC ROADS
APPROVED:

DISTRICT ENGINEER DATE

ORIGINAL PLAN	SURVEY PLOTTED BY	DATE
	DESIGNED BY	"
	DRAWN BY	"
	TRACED BY	"
NOTE BOOK	QUANTITIES BY	"
	QUANTITIES CHECKED BY	"
No.	CHECKED BY	"

572S.1