FED. ROAD DIST. NO.	STATE	PROJ. NO.	FISCAL YEAR	SHEET NO.	TOTAL SHEETS
HAWAII	HAW.	250A-01-86M	1986	1	10

INDEX TO DRAWINGS

SHEET NO.	DESCRIPTION
1	TITLE SHEET
2	TYPICAL SECTIONS, DETAILS AND GENERAL NOTES
3-4	PLAN
5-6	PAVEMENT MARKERS, STRIPING AND TRAFFIC SIGNS
7	PAVEMENT STRIPING, MARKINGS AND RECONSTRUCTION SUMMARY
8-10	STANDARD DETAILS

STATE OF HAWAII

DEPARTMENT OF TRANSPORTATION

HIGHWAYS DIVISION

"AS-BUILT"

PLANS FOR CONSTRUCTION OF

KOHALA MT. ROAD RTE. 250 RESURFACING

Kahua Ranch Towards Hawi

PROJECT NO. 250A-01-86M

DISTRICT OF NORTH KOHALA
ISLAND OF HAWAII

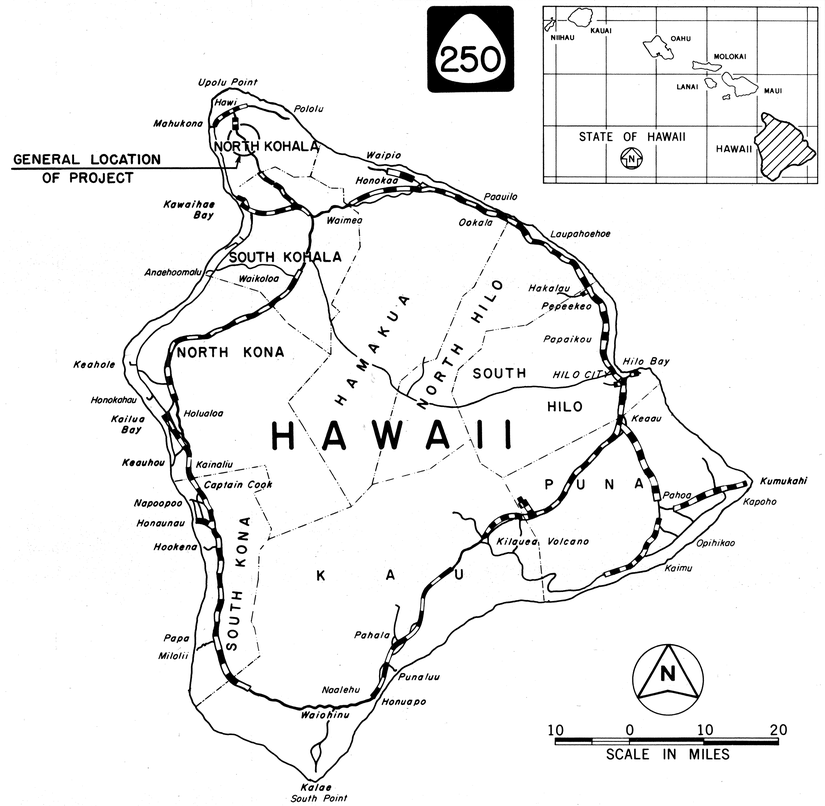

FEDERAL AID PROJECTS PREVIOUSLY CONSTRUCTED OR UNDER CONSTRUCTION

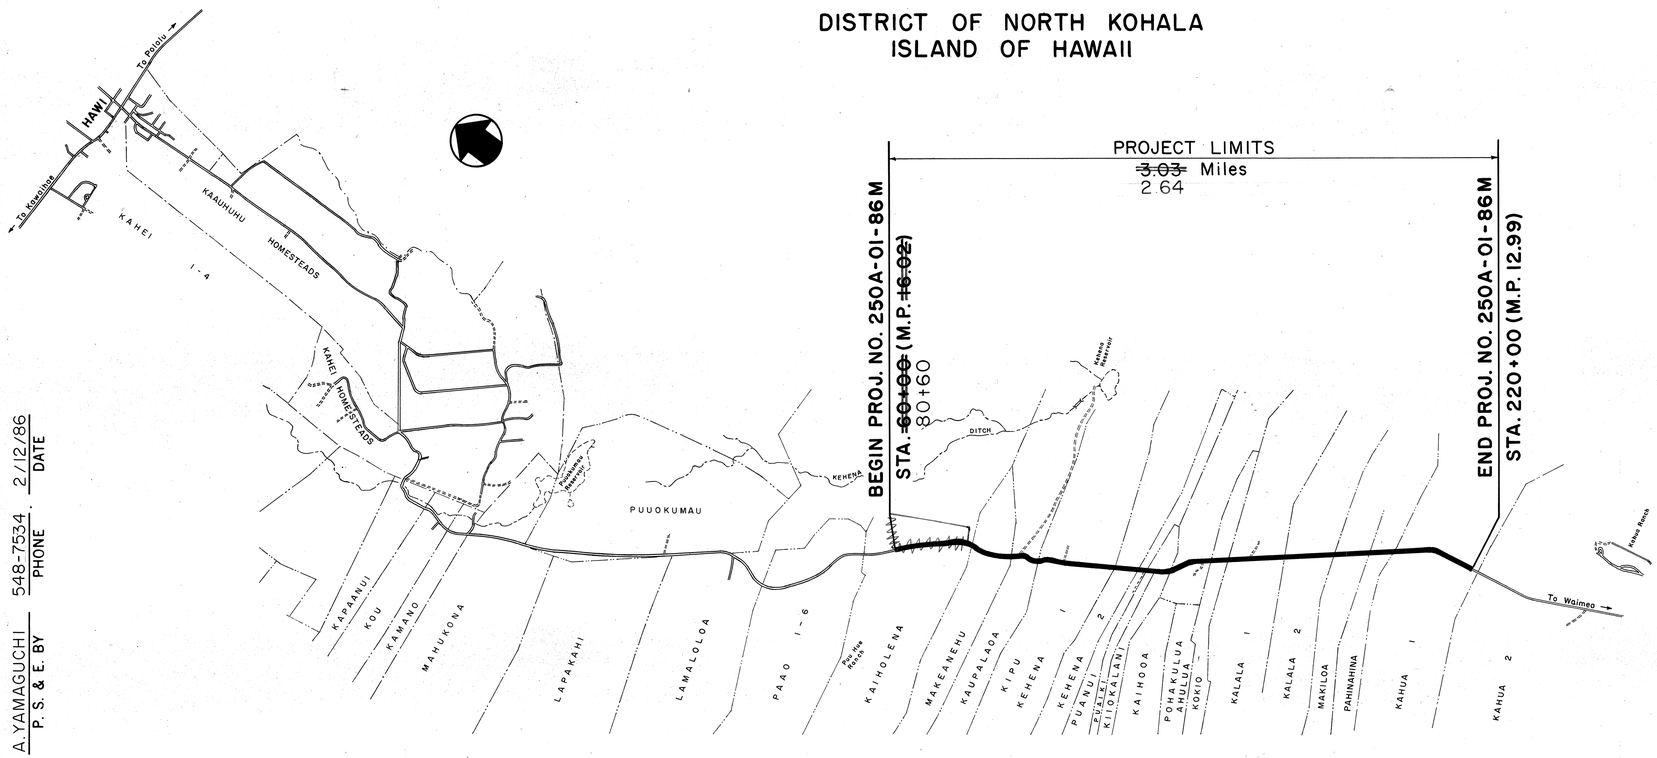

LAYOUT OF PROJECT

SCALE 1:24,000

NO SIGNIFICANT CHANGES WERE MADE DURING CONSTRUCTION ON THESE PLANS EXCEPT CHANGES IN THE ORIGINAL THEORETICAL QUANTITIES. FOR ACTUAL QUANTITIES, REFER TO PROJECT LEDGER AND/OR COMPUTATION BOOK.

Denge Kirdani 9/14/92
for RESIDENT ENGINEER DATE

HAWAII DISTRICT
DESIGNED BY

A. YAMAGUCHI
P. S. & E. BY

548-7534
PHONE

2/12/86
DATE

DEPARTMENT OF TRANSPORTATION
STATE OF HAWAII

APPROVED:

Charles D. Ross 3/4/86
DIR. OF TRANSPORTATION DATE