FED. ROAD DIST. NO.	STATE	PROJ. NO.	FISCAL YEAR	SHEET NO.	TOTAL SHEETS
HAWAII	HAW.	250A-01-89M	1989	1	7

INDEX TO DRAWINGS

SHEET NO.	DESCRIPTION
1	TITLE SHEET
2	STANDARD PLANS SUMMARY
3	TYPICAL SECTIONS & DETAILS
4-6	ROADWAY STRIPING PLAN
7	MISC. ROADWAY DETAILS

STATE OF HAWAII

DEPARTMENT OF TRANSPORTATION

HIGHWAYS DIVISION

HONOLULU, HAWAII

"AS-BUILT"

PLANS FOR

KOHALA MOUNTAIN ROAD RESURFACING

PUUHUE RANCH TO HAWI HILL ROAD

PROJECT NO. 250A-01-89M

DISTRICT OF NORTH KOHALA

ISLAND OF HAWAII

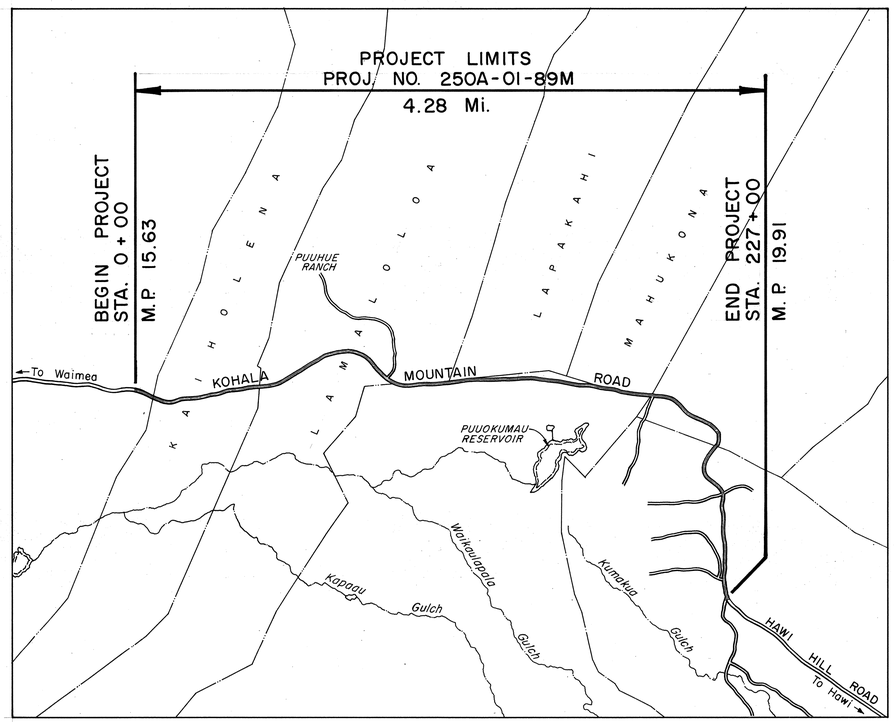

LAYOUT OF PROJECT

2000 0 2000 4000 6000

SCALE IN FEET

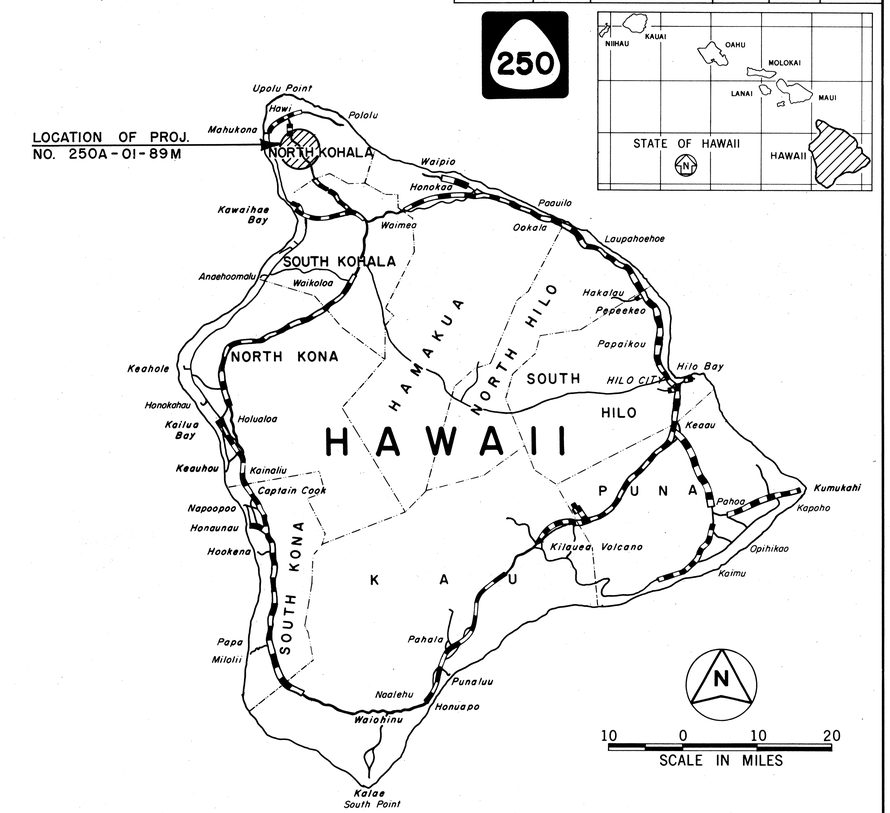

FEDERAL AID PROJECTS PREVIOUSLY CONSTRUCTED OR UNDER CONSTRUCTION

CHANGES MADE DURING CONSTRUCTION HAVE BEEN INCORPORATED ON THESE PLANS EXCEPT CHANGES IN THE ORIGINAL THEORETICAL QUANTITIES. FOR ACTUAL QUANTITIES, REFER TO PROJECT LEDGER AND/OR COMPUTATION BOOK.

Robert G. W. Lee Jr. — RESIDENT ENGINEER — 6/5/90 DATE

HAWAII DISTRICT	ALVIN TAKESHITA	548-7537	NOV. 1988
DESIGNED BY	P. S. & E. BY	PHONE	DATE

DEPARTMENT OF TRANSPORTATION
STATE OF HAWAII

APPROVED:

Edward Sato — DIR. OF TRANSPORTATION — 12/20/88 DATE