FED. ROAD DIST. NO.	STATE	PROJ. NO.	FISCAL YEAR	SHEET NO.	TOTAL SHEETS
HAWAII	HAW.	250A-01-02M	2002	4	34

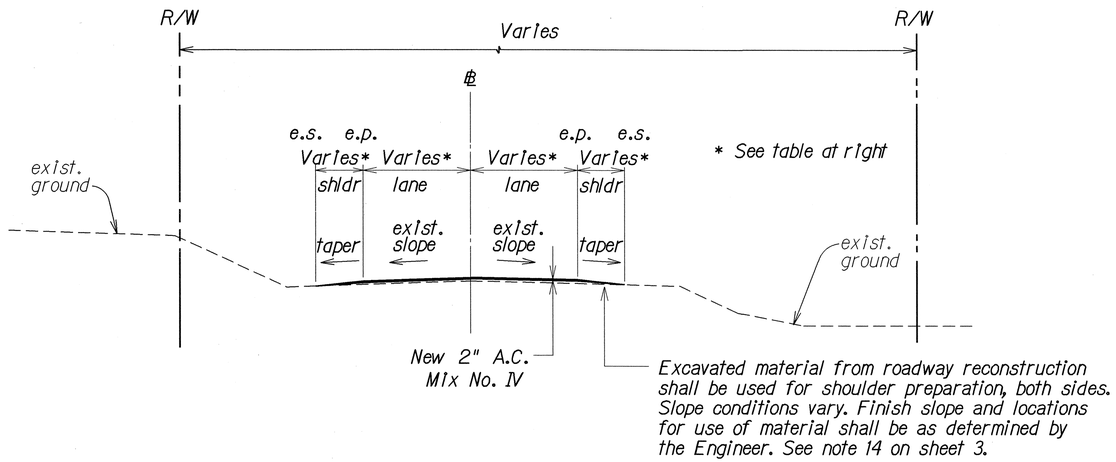

RESURFACING TYPICAL SECTION

Not To Scale

TABLE - TYPICAL LANE AND SHOULDER WIDTHS **		
LOCATION	LANE	SHOULDER
Segment A, Sta. 121+50 to Sta. 118+50	11 ft.	1 ft.
Segment A, Sta. 118+50 to Sta. 0+00	11 ~~10~~ ft.	1 ~~2~~ ft.
Segment B, Sta. 0+00 to Sta. 220+00	11 ~~10~~ ft.	1 ~~2~~ ft.

** See Sheet 5 for reconstructed lane and shoulder widths.

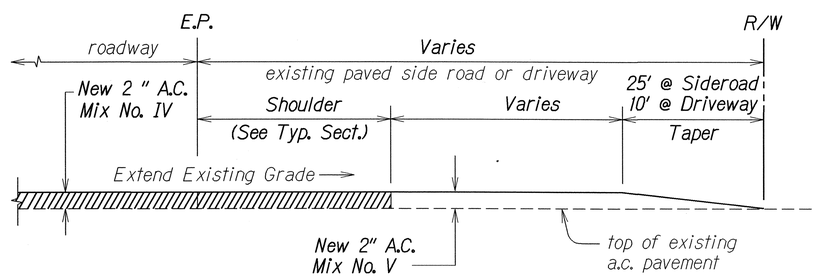

A. C. RESURFACING AT PAVED SIDEROAD OR PAVED DRIVEWAY DETAIL

Not To Scale

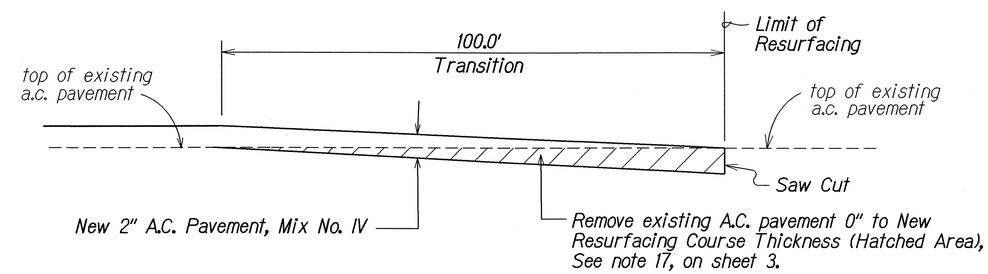

COLD PLANED TRANSITION TO EXISTING A.C. PAVEMENT @ PROJECT LIMITS

Not To Scale

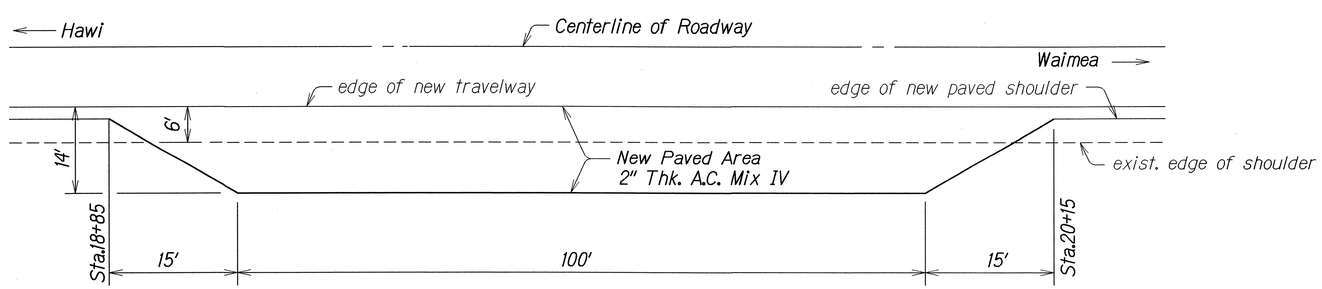

DETAILED PLAN FOR NEW LOOKOUT

Not To Scale

ORIGINAL PLAN	SURVEY PLOTTED BY	DATE
	DRAWN BY X	
	TRACED BY X	
NOTE BOOK 2002-01 2/01/2002	DESIGNED BY X	
	QUANTITIES BY	
No.	CHECKED BY	

LEGEND FOR AS-BUILT POSTINGS	
~~	Squiggly line for as-built deletion
~~100.00~~	Double line for as-built deletion
Roadway	Text for as-built posting

STATE OF HAWAII
DEPARTMENT OF TRANSPORTATION
HIGHWAYS DIVISION

TYPICAL SECTION & DETAILS

KOHALA MOUNTAIN ROAD RESURFACING
IKI ROAD TO KAHUA
PROJECT NO. 250A-01-02M

Scale: As Shown Date: March, 2002

SHEET No. 1 OF 1 SHEETS

"AS-BUILT"

FED-Highway Design Section