FED. ROAD DIST. NO.	STATE	FED. AID PROJ. NO.	FISCAL YEAR	SHEET NO.	TOTAL SHEETS
HAWAII	HAW.	STP-250(006)	2011	1	20

INDEX TO DRAWINGS

SHEET NO.	DESCRIPTION
1	TITLE SHEET
2	STANDARD PLANS SUMMARY
3	GENERAL NOTES AND LEGEND
4–5	WATER POLLUTION AND EROSION CONTROL NOTES
6	TYPICAL SECTION AND DETAILS
7	TYPICAL PAVEMENT DETAILS
8–16	ROADWAY PLANS
17	PAVEMENT MARKING LEGEND AND NOTES
18	PAVEMENT MARKING AND MONUMENT SCHEDULE
19	PAVEMENT REPAIR AREA AND UTILITY SCHEDULE
20	WORK ZONE SIGNING PLAN, NOTES AND DETAILS

STATE OF HAWAII

DEPARTMENT OF TRANSPORTATION

HIGHWAYS DIVISION

HONOLULU, HAWAII

"AS-BUILT"

PLANS FOR

KOHALA MOUNTAIN ROAD PAVEMENT PREVENTIVE MAINTENANCE

WAIAKA JUNCTION TOWARD HAWI

FEDERAL AID PROJECT NO. STP-250(006)

DISTRICT OF SOUTH KOHALA

ISLAND OF HAWAII

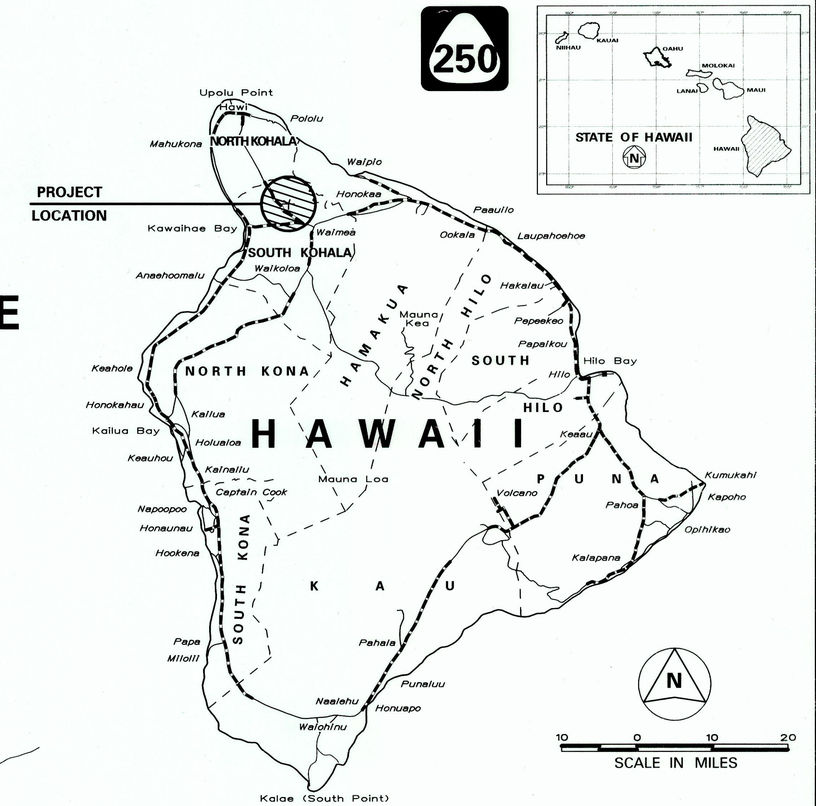

FEDERAL AID PROJECTS PREVIOUSLY CONSTRUCTED OR UNDER CONSTRUCTION

MILE POST 2.54 TO MILE POST 6.44

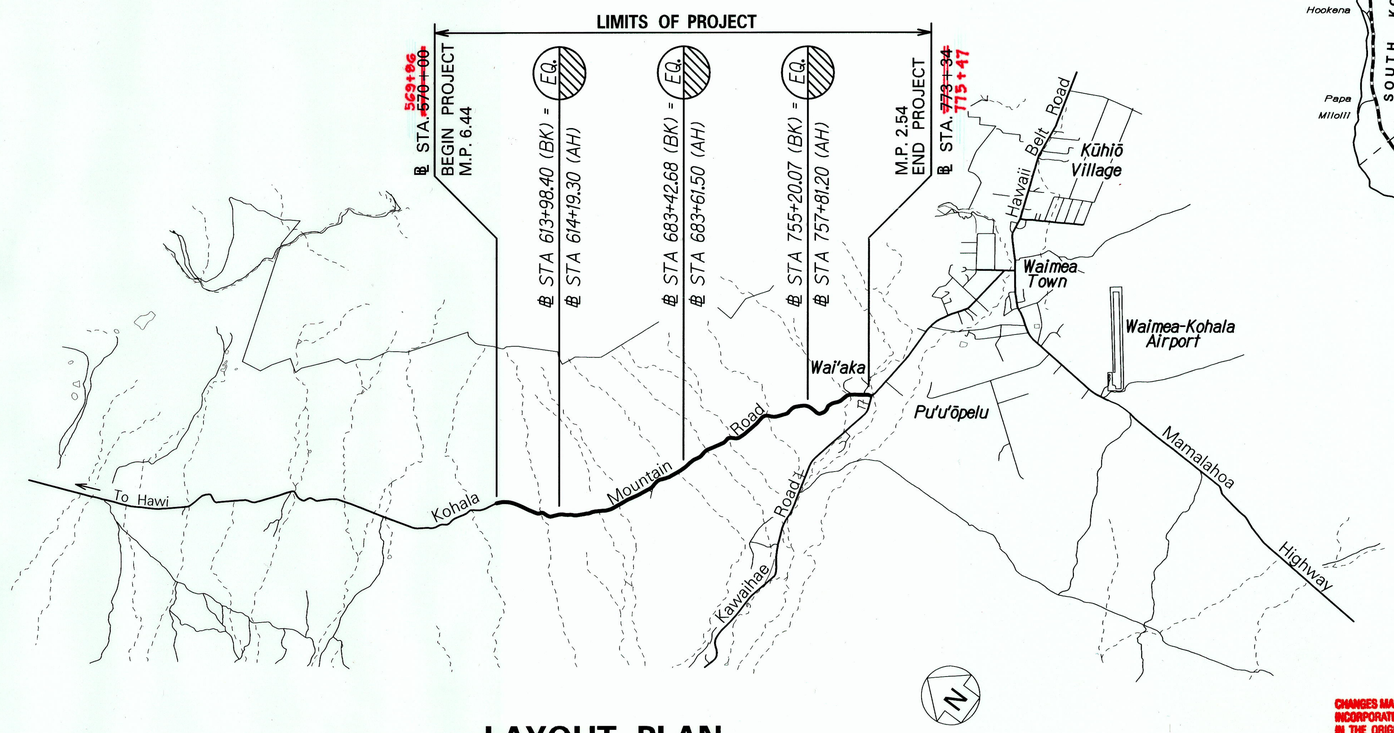

LAYOUT PLAN

GROSS LENGTH OF PROJECT..... 3.9 MILES

NET LENGTH OF PROJECT..... 3.9 MILES

4 0 4 8 12

SCALE IN THOUSAND FEET

DESIGN DESIGNATION

ADT (2011)	2,500
ADT (2021)	3,000
DHV	290
D	55/45
T	5.0%
V	40 M.P.H.

CHANGES MADE DURING CONSTRUCTION HAVE BEEN INCORPORATED ON THESE PLANS EXCEPT CHANGES IN THE ORIGINAL. THEORETICAL QUANTITIES. FOR ACTUAL QUANTITIES, REFER TO PROJECT LEDGER AND/OR COMPUTATION BOOK.

Rob Lee — RESIDENT ENGINEER — 9/22/17 DATE

DEPARTMENT OF TRANSPORTATION
STATE OF HAWAII

APPROVED:

DIR. OF TRANSPORTATION — 5/20/11 DATE

HAWAII DISTRICT — DESIGNED BY

HWY-HE — MANAGED BY

933-8866 — PHONE

APRIL, 2011 — DATE