FED. ROAD DIST. No.	STATE	FED. AID PROJ. No.	FISCAL YEAR	SHEET No.	TOTAL SHEETS
HAWAII	HAW.	S-0260(1)	1959	30	38

FINAL SURVEY — SURVEYED — PLOTTED — TEMPLATE — NOTE BOOK — AREAS CHECKED — NO. — BY — DATE

ORIGINAL SURVEY — SURVEYED S. K. ~ R. K. — PLOTTED S. K. — TEMPLATE — NOTE BOOK — AREAS CHECKED — NO. — BY — DATE 3/58 4/58

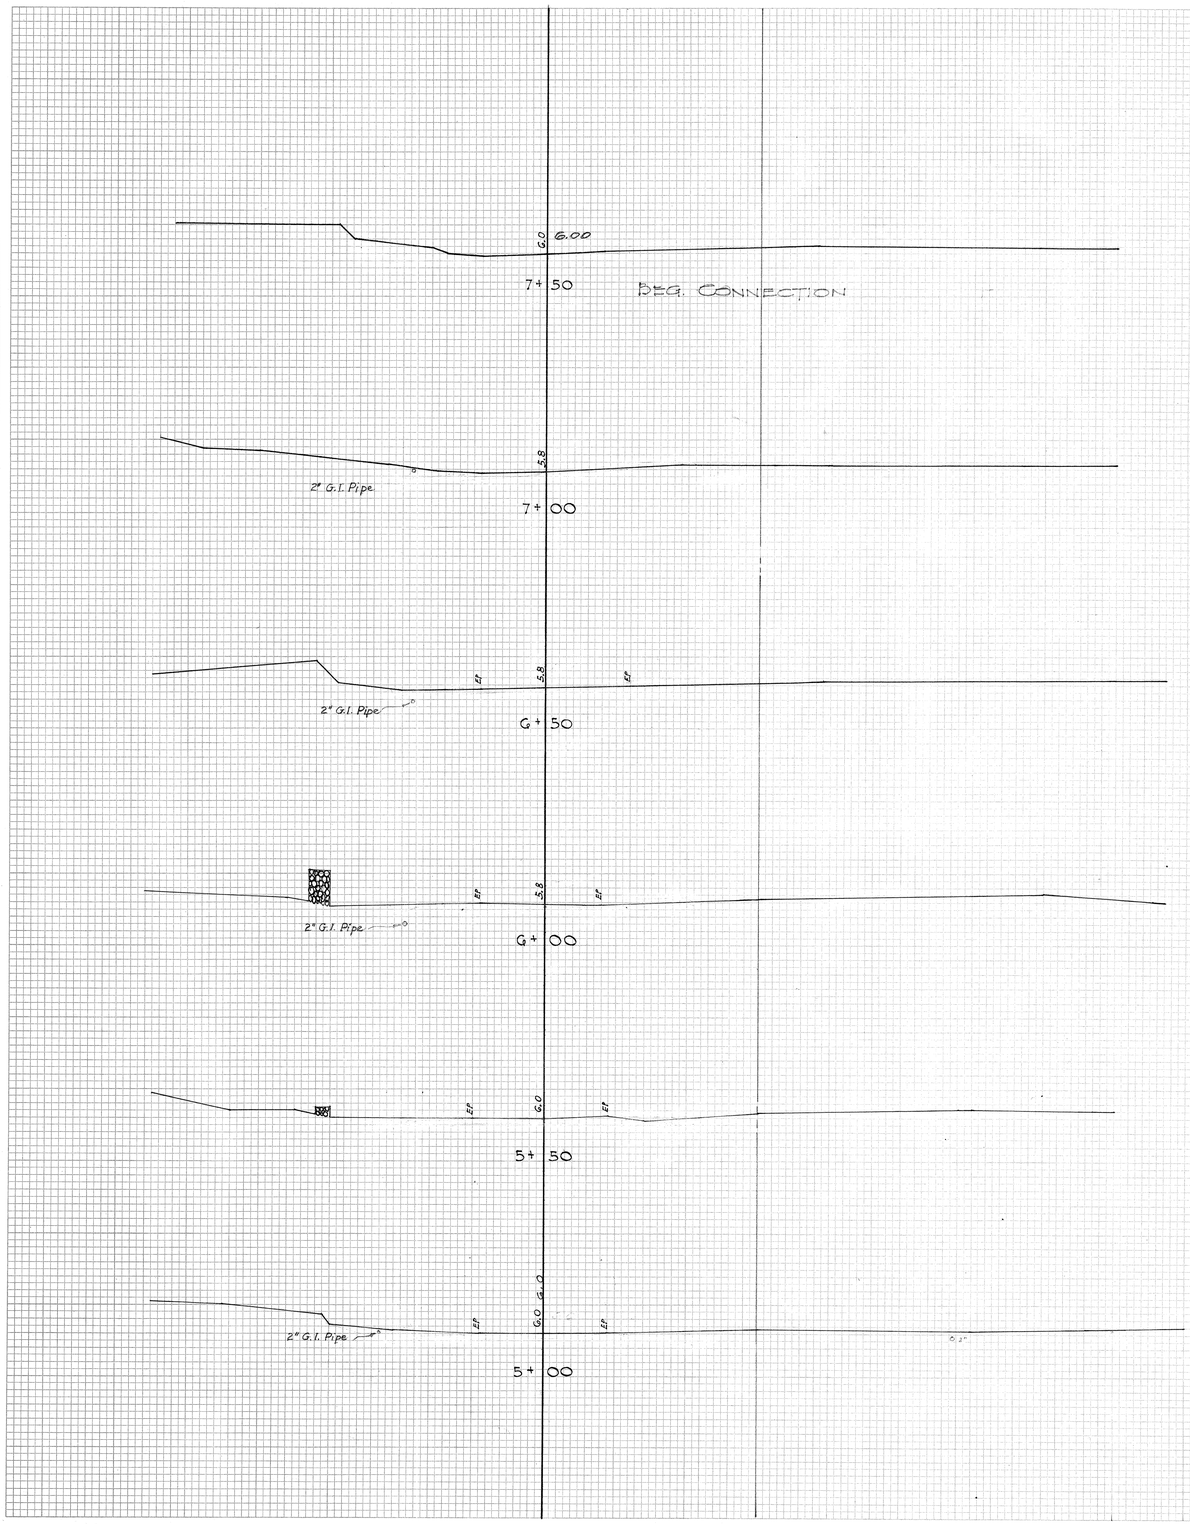

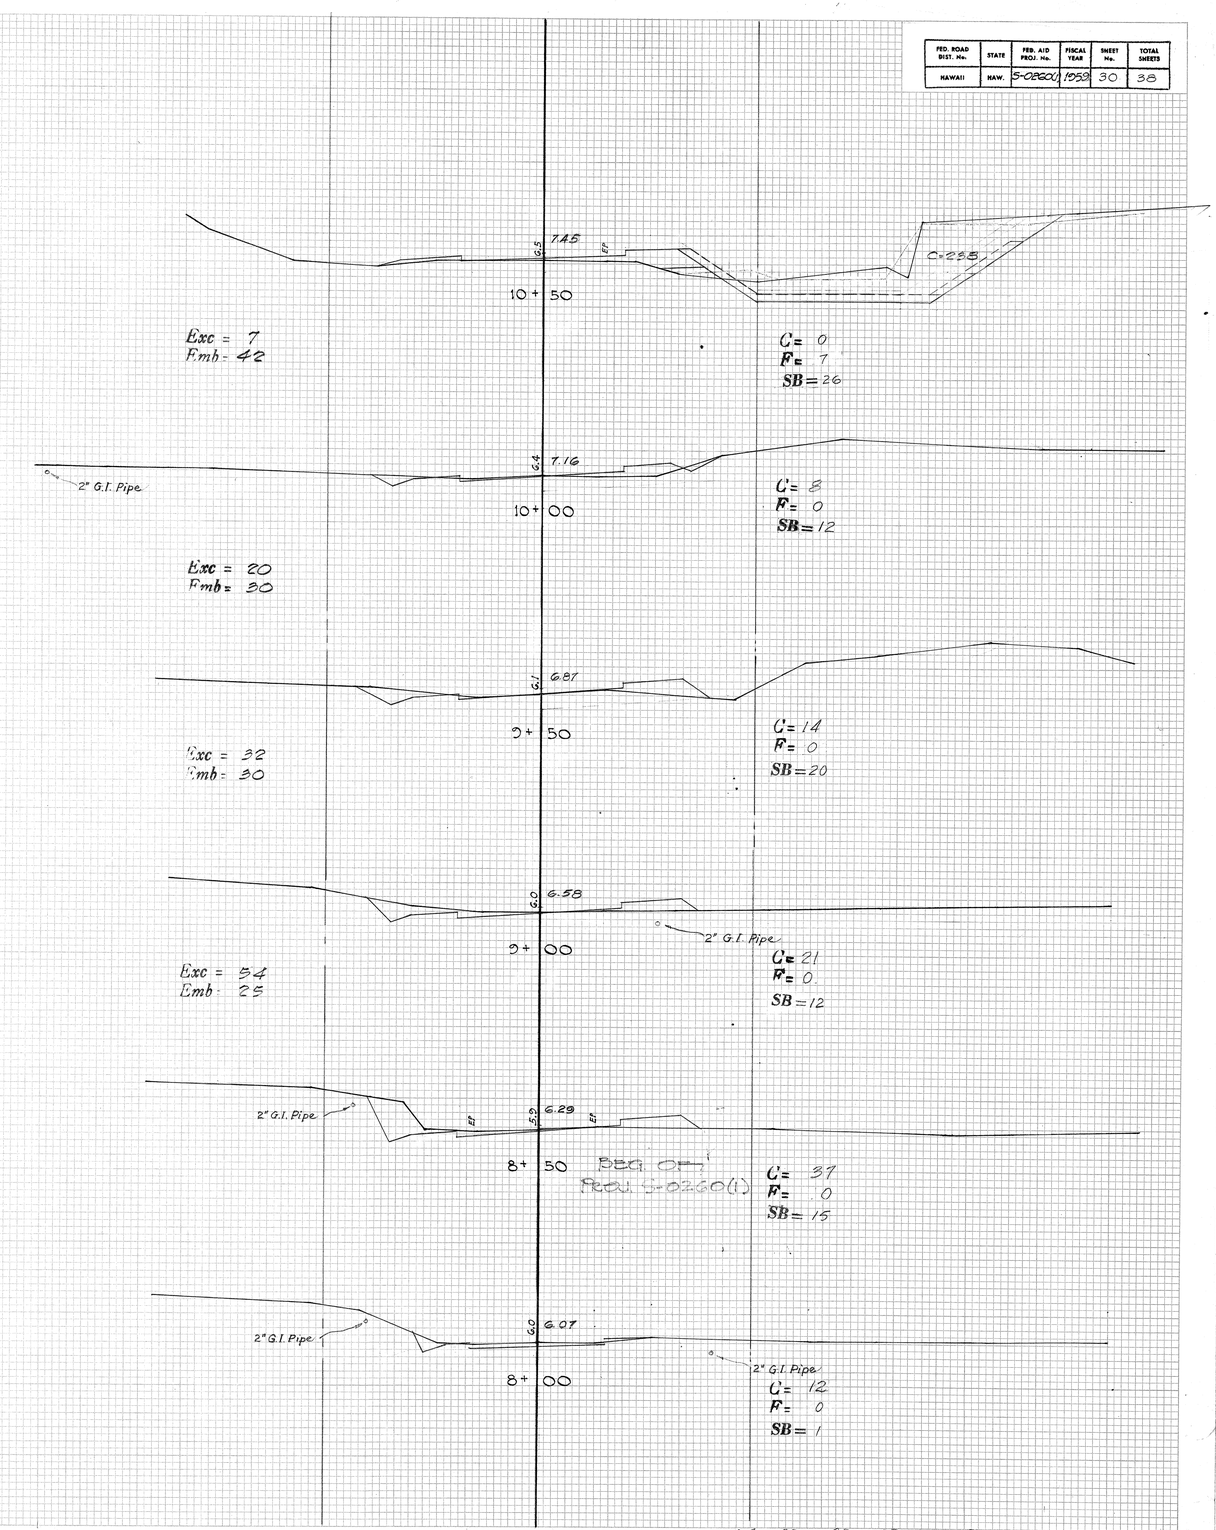

5993.30

FED. ROAD DIST. No.	STATE	FED. AID PROJ. No.	FISCAL YEAR	SHEET No.	TOTAL SHEETS
HAWAII	HAW.	S-0260(1)	1959	31	38

FINAL SURVEY — SURVEYED BY / OFFICE / TEMPLATE / AREAS / NOTE BOOK / NO. / AREAS CHECKED / DATE / BY

ORIGINAL SURVEY — SURVEYED BY / OFFICE / TEMPLATE / AREAS / NOTE BOOK / NO. / AREAS CHECKED / DATE 4-58 / BY R.K. ~ S.K. S.K.

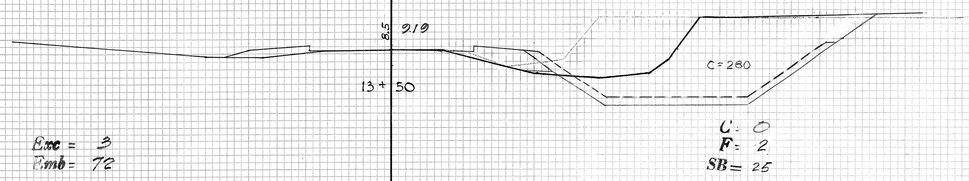

Exc = 3
Emb = 72

C = 0
F = 2
SB = 25

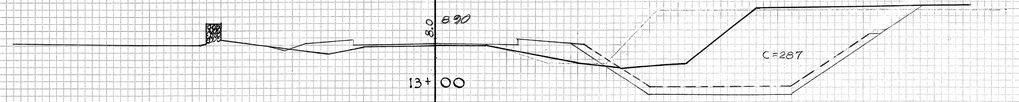

Exc = 3
Emb = 84

C = 3
F = 0
SB = 51

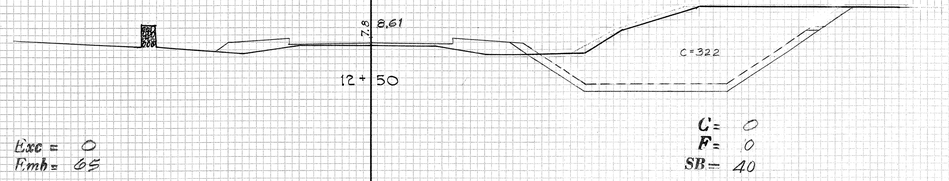

Exc = 0
Emb = 65

C = 0
F = 0
SB = 40

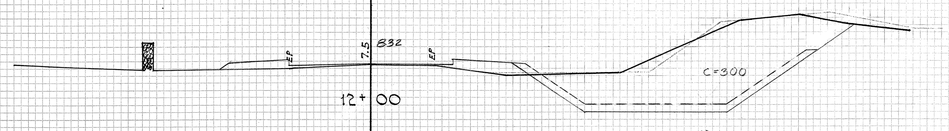

Exc = 0
Emb = 74

C = 0
F = 0
SB = 30

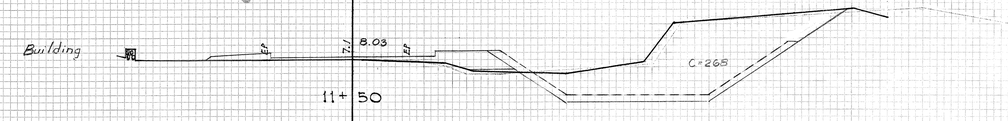

Exc = 2
Emb = 94

C = 0
F = 3
SB = 47

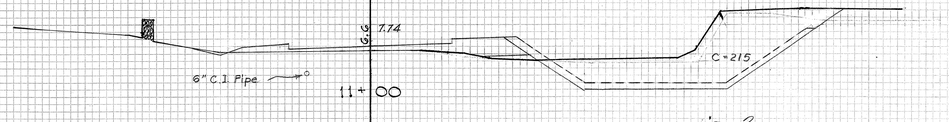

Exc = 2
Emb = 78

C = 2
F = 5
SB = 46

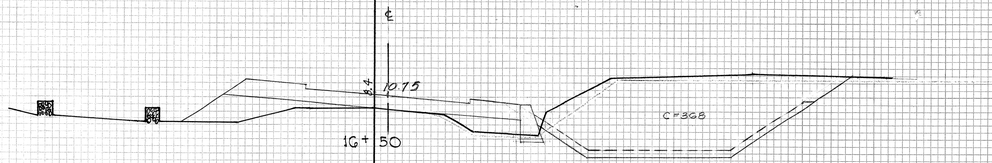

Exc = 0
Emb = 280

C = 0
F = 67
SB = 98

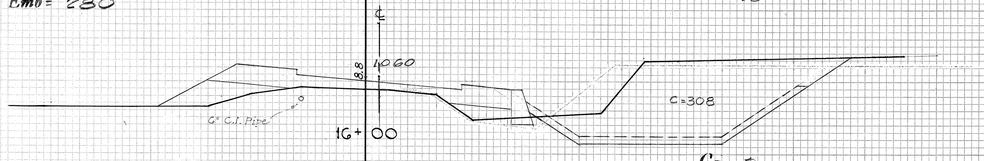

Exc = 0
Emb = 225

C = 0
F = 42
SB = 95

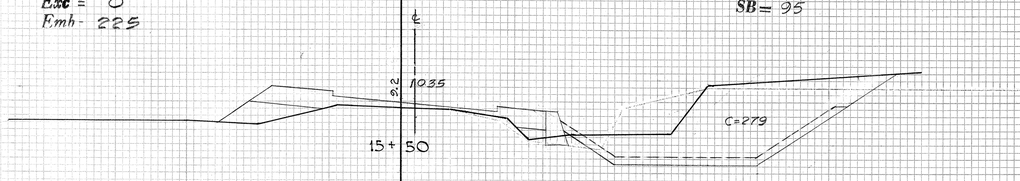

Exc = 0
Emb = 131

C = 0
F = 30
SB = 76

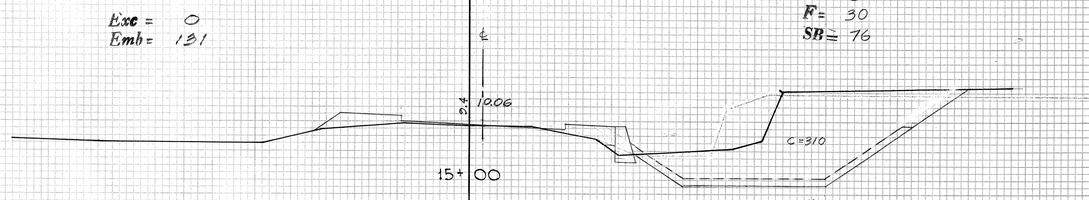

Exc = 5
Emb = 79

C = 0
F = 1
SB = 34

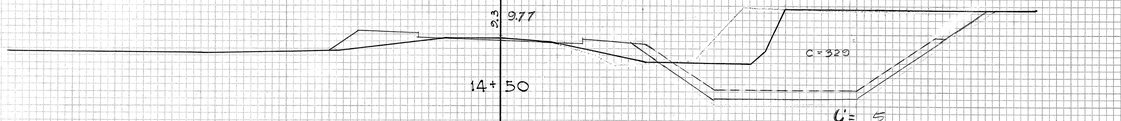

Exc = 5
Emb = 109

C = 5
F = 0
SB = 50

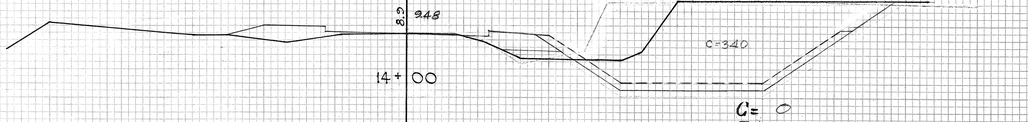

Exc = 0
Emb = 88

C = 0
F = 10
SB = 58

PLATE 3 CROSS SECTION D. P. R. & R. E. STANDARD
100% RAG PAPER—MADE AND PRINTED IN U. S. A.
EUGENE DIETZGEN CO.

5993.31

FED. ROAD DIST. No.	STATE	FED. AID PROJ. No.	FISCAL YEAR	SHEET No.	TOTAL SHEETS
HAWAII	HAW.	S-0E601	1957	32	38

FINAL SURVEY — SURVEYED BY ____ DATE ____ NOTE BOOK ____ NO. ____ TEMPLATE ____ AREAS ____ AREAS CHECKED ____

ORIGINAL SURVEY — SURVEYED BY E.K. S.K. DATE 4.58 NOTE BOOK ____ NO. ____ TEMPLATE ____ AREAS ____ AREAS CHECKED ____

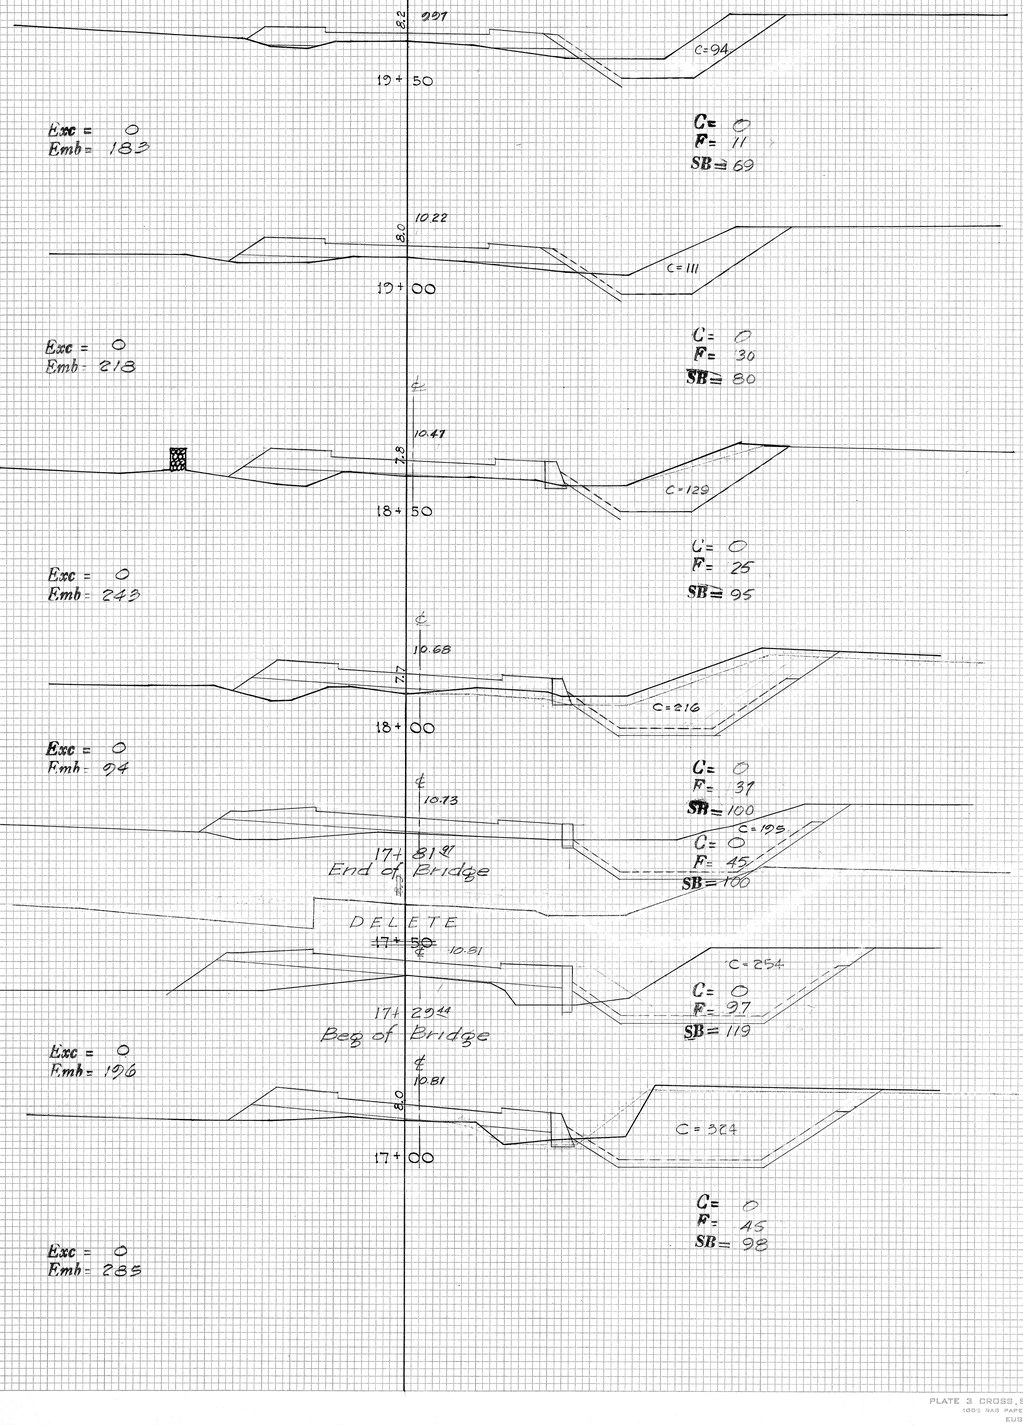

Exc = 0
Emb = 183

C = 0
F = 11
SB = 69

Exc = 0
Emb = 218

C = 0
F = 30
SB = 80

Exc = 0
Emb = 243

C = 0
F = 25
SB = 95

Exc = 0
Emb = 94

C = 0
F = 37
SB = 100

C = 0
F = 45
SB = 100

Exc = 0
Emb = 196

C = 0
F = 97
SB = 119

Exc = 0
Emb = 285

C = 0
F = 45
SB = 98

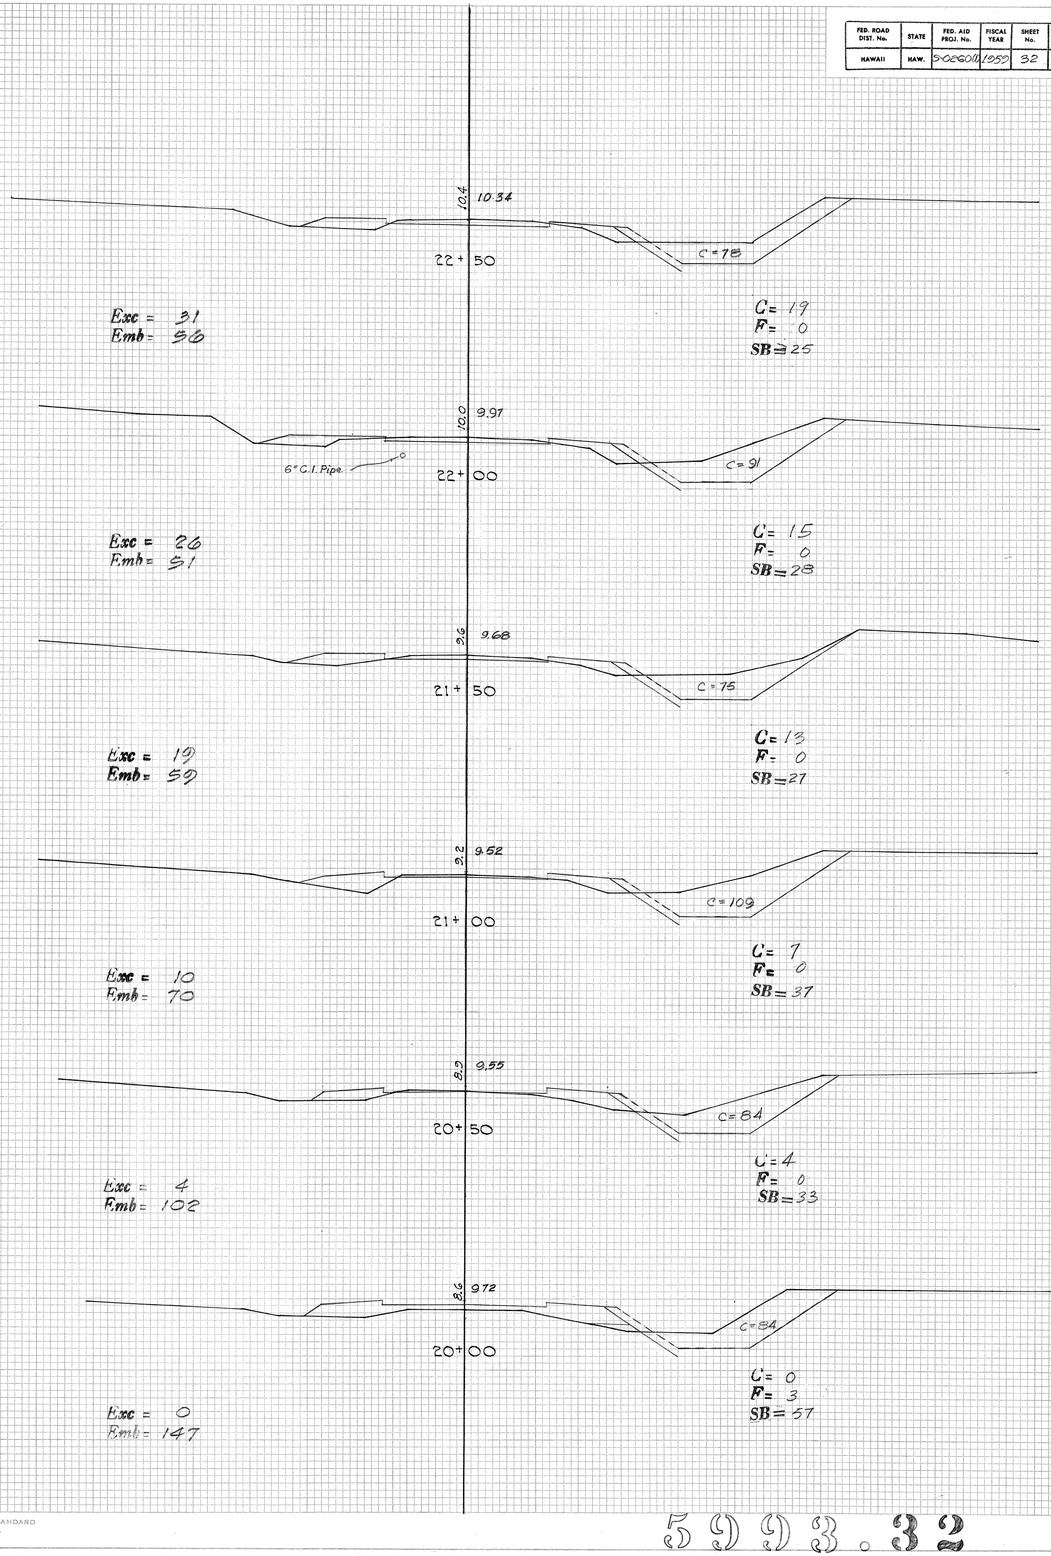

Exc = 31
Emb = 56

C = 19
F = 0
SB = 25

Exc = 26
Emb = 51

C = 15
F = 0
SB = 28

Exc = 19
Emb = 59

C = 13
F = 0
SB = 27

Exc = 10
Emb = 70

C = 7
F = 0
SB = 37

Exc = 4
Emb = 102

C = 4
F = 0
SB = 33

Exc = 0
Emb = 147

C = 0
F = 3
SB = 57

PLATE 3 CROSS SECTION C. P. R. & R. E. STANDARD
100% RAG PAPER—MADE AND PRINTED IN U. S. A.
EUGENE DIETZGEN CO.

5993.32

FED. ROAD DIST. No.	STATE	FED. AID PROJ. No.	FISCAL YEAR	SHEET No.	TOTAL SHEETS
HAWAII	HAW.	S-0260(1)	1959	33	38

FINAL SURVEY — SURVEYED — PLOTTED — TEMPLATE — AREAS — AREAS CHECKED — NOTE BOOK — NO. — BY — DATE

ORIGINAL SURVEY — SURVEYED E.E. S.S. — PLOTTED — TEMPLATE — AREAS — AREAS CHECKED — NOTE BOOK — NO. — BY — DATE 4/58

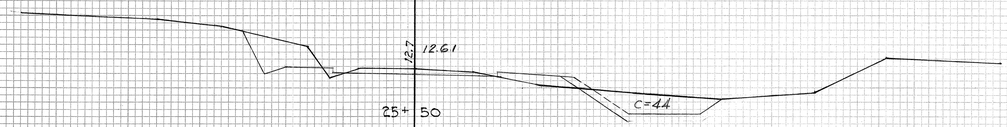

Exc = 79
Emb = 20

C = 49
F = 0
SB = 13

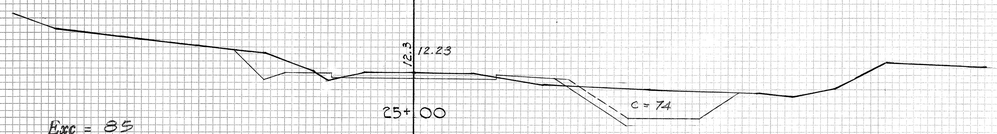

Exc = 85
Emb = 17

C = 36
F = 0
SB = 9

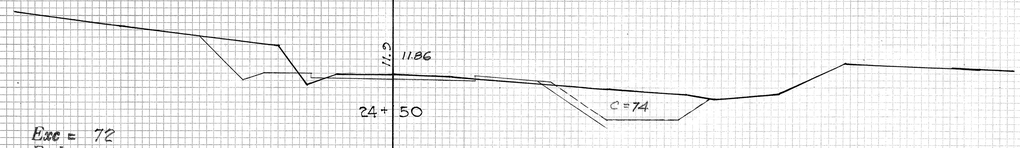

Exc = 72
Emb = 27

C = 56
F = 0
SB = 9

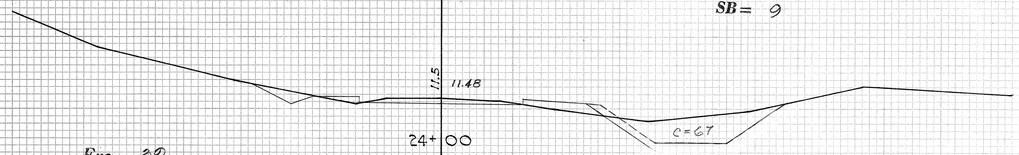

Exc = 39
Emb = 34

C = 22
F = 0
SB = 20
Centerline 23+85±

Exc = 31
Emb = 31

C = 20
F = 0
SB = 17

Exc = 30
Emb = 45

C = 13
F = 1
SB = 16

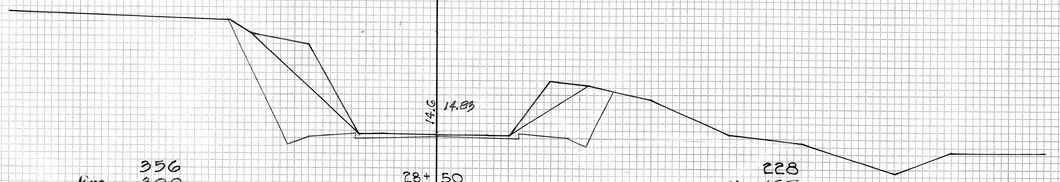

Exc = 356 ~~300~~
Emb = 6

228
C = ~~467~~
F = 0
SB = 0

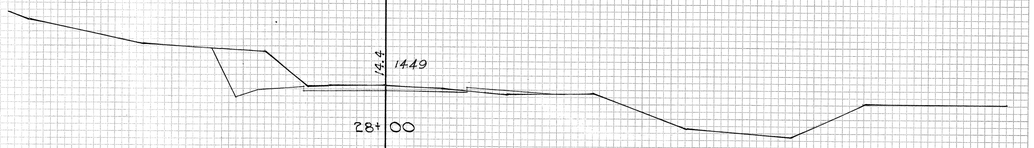

Exc = 81
Emb = 28

C = 72
F = 0
SB = 6

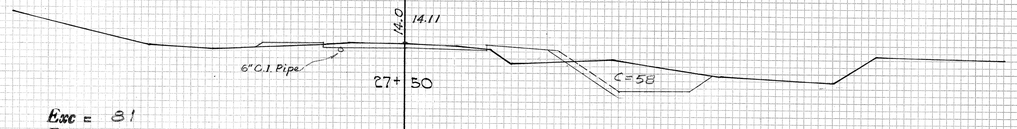

Exc = 81
Emb = 22

C = 15
F = 0
SB = 24

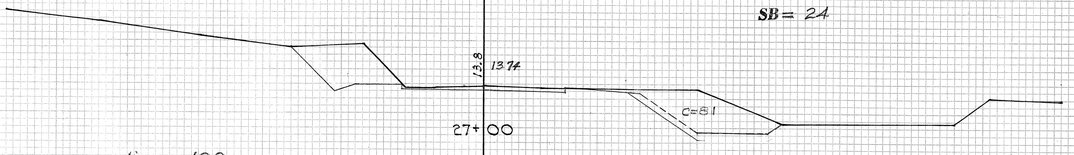

Exc = 108
Emb = 4

C = 73
F = 0
SB = 0

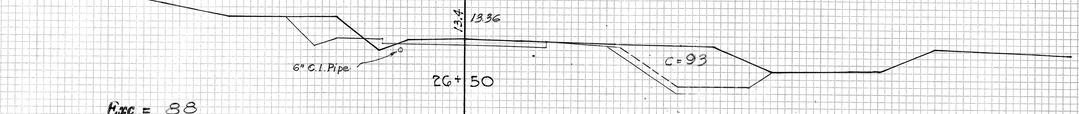

Exc = 88
Emb = 7

C = 41
F = 0
SB = 4

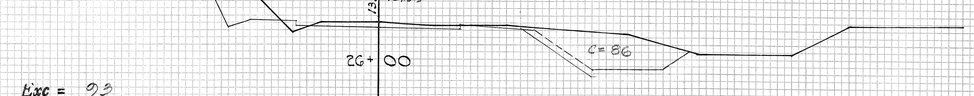

Exc = 93
Emb = 16

C = 51
F = 0
SB = 4

PLATE 3 CROSS SECTION C. P. R. & R. E. STANDARD
1001 "KAB" PAPER MADE AND PRINTED IN U. S. A.
EUGENE DIETZGEN CO.

5993.33

FED. ROAD DIST. No.	STATE	FED. AID PROJ. No.	FISCAL YEAR	SHEET No.	TOTAL SHEETS
HAWAII	HAW.	S-0260(1)	1959	34	38

FINAL SURVEY — NOTE BOOK — NO. — SURVEYED — PLOTTED — TEMPLATE — AREAS — AREAS CHECKED — BY — DATE

ORIGINAL SURVEY — NOTE BOOK — NO. — SURVEYED — PLOTTED — TEMPLATE — AREAS — AREAS CHECKED — BY R.E., R.E. — DATE 4/58, 4/58

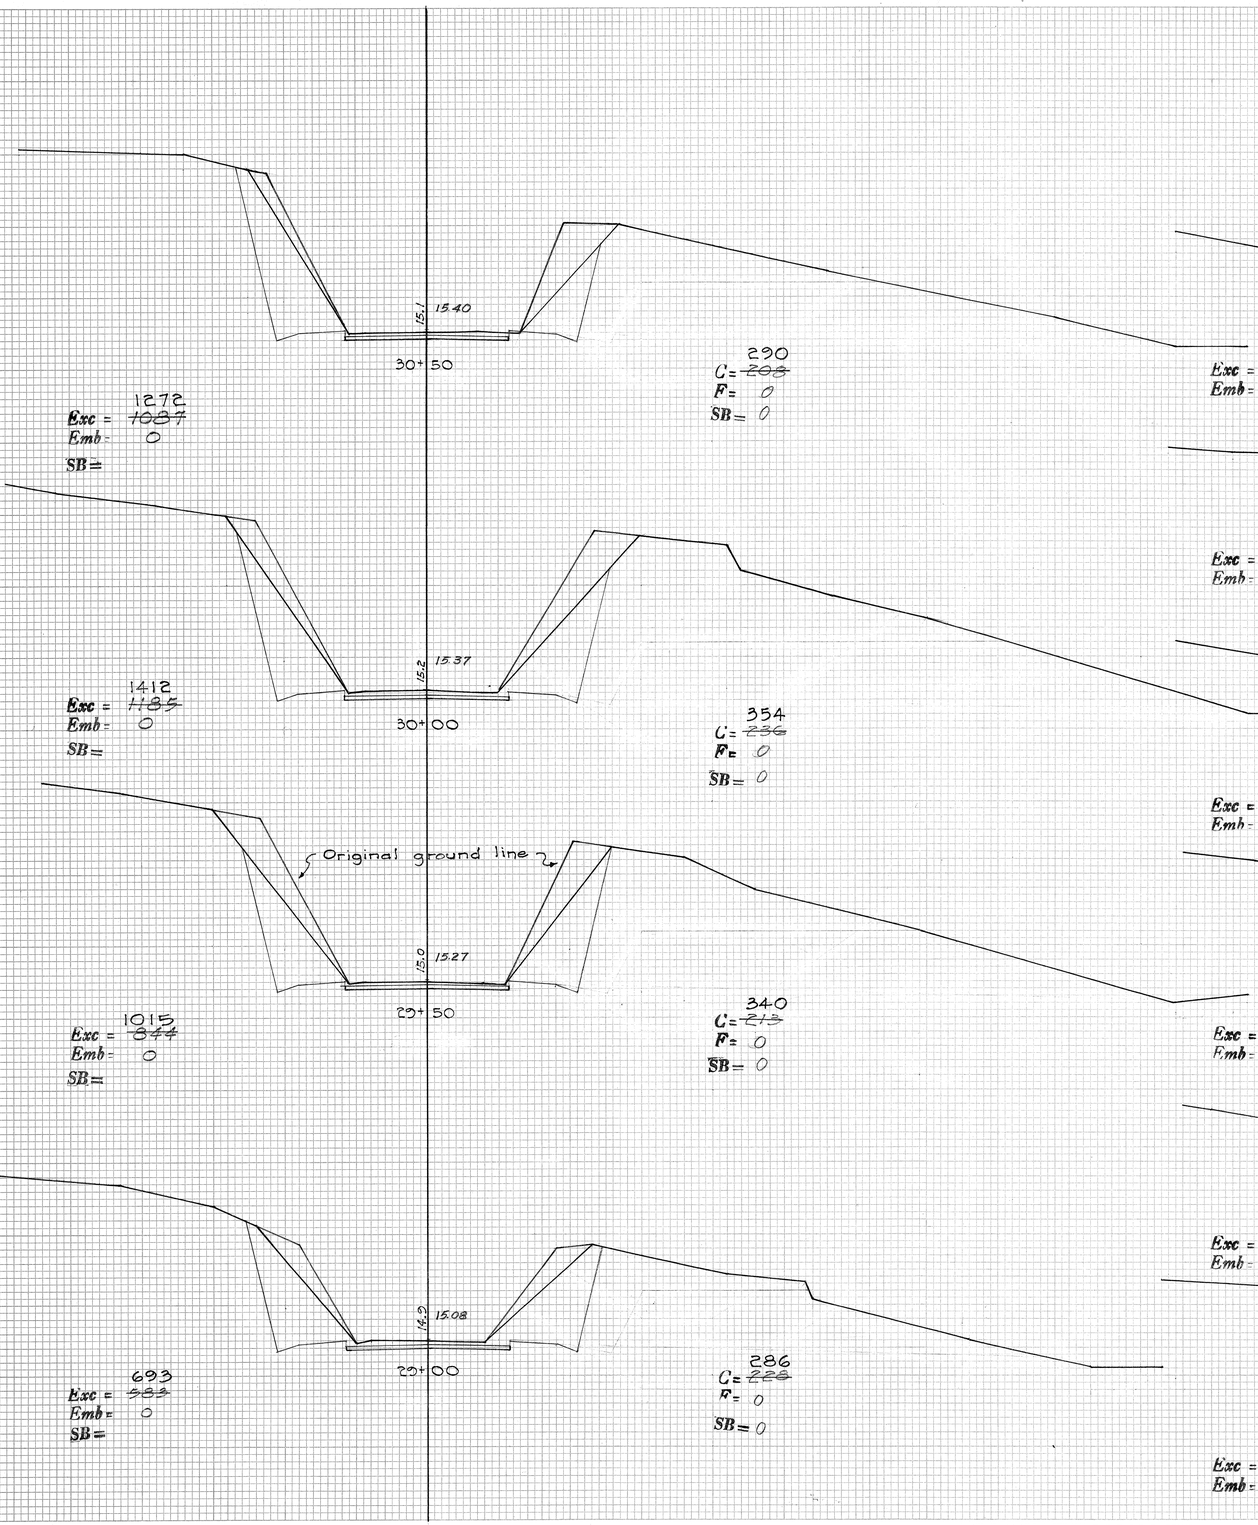

Exc = 1272 ~~1087~~	Emb = 0	SB =	C = 290 ~~208~~	F = 0	SB = 0
Exc = 59	Emb = 36		C = 13	F = 4	SB = 39
Exc = 1412 ~~1135~~	Emb = 0	SB =	C = 354 ~~236~~	F = 0	SB = 0
Exc = 83	Emb = 12		C = 51	F = 0	SB = 3
Exc = 1015 ~~844~~	Emb = 0	SB =	C = 340 ~~213~~	F = 0	SB = 0
Exc = 82	Emb = 19		C = 50	F = 0	SB = 10
Exc = 693 ~~583~~	Emb = 0	SB =	C = 286 ~~228~~	F = 0	SB = 0
Exc = 165	Emb = 9		C = 128	F = 0	SB = 0
Exc = 454 ~~427~~	Emb = 0		C = 212 ~~183~~	F = 0	SB = 0
Exc = 808 ~~705~~	Emb = 0		C = 39	F = 0	SB = 10

PLATE 3 CROSS SECTION C. P. R. & R. E. STANDARD
100% RAG PAPER—MADE AND PRINTED IN U. S. A.
EUGENE DIETZGEN CO.

59.93.34

FED. ROAD DIST. No.	STATE	FED. AID PROJ. No.	FISCAL YEAR	SHEET No.	TOTAL SHEETS
HAWAII	HAW.	S-0200(10)	1959	35	38

FINAL SURVEY — DATE — BY — SURVEYED — PLOTTED — TRIPLICATE AREAS — DOUBLE AREAS — CHECKED — NOTE BOOK — NO.

ORIGINAL SURVEY — DATE 4/58 4/5/58 — BY E.S. E.S. — SURVEYED — PLOTTED — TRIPLICATE AREAS — DOUBLE AREAS — CHECKED — NOTE BOOK — NO.

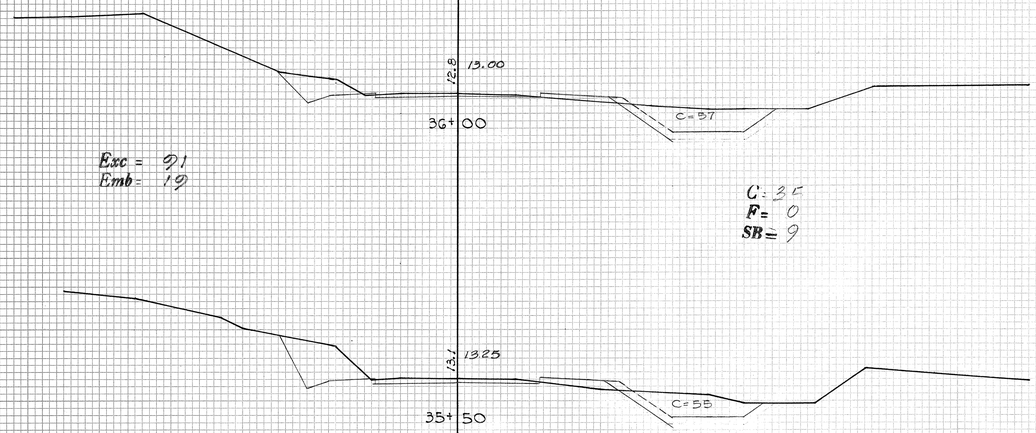

Exc = 91
Emb = 19

C = 35
F = 0
SB = 9

Exc = 124
Emb = 12

C = 63
F = 0
SB = 11

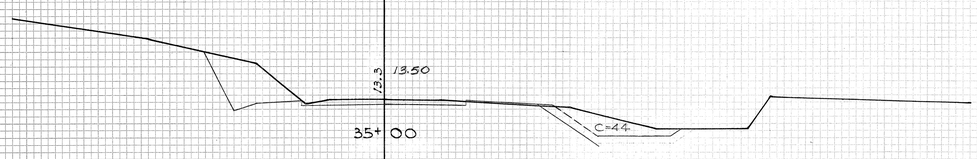

Exc = 127
Emb = 13

C = 71
F = 0
SB = 2

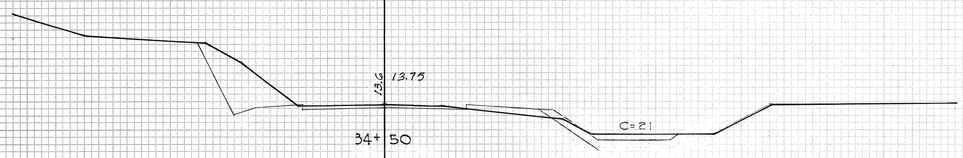

Exc = 113
Emb = 31

C = 66
F = 0
SB = 12

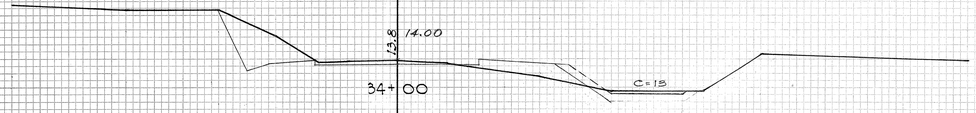

Exc = 64
Emb = 59

C = 56
F = 0
SB = 21

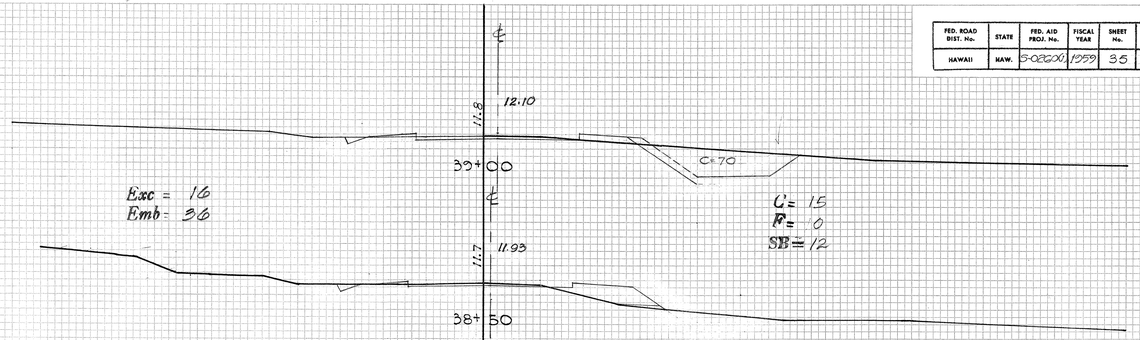

Exc = 16
Emb = 36

C = 15
F = 0
SB = 12

Exc = 9
Emb = 5

C = 12
F = 2
SB = 25
Cont. Sta. 38+55.26

End of coral fill

Exc = 23
Emb = 59

C = 18
F = 2
SB = 23

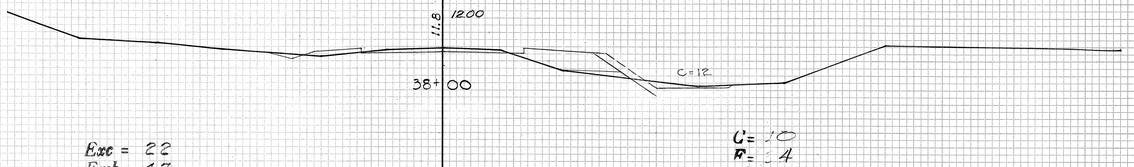

Exc = 22
Emb = 47

C = 10
F = 4
SB = 35

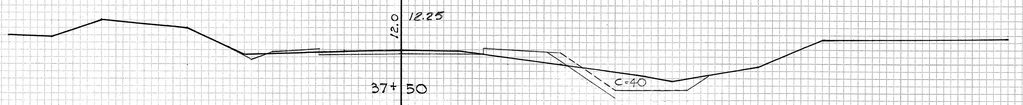

Exc = 24
Emb = 44

C = 14
F = 0
SB = 12

Exc = 24
Emb = 41

C = 12
F = 0
SB = 36

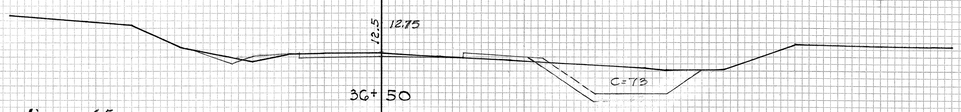

Exc = 45
Emb = 16

C = 14
F = 0
SB = 8

PLATE 3 CROSS SECTION U. P. R. & R. E. STANDARD
100% RAG PAPER—MADE AND PRINTED IN U. S. A.
EUGENE DIETZGEN CO.

5993.35

FED. ROAD DIST. No.	STATE	FED. AID PROJ. No.	FISCAL YEAR	SHEET No.	TOTAL SHEETS
HAWAII	HAW.	S-0E30(1)52	36	38	

FINAL SURVEY — SURVEYED BY — DRAWN BY — TEMPLATE — AREAS — AREAS CHECKED — NOTE BOOK — NO. — DATE

ORIGINAL SURVEY — SURVEYED BY R.E. — DRAWN BY R.E. — TEMPLATE — AREAS — AREAS CHECKED — NOTE BOOK — NO. — DATE 2/58 4/58

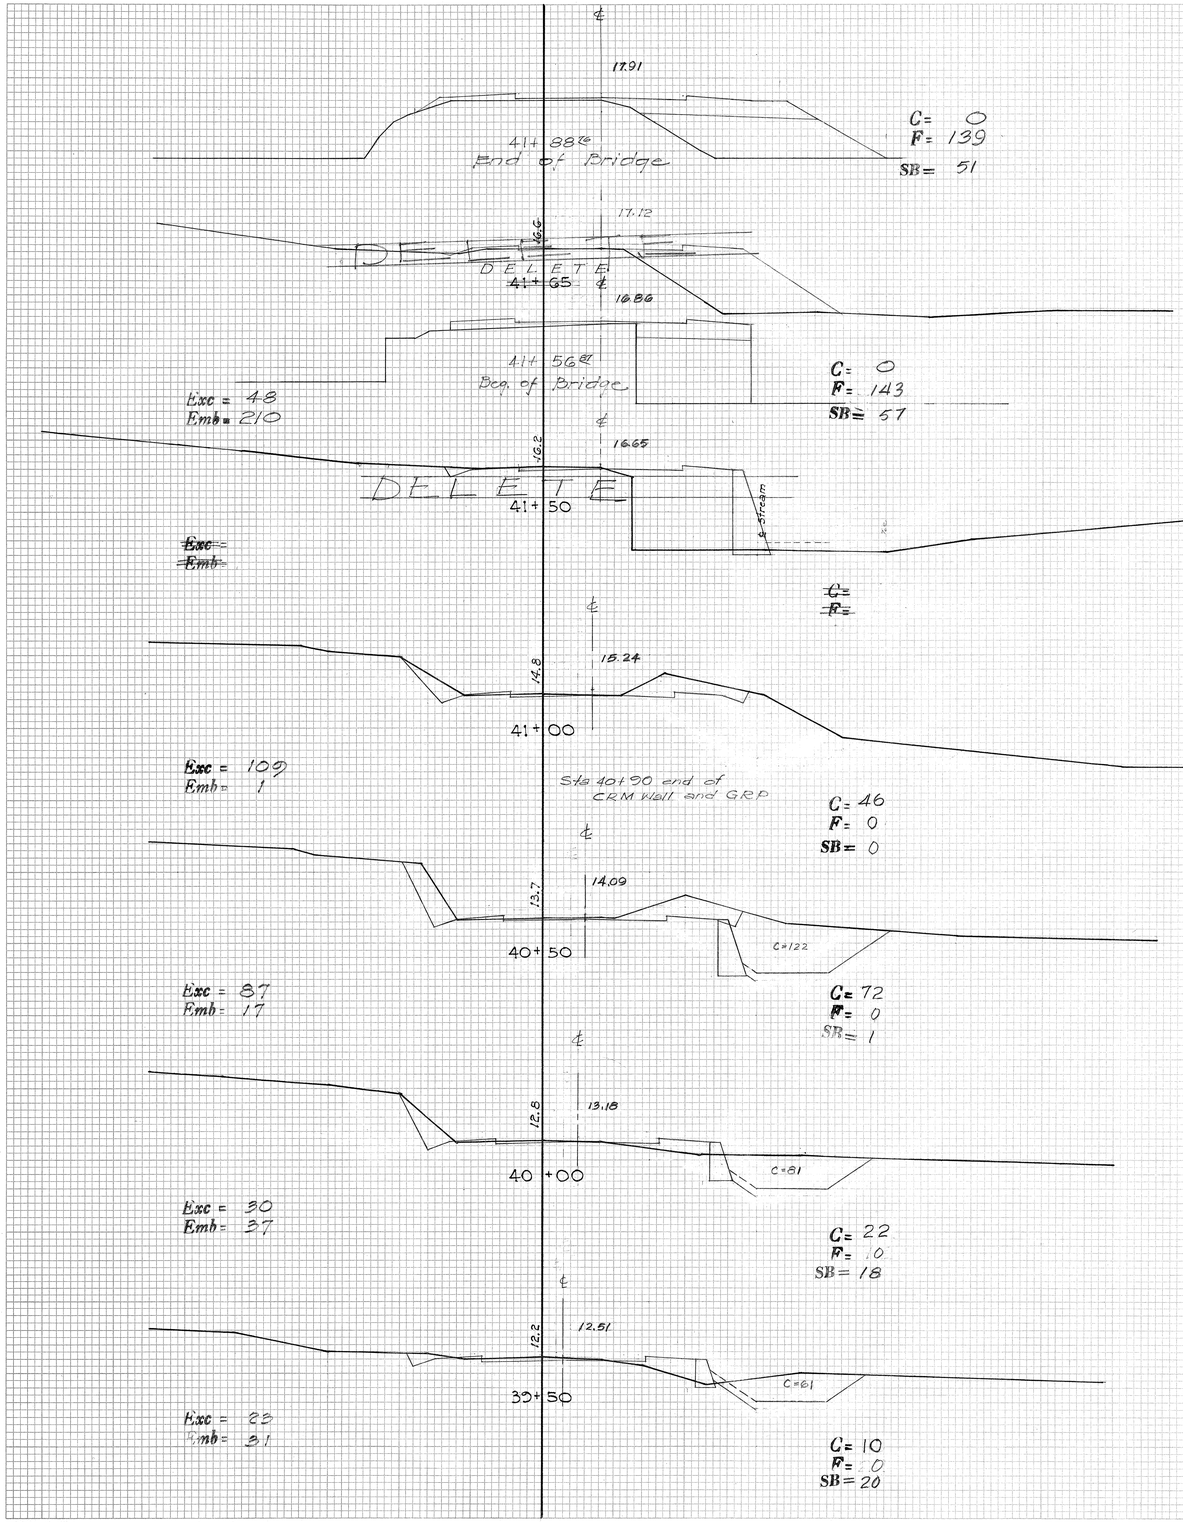

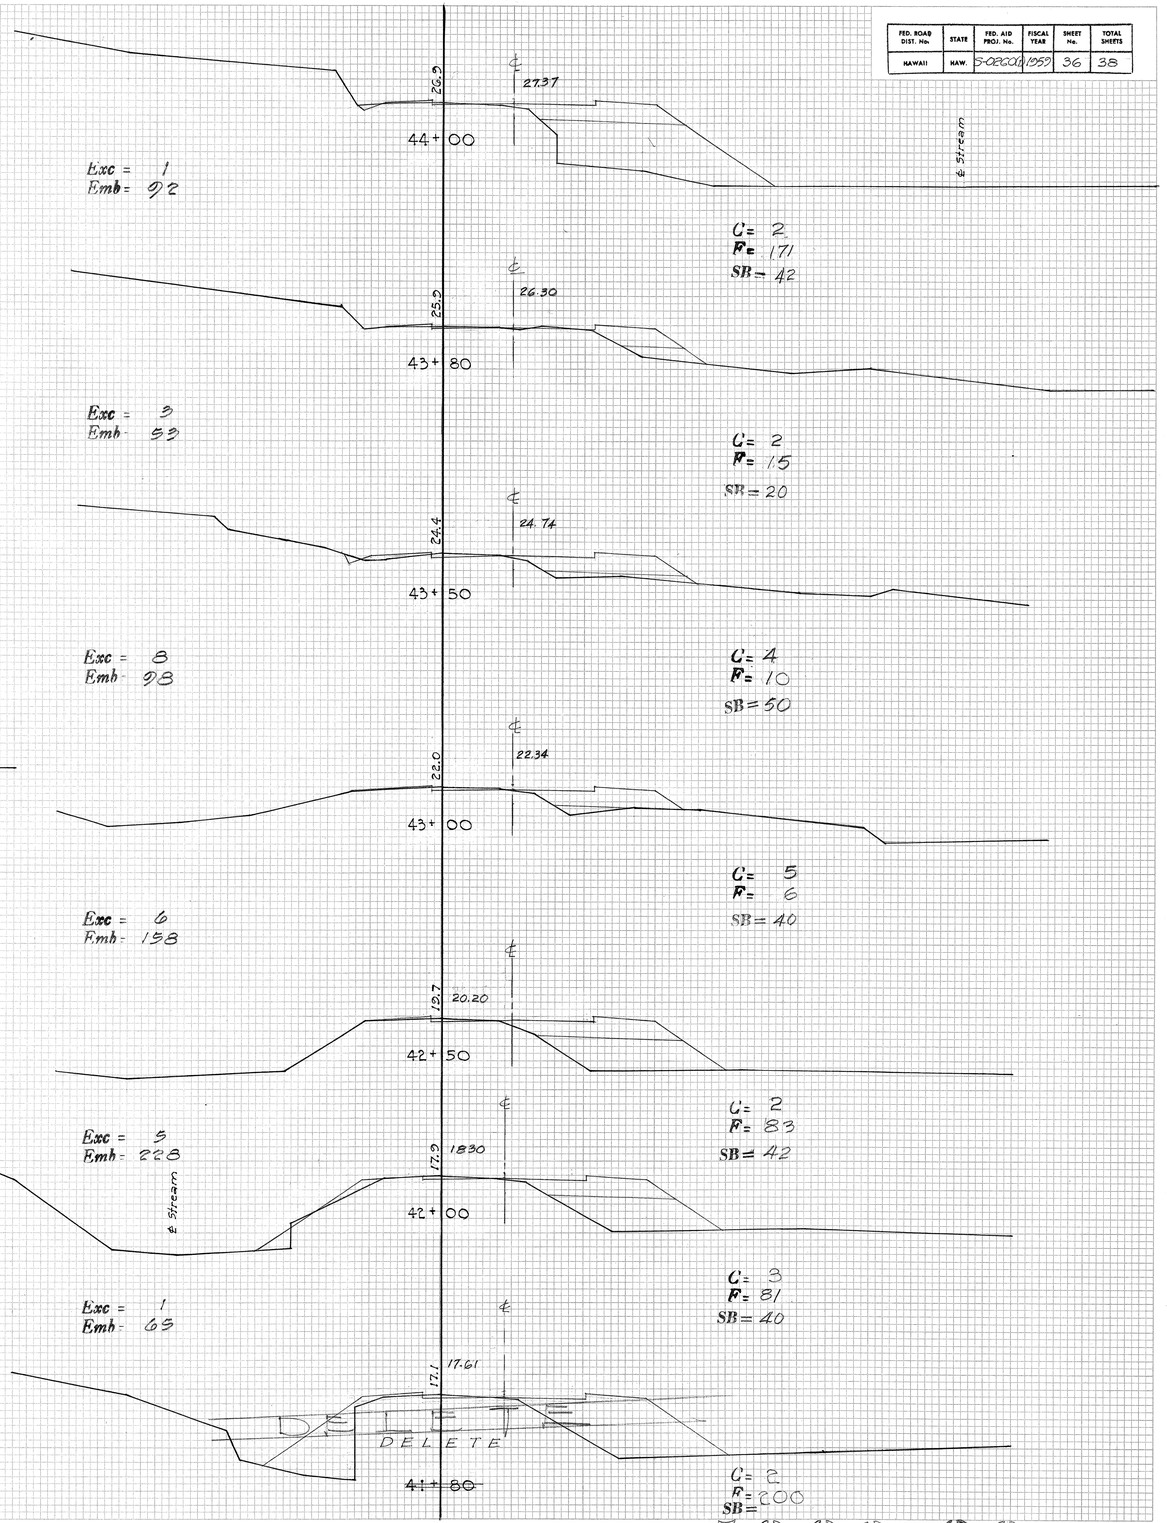

PLATE 3 CROSS SECTION C. P. R. & R. E. STANDARD
100% RAG PAPER—MADE AND PRINTED IN U. S. A.
EUGENE DIETZGEN CO.

5993.36

FED. ROAD DIST. No.	STATE	FED. AID PROJ. No.	FISCAL YEAR	SHEET No.	TOTAL SHEETS
HAWAII	HAW.	S-0260(4)059	37	38	

FINAL SURVEY — NOTE BOOK NO. — SURVEYED — PLOTTED — CHECKED — AREAS — AREAS CHECKED — BY — DATE

ORIGINAL SURVEY — NOTE BOOK NO. — SURVEYED — PLOTTED — CHECKED — AREAS — AREAS CHECKED — BY E.L. E.L. — DATE 4/58 6/59

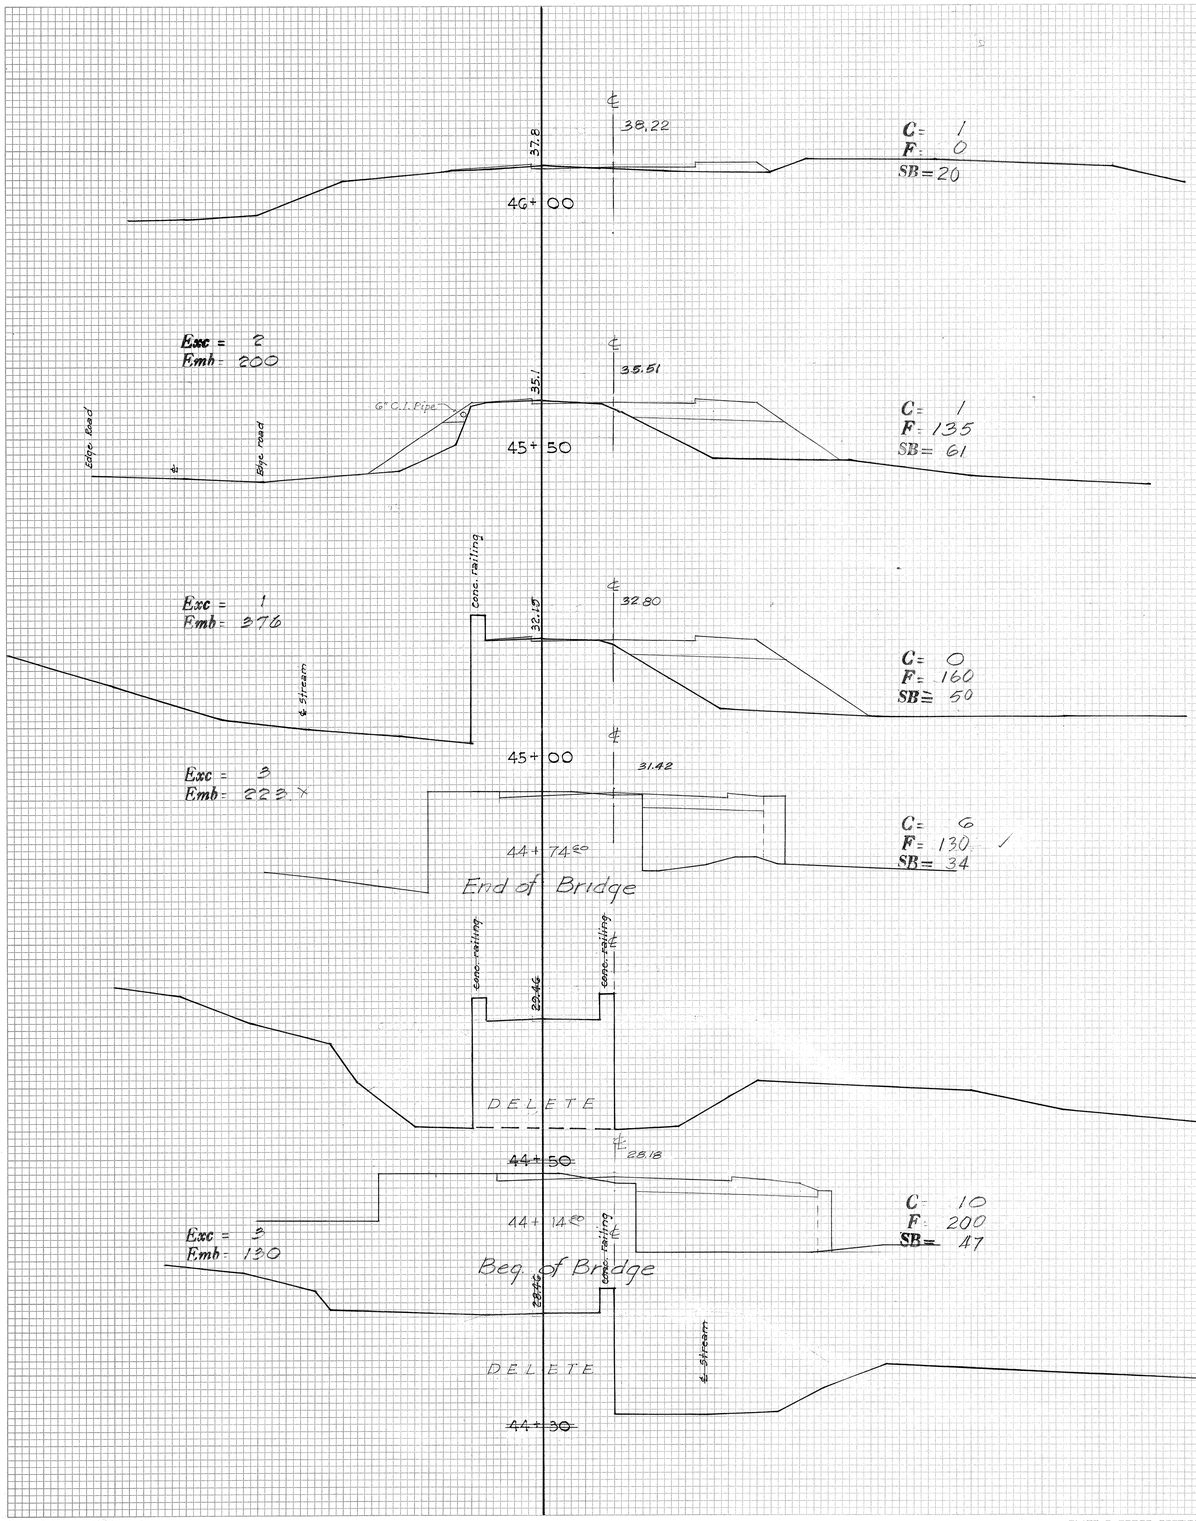

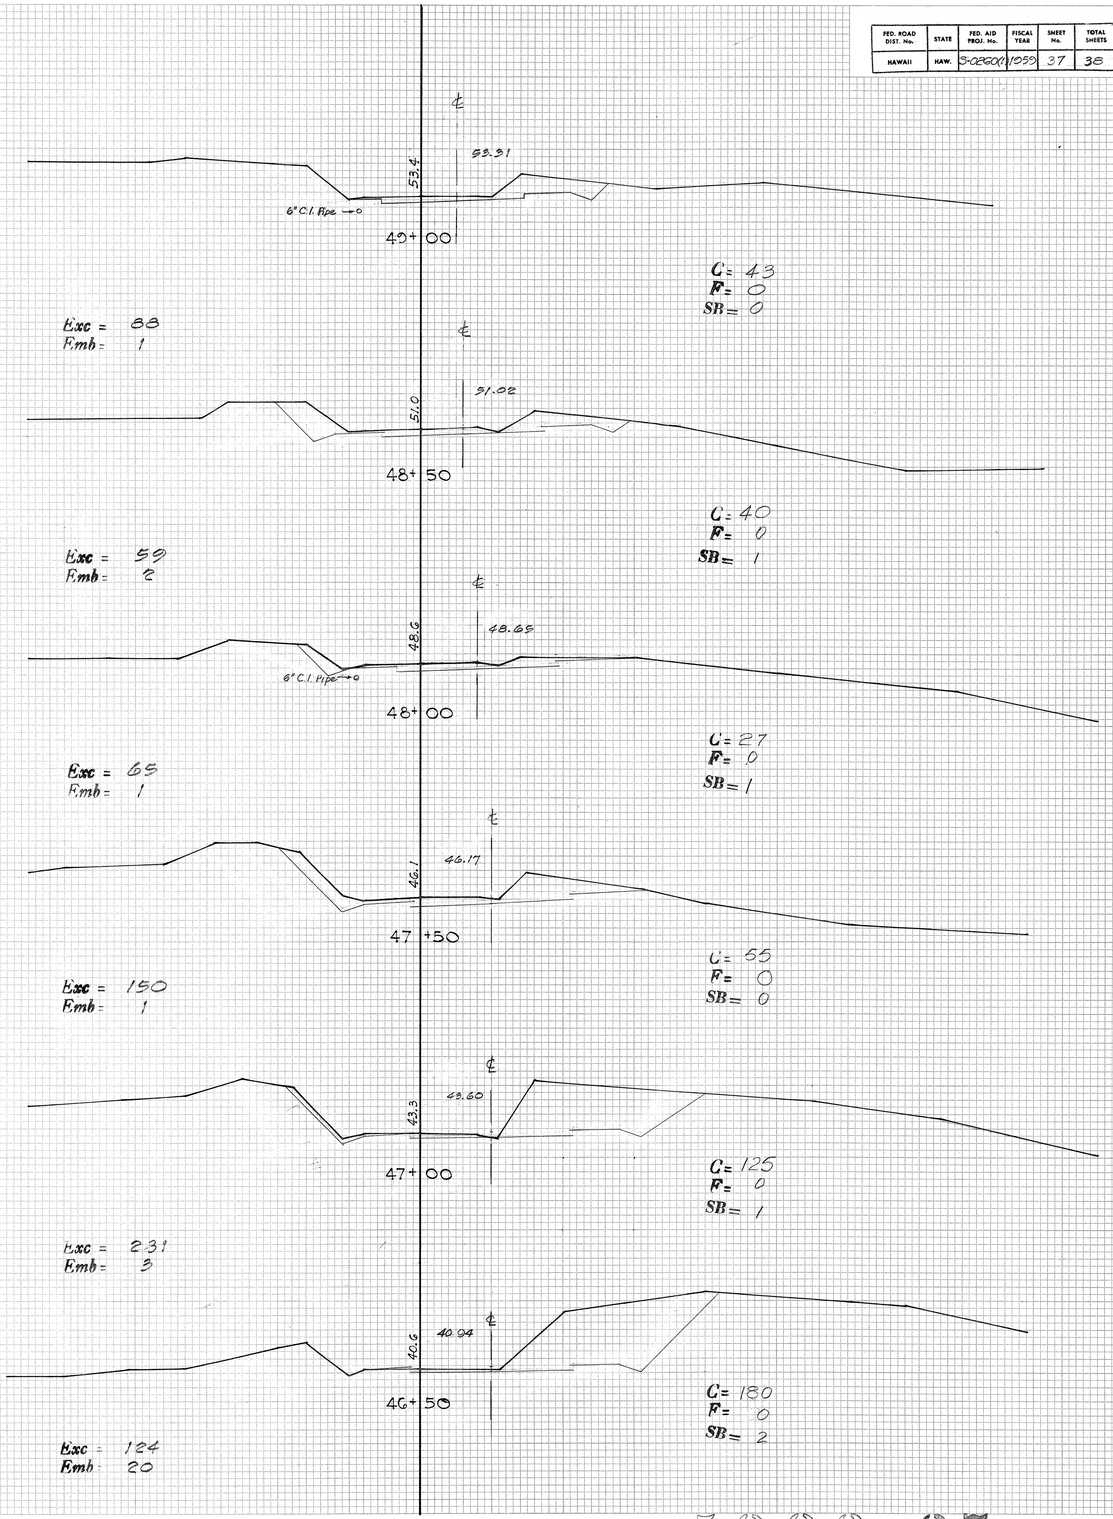

5993.37

FED. ROAD DIST. No.	STATE	FED. AID PROJ. No.	FISCAL YEAR	SHEET No.	TOTAL SHEETS
HAWAII	HAW	S02600	1955	38	38

FINAL SURVEY
SURVEYED
PLOTTED
TRACED
NOTE BOOK
NO.
DATE
BY
AREAS CHECKED

ORIGINAL SURVEY
SURVEYED
PLOTTED
TRACED
NOTE BOOK
NO.
DATE
BY
AREAS CHECKED
E.K. 1/58
E.K. 4/58

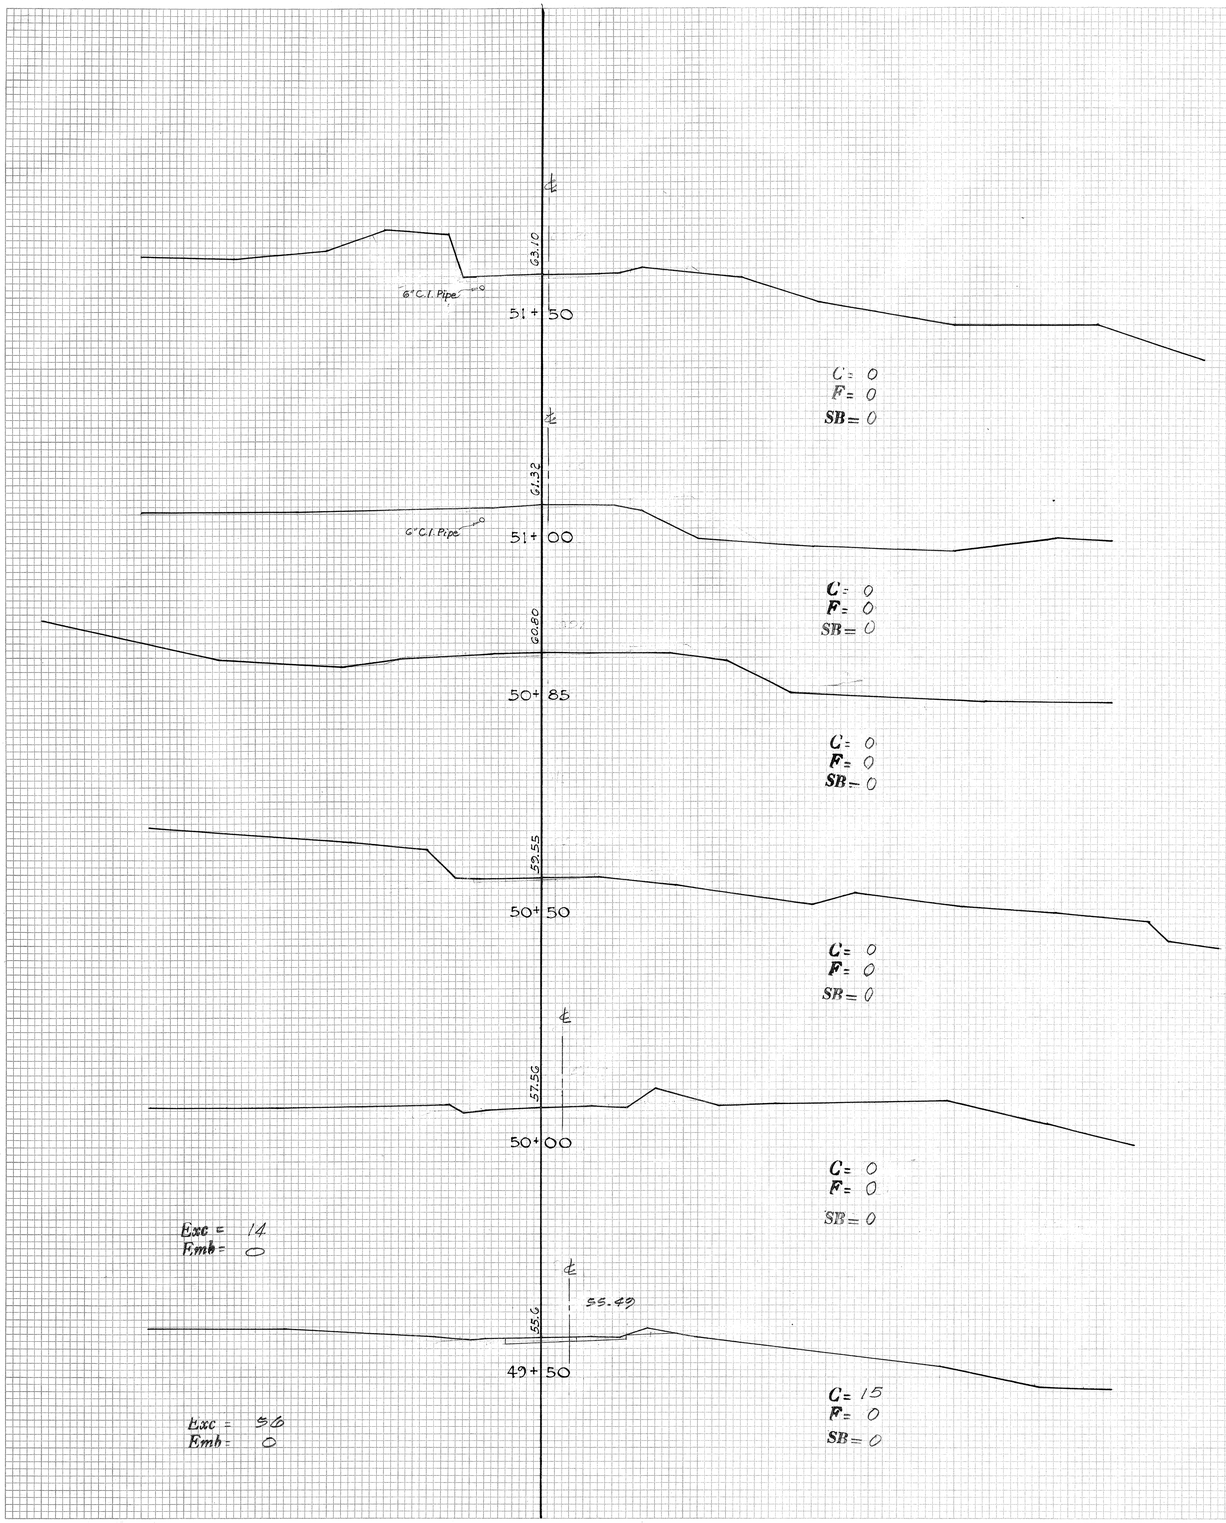

PLATE 3 CROSS SECTION O. P. R. & R. E. STANDARD
1951 RAG PAPER MADE AND PRINTED IN U. S. A.
EUGENE DIETZGEN CO.

5993.38