FED. ROAD DIST. NO.	STATE	FED. AID PROJ. NO.	FISCAL YEAR	SHEET NO.	TOTAL SHEETS
HAWAII	HAW.	HHS-027-1(1)	1978	3	25

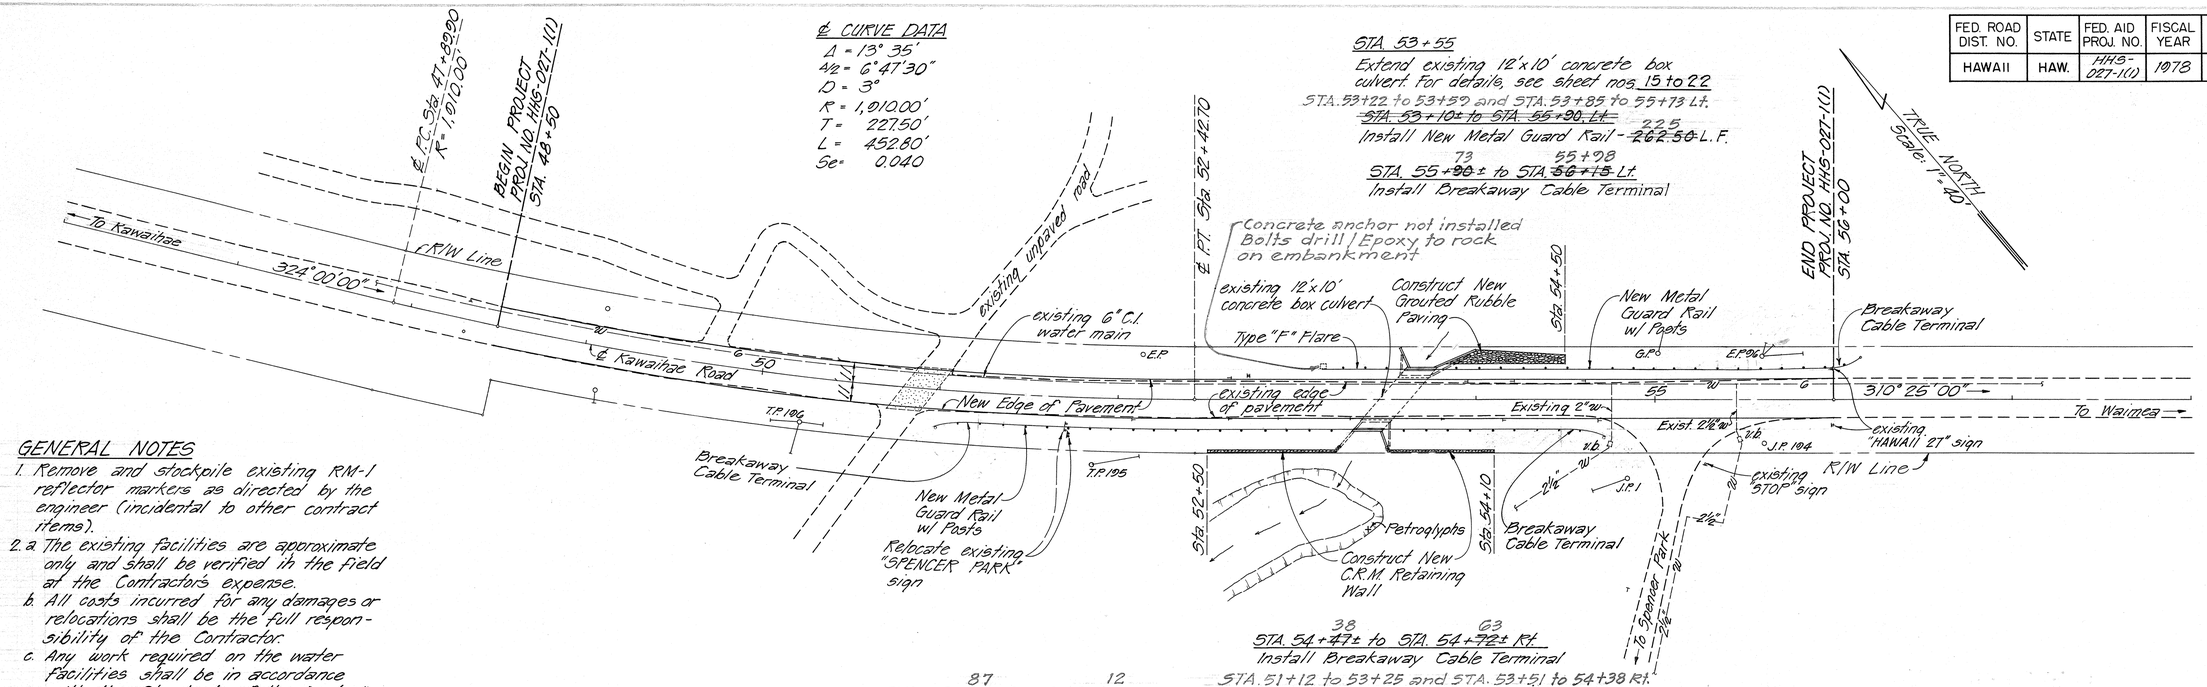

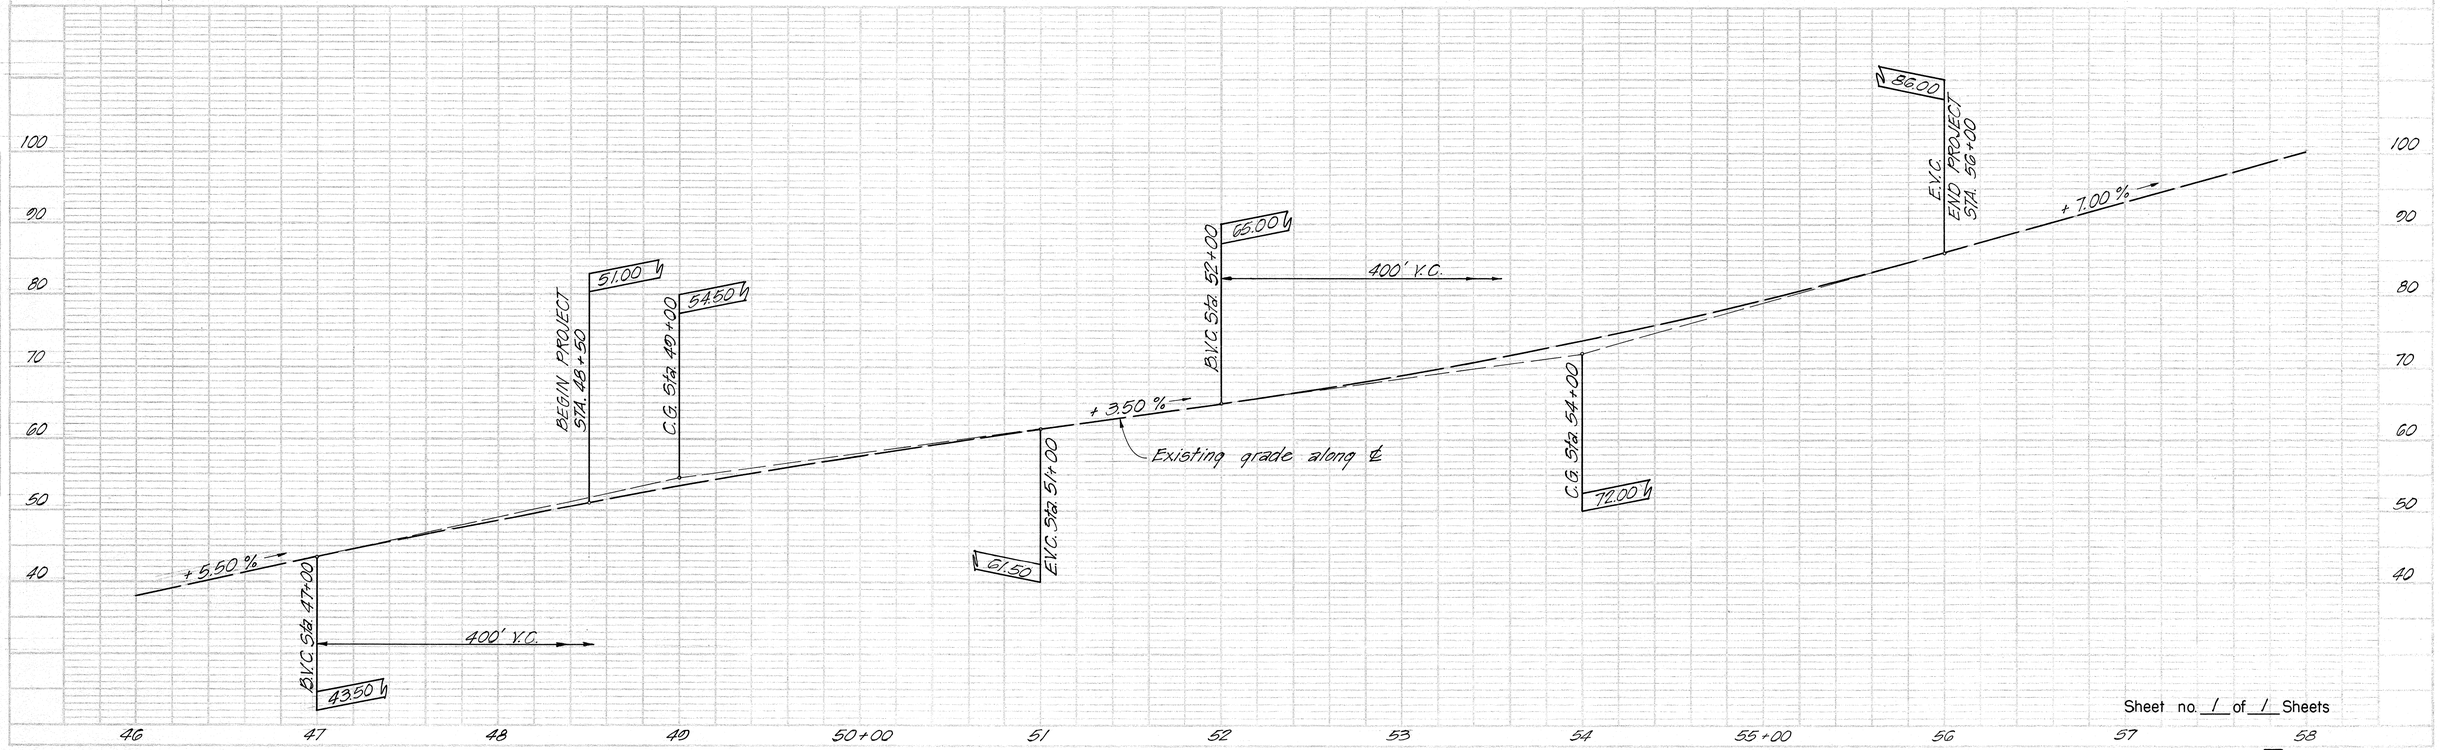

Sheet no. 1 of 1 Sheets

3

PLATE I—PLAN PROFILE B.P.R. STANDARD
121 SOUTH DEARBORN ST., CHICAGO

1928-1122
00-0-7-7