FED. ROAD DIST. NO.	STATE	PROJ. NO.	FISCAL YEAR	SHEET NO.	TOTAL SHEETS
HAWAII	HAW.	27A-01-88M	1988	1	7

INDEX TO DRAWINGS

SHEET NO.	DESCRIPTION
1	TITLE SHEET
2	STANDARD PLANS SUMMARY
3	TYPICAL SECTIONS & DETAILS
4,5	RECONSTRUCTION & STRIPING
6	WEIGH STATION PLAN AND TYPICAL SECTION
7	MISCELLANEOUS SCHEDULES

STATE OF HAWAII

DEPARTMENT OF TRANSPORTATION

HIGHWAYS DIVISION

"AS-BUILT"

PLANS FOR

KAWAIHAE ROAD RESURFACING

QUEEN KAAHUMANU JCT TO DOI STORE

PROJECT NO. 27A-01-88M

SOUTH KOHALA

ISLAND OF HAWAII

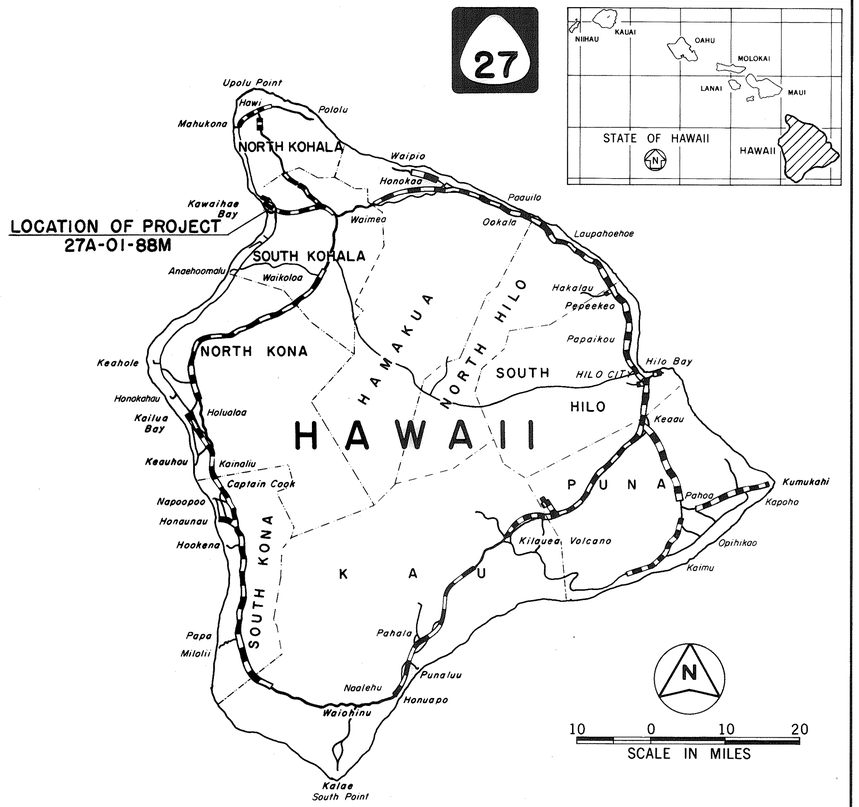

FEDERAL AID PROJECTS PREVIOUSLY CONSTRUCTED OR UNDER CONSTRUCTION

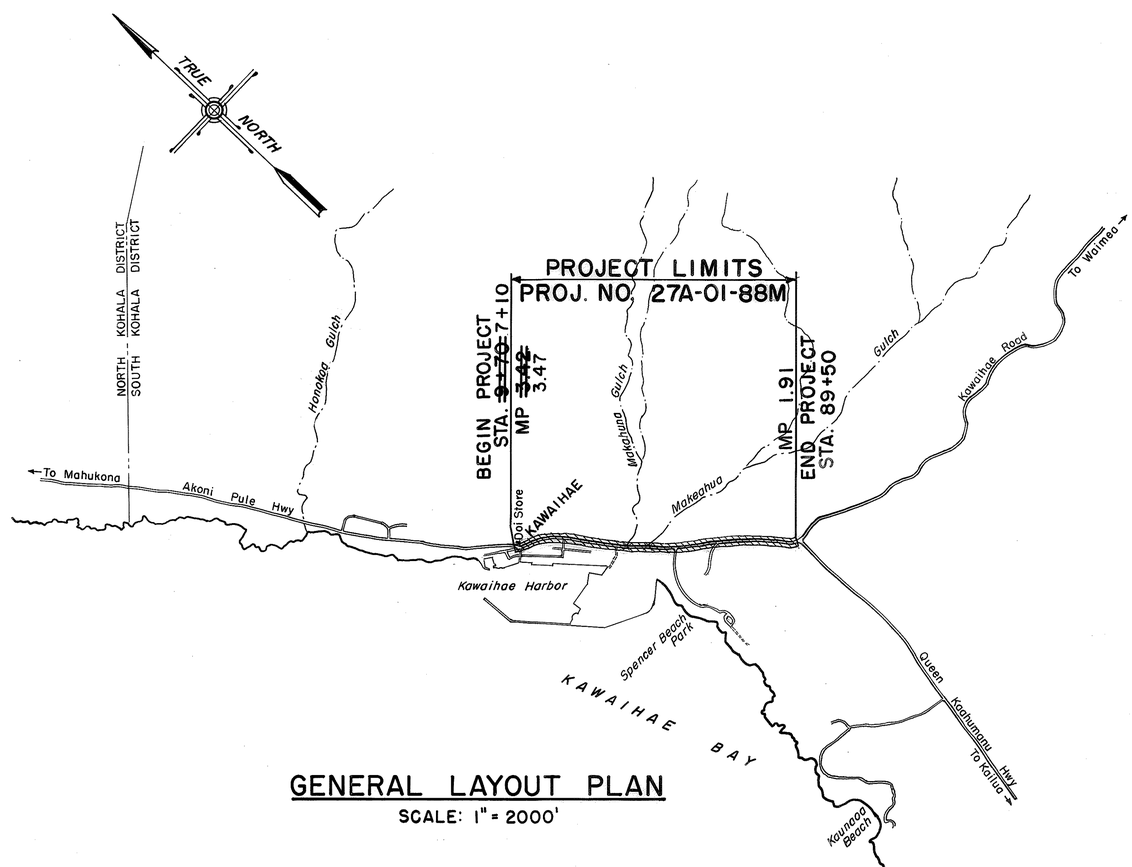

GENERAL LAYOUT PLAN

SCALE: 1" = 2000'

CHANGES MADE DURING CONSTRUCTION HAVE BEEN INCORPORATED ON THESE PLANS EXCEPT CHANGES IN THE ORIGINAL THEORETICAL QUANTITIES. FOR ACTUAL QUANTITIES, REFER TO PROJECT LEDGER AND/OR COMPUTATION BOOK.

Roy Shiroji — RESIDENT ENGINEER

9/24/89 — DATE

DEPARTMENT OF TRANSPORTATION
STATE OF HAWAII

APPROVED:

Edward Hirata — DIR. OF TRANSPORTATION

5/16/89 — DATE

HAWAII DISTRICT

DESIGNED BY ROY T. NAGASAKO — P. S. & E. BY

548-2456 — PHONE

MAY, 1988 — DATE

A-4-7