INDEX TO DRAWINGS	
SHEET NO.	DESCRIPTION
1	TITLE SHEET
2	PLAN & DETAILS
3	PROFILE
4-5	STANDARD DETAILS

STATE OF HAWAII

DEPARTMENT OF TRANSPORTATION

HIGHWAYS DIVISION

"AS BUILT"

PLANS FOR

DRAINAGE IMPROVEMENTS ON KAWAIHAE ROAD

VICINITY OF KAWAIHAE HARBOR

PROJ. NO. 270A-01-76

DISTRICT OF SOUTH KOHALA

ISLAND OF HAWAII

FED. ROAD DIST. NO.	STATE	PROJ. NO.	FISCAL YEAR	SHEET NO.	TOTAL SHEETS
HAWAII	HAW.	270A-01-76	1976	1	5

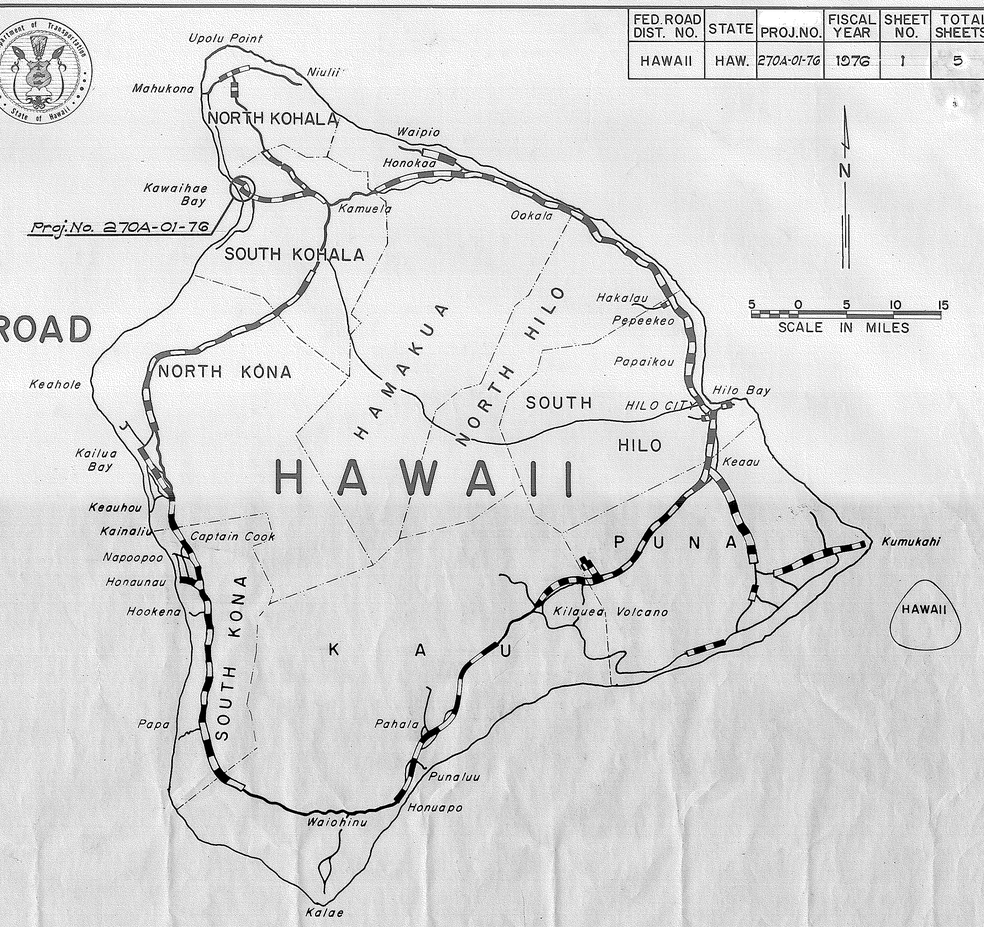

Federal Aid Projects Previously Constructed Or Under Construction

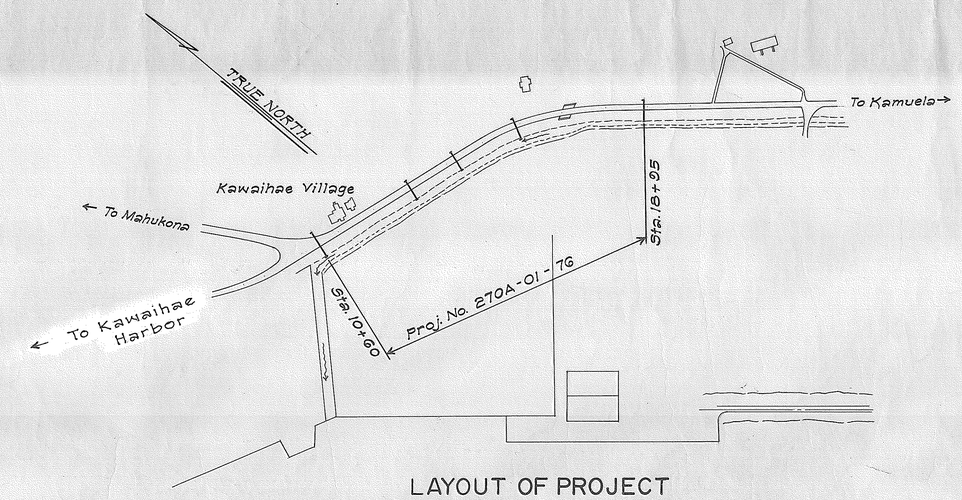

LAYOUT OF PROJECT

SCALE : 1 : 2000

LENGTH OF PROJECT - 0.16 Mile

NOTE:

ALL CHANGES MADE DURING CONSTRUCTION HAVE BEEN INCORPORATED ON THESE PLANS EXCEPT CHANGES IN THE ORIGINAL THEORETICAL QUANTITIES.

PROJECT INSPECTOR

3-9-77
DATE

DEPARTMENT OF TRANSPORTATION
STATE OF HAWAII

APPROVED:

for R Higashionna — DIR. OF TRANSPORTATION — 7/13/76 DATE

E. Ichinotsubo — DESIGNED BY

Roy M. Mikami — P. S. & E. BY

548-7534 — PHONE

Mar. 1976 — DATE

D-1-9