


FED. ROAD DIST. NO.	STATE	FED. AID PROJ. NO.	FISCAL YEAR	SHEET NO.	TOTAL SHEETS
HAWAII	HAW.	RS-STP-0270(II)	1994	10	30

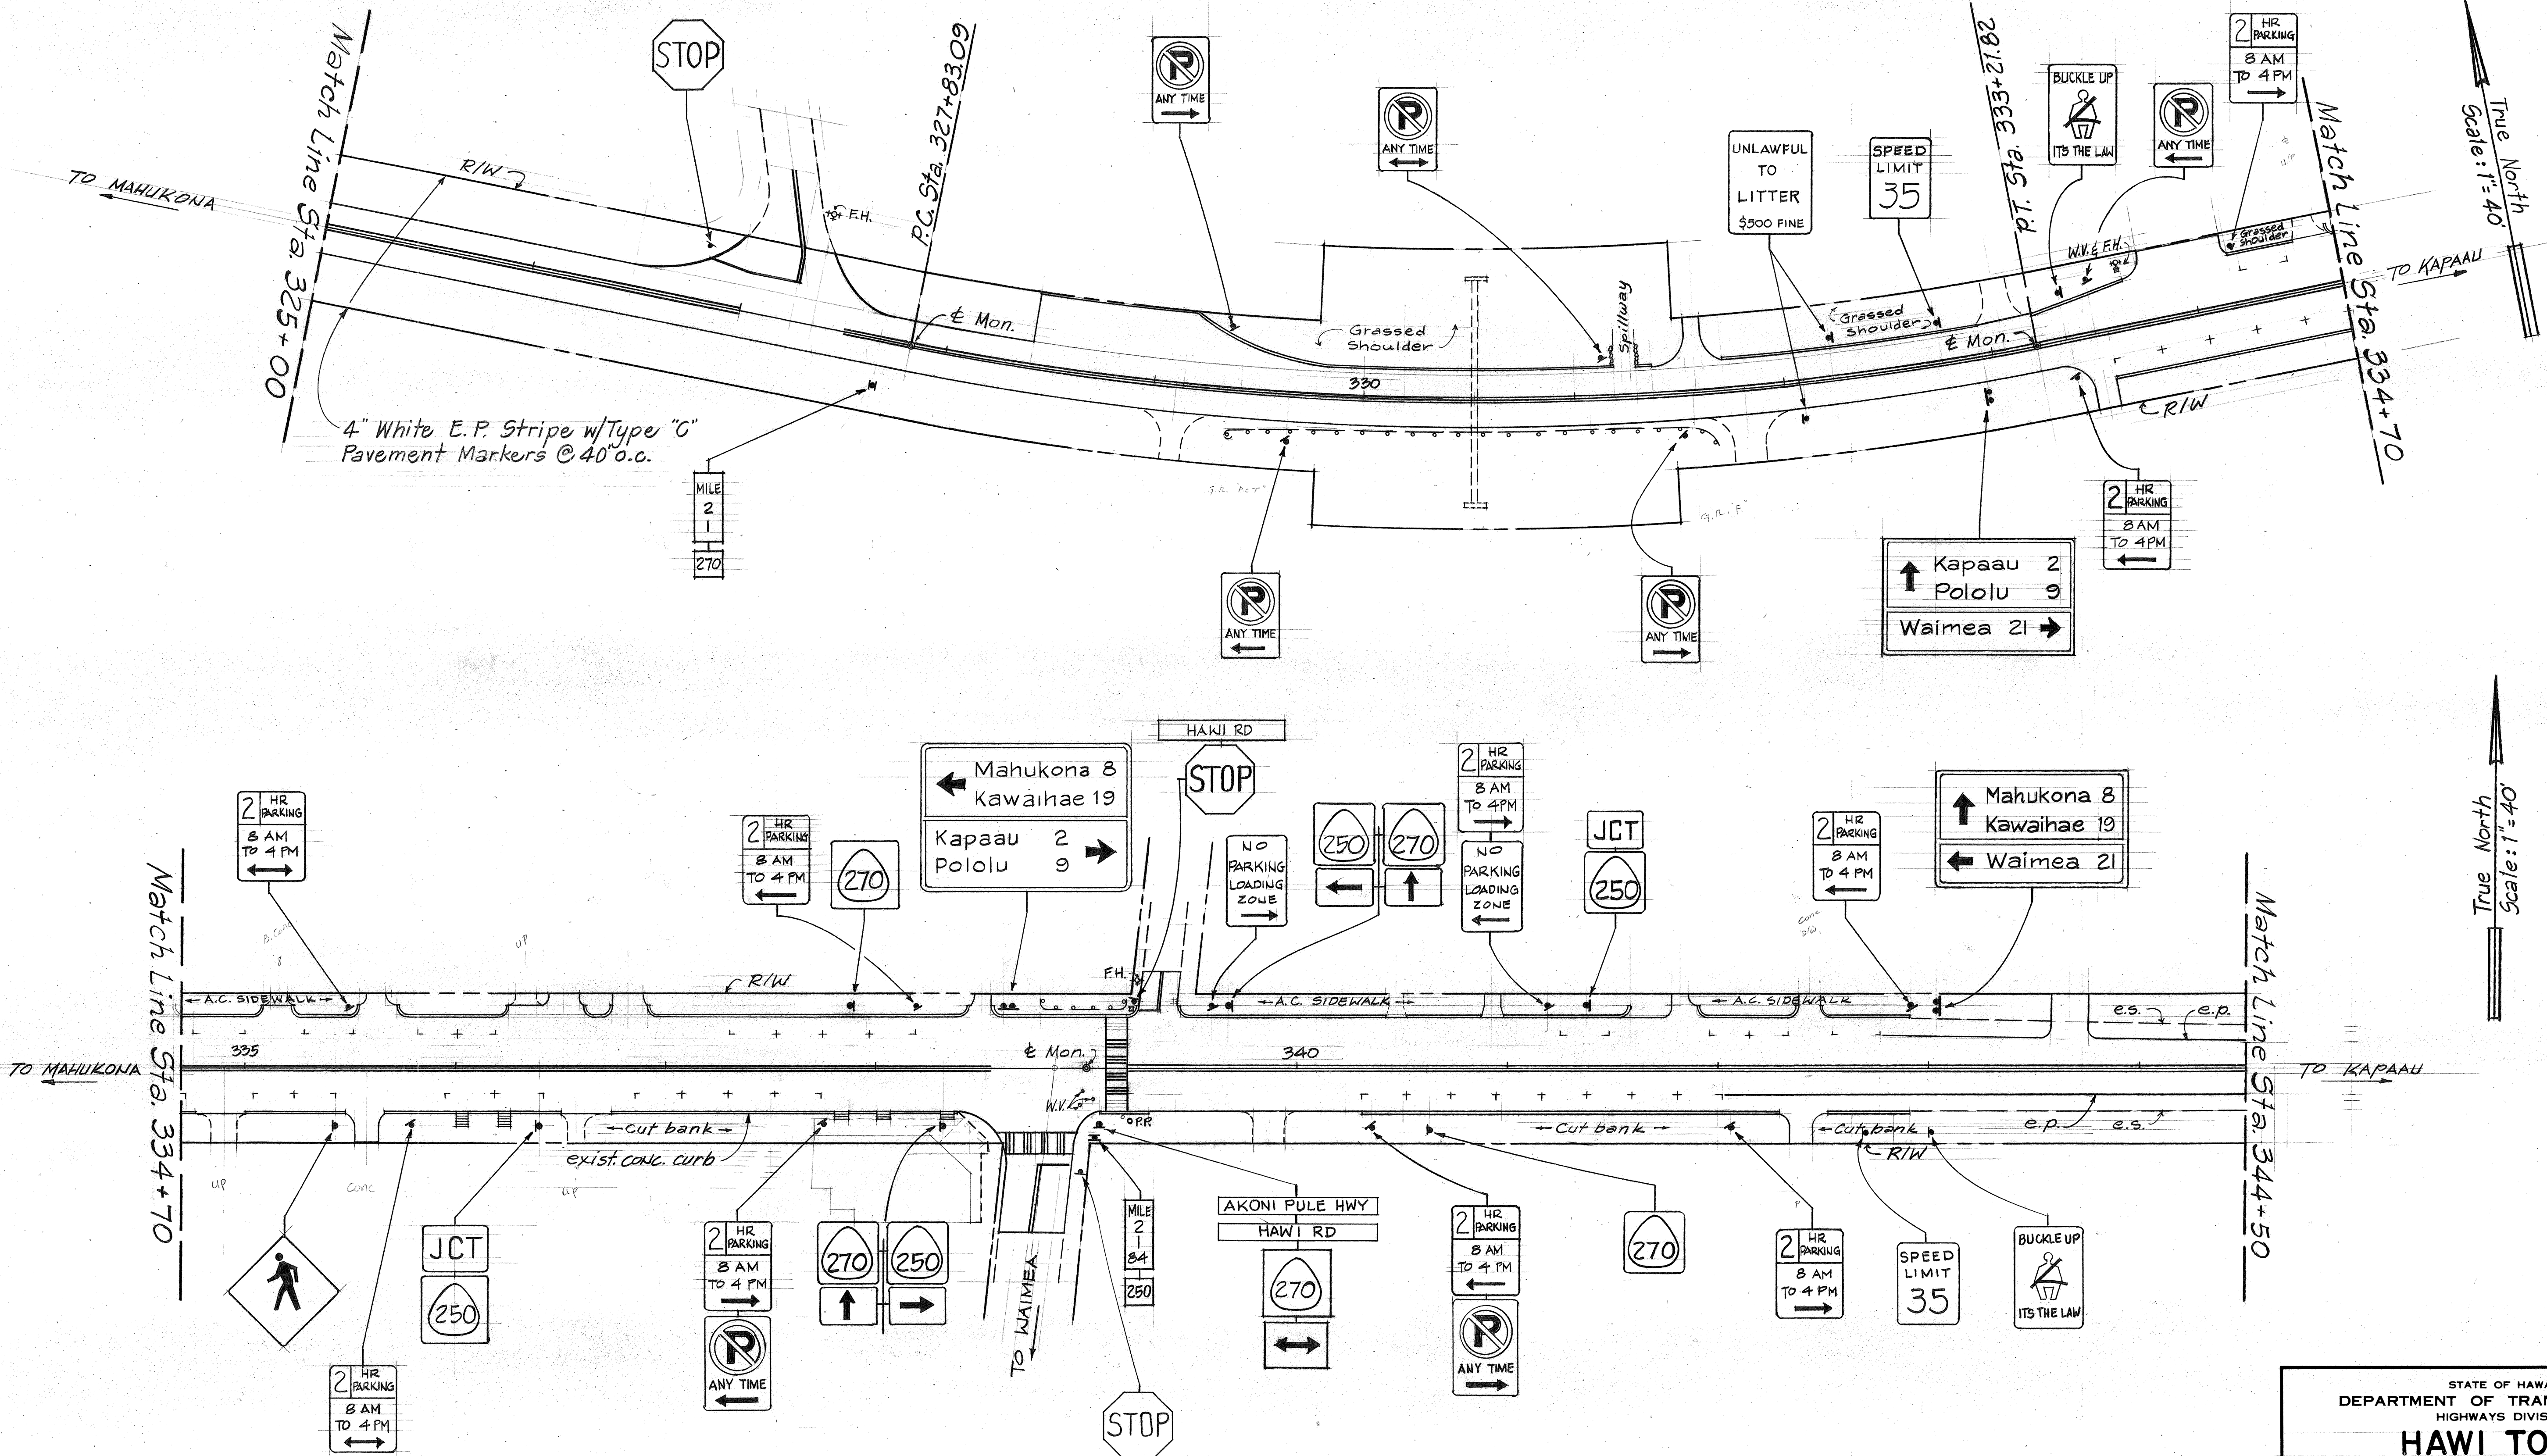

SURVEY PLOTTED BY	DATE
DRAWN BY	
DESIGNED BY	
QUANTITIES BY	
CHECKED BY	
ORIGINAL PLAN	
NOTE BOOK	
NO.	

STATE OF HAWAII
DEPARTMENT OF TRANSPORTATION
HIGHWAYS DIVISION

HAWI TOWN
ENLARGED PLAN
 AKONI PULE HIGHWAY RESURFACING
 KOKOIKE TO AINAKEA SUBDIVISION
 F.A. PROJECT NO. RS-STP-0270(II)

Scale: 1"=100'
 Date: August 1994
 SHEET NO. 1 OF 1 SHEETS