FED. ROAD DIST. NO.	STATE	FED. AID PROJ. NO.	FISCAL YEAR	SHEET NO.	TOTAL SHEETS
HAWAII	HAW.	F.S. 18(1)	1948	2	22

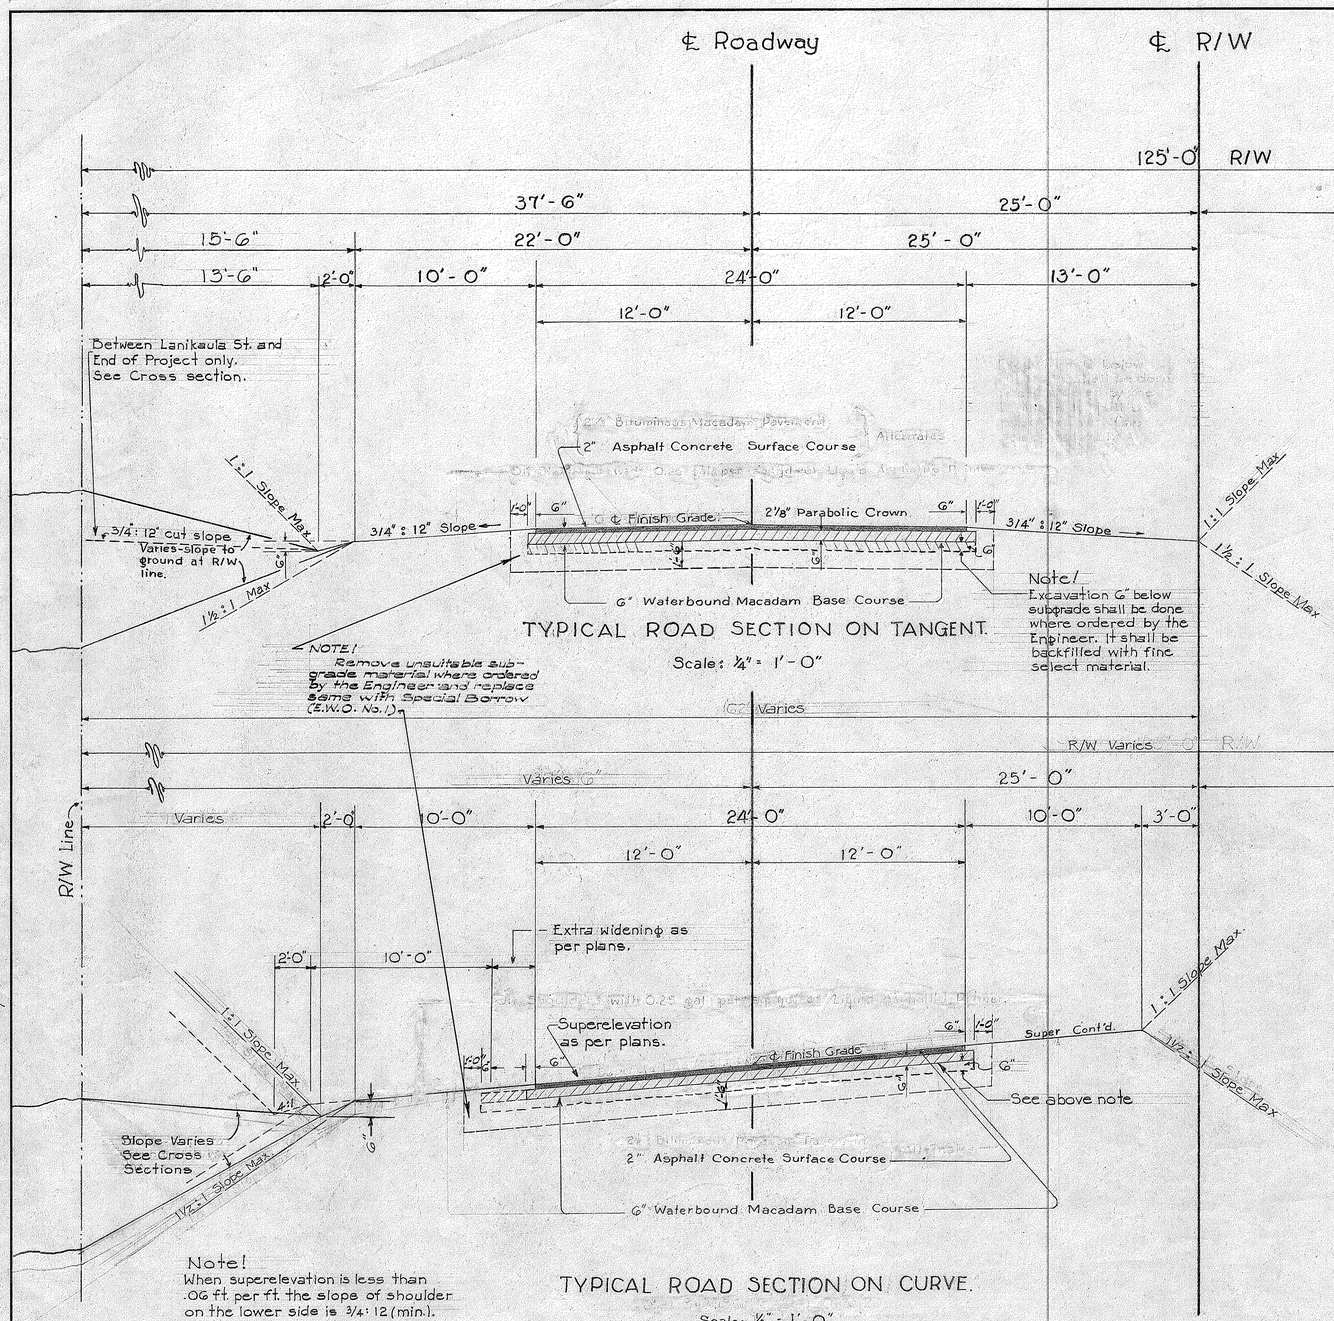

GENERAL NOTES

PAVEMENT: Pavement shall be Asphalt Concrete Surface Course 2" thick when fully compacted. Use Mix No. III.

BASE COURSE: Base Course shall be 6" thick Waterbound Macadam Base Course placed in two layers each of 3" compacted thickness and consisting of Mineral Aggregate (Coarse Rock No. 3 (2"-3/4")) filled with Filler (1/2"-#100).

PRIMER: A prime coat of liquid asphaltic primer shall be applied to the surface of the base course at the rate of 0.35 gal. per sq. yd. before placing the 2" A.C. Surface Course.

Both above courses are subject to Specifications and Special Provisions.

Correction Noted May 17, 1948 April 48

ORIGINAL PLAN	SURVEY PLOTTED BY	DATE
	DESIGNED BY	
	DRAWN BY	
	TRACED BY	
NOTE BOOK	QUANTITIES BY	
No.	QUANTITIES CHECKED BY	
	CHECKED BY	

TERRITORIAL HIGHWAY DEPARTMENT
TERRITORY OF HAWAII

WAIAKEA CUTOFF
PROJ. No. F.A.S. 18(1)

Scale: 1/4" = 1'-0" Noted

June 1947

SHEET No. 1 OF 1 SHEETS

5285.2

"ALBANENE" No. 1007 K & E CO., N. Y. 8