



PLAN	DATE	BY
SURVEYED		
PLOTTED		
NOTE BOOK		
NO.		

PROFILE	DATE	BY
SURVEYED		
PLOTTED		
NOTE BOOK		
NO.		

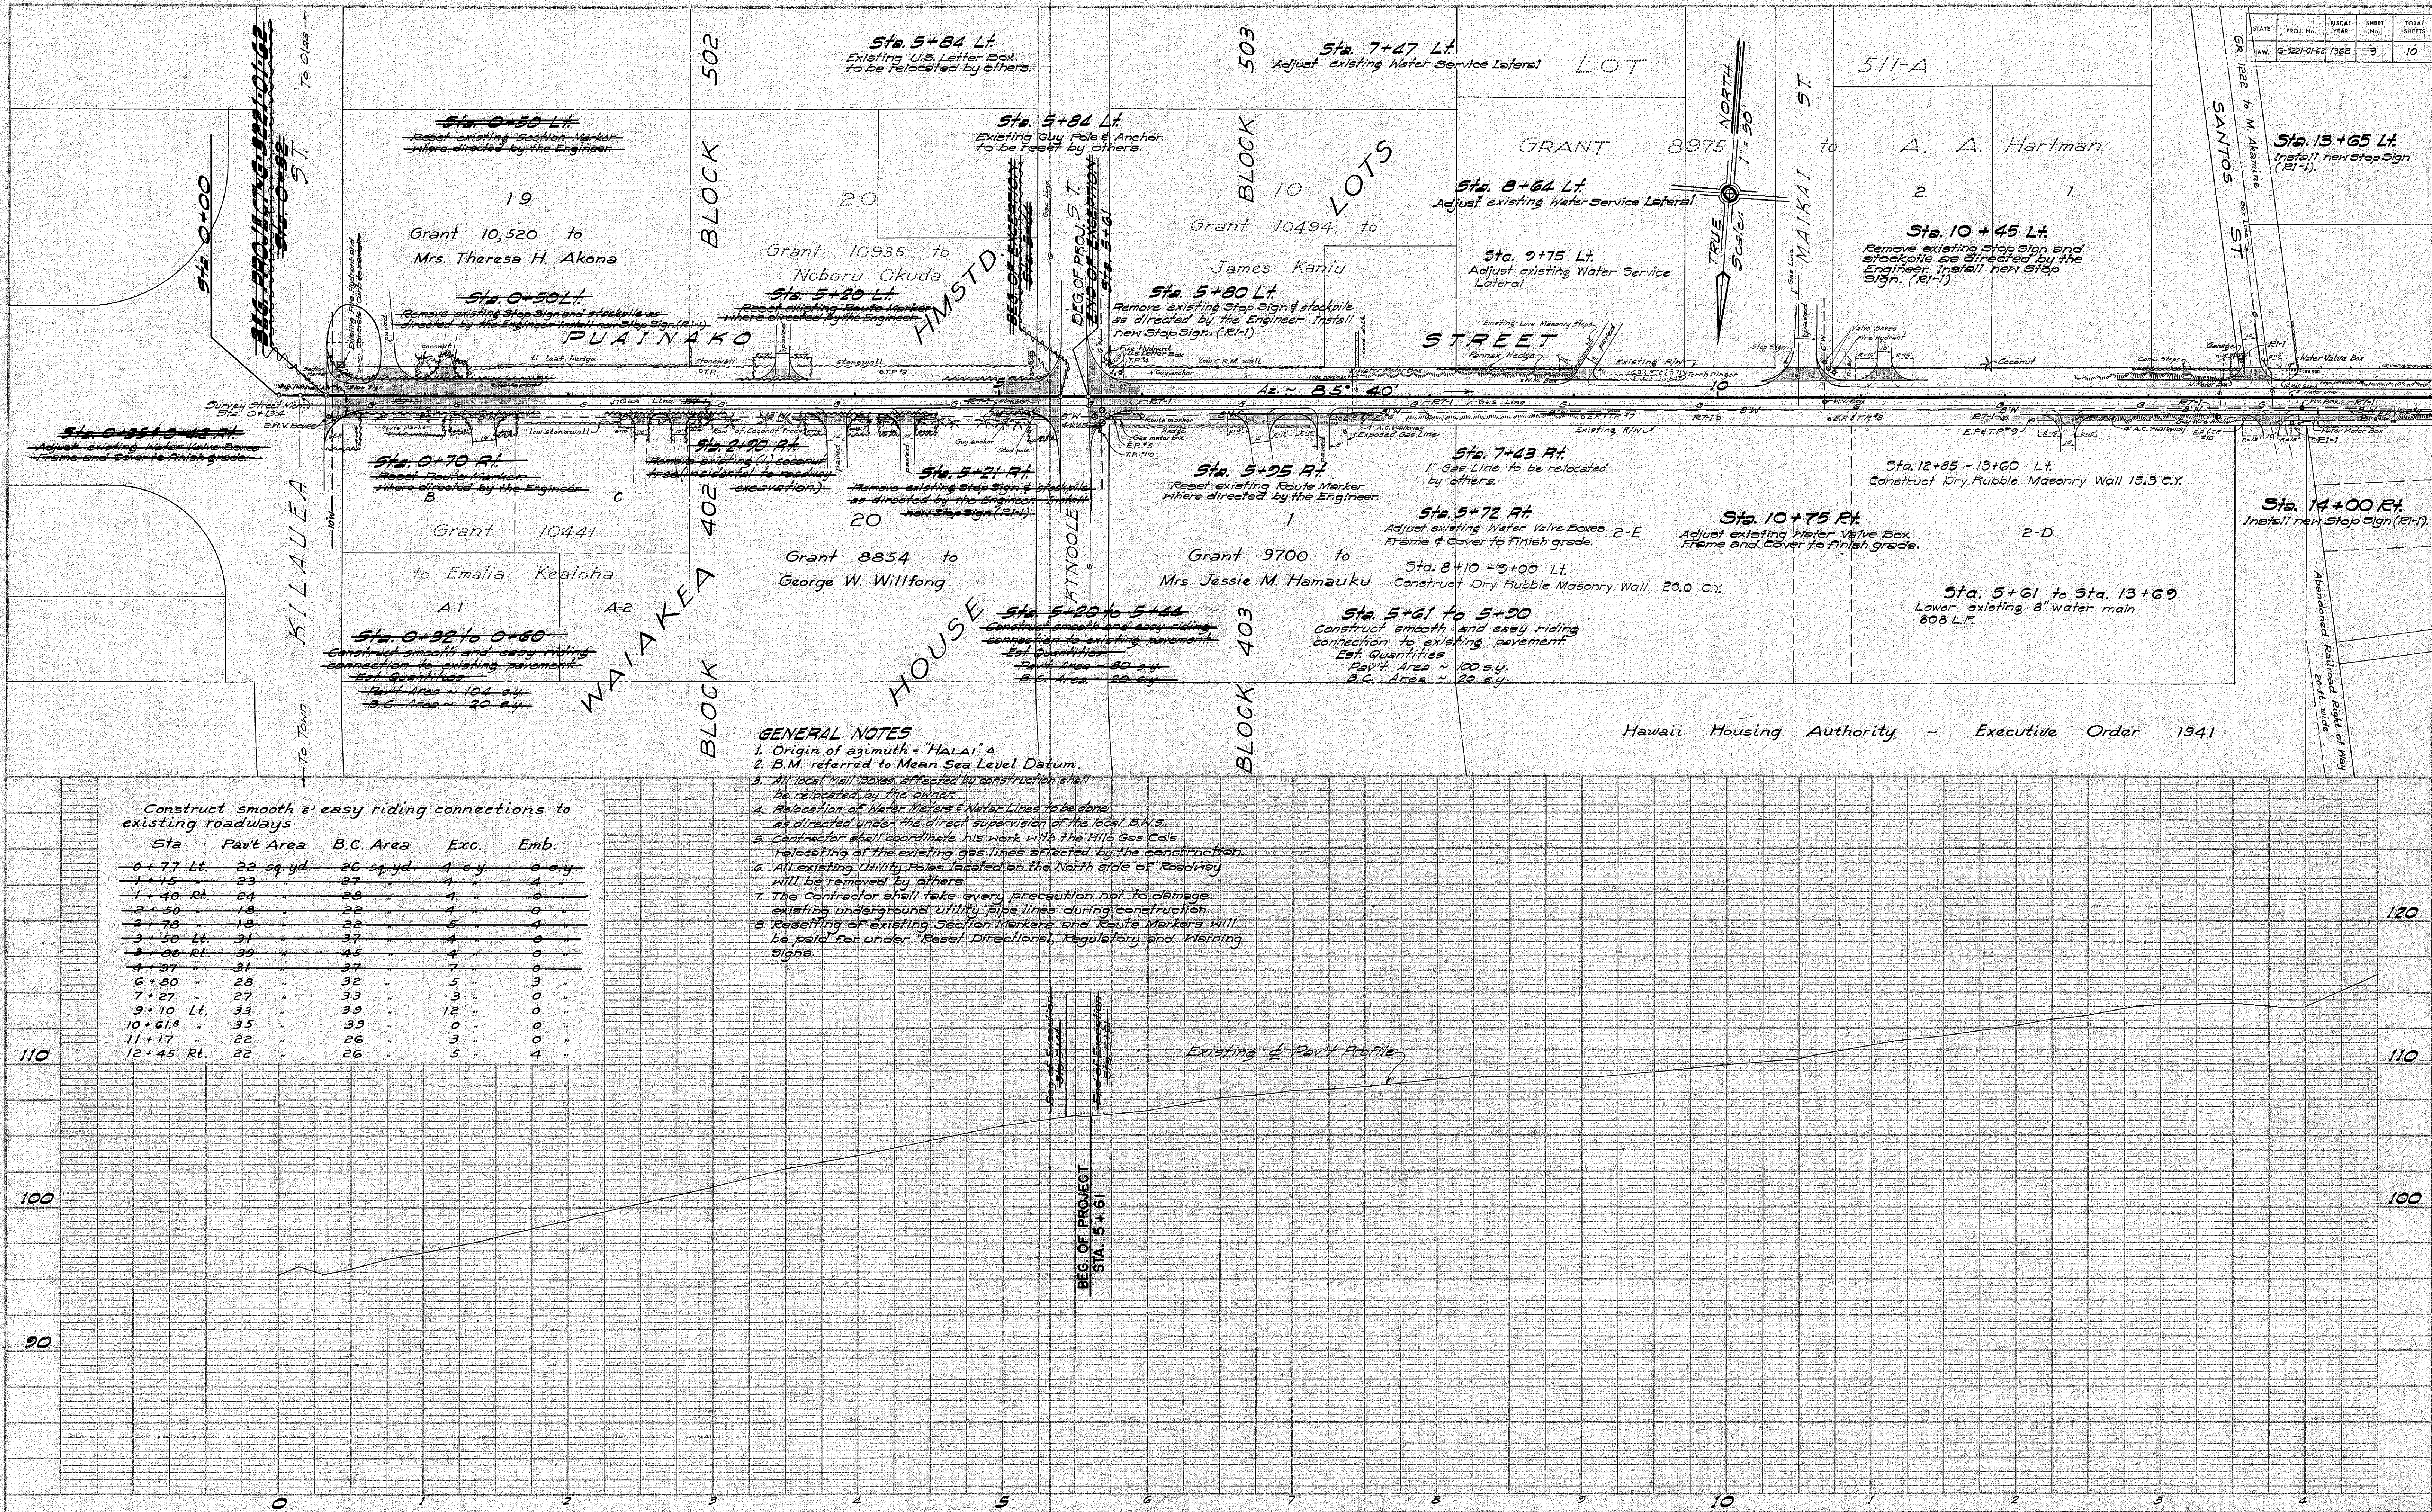


DATE
BY
SURVEYED
PLOTTER
NOTE BOOK
RT. OF WAY CHECKED
NO.

DATE
BY
PROFILE
SURVEYED
PLOTTER
NOTE BOOK
GRADES CHECKED
S. M. & NOTED
STRUCTURE NOTED IN CH. NO.

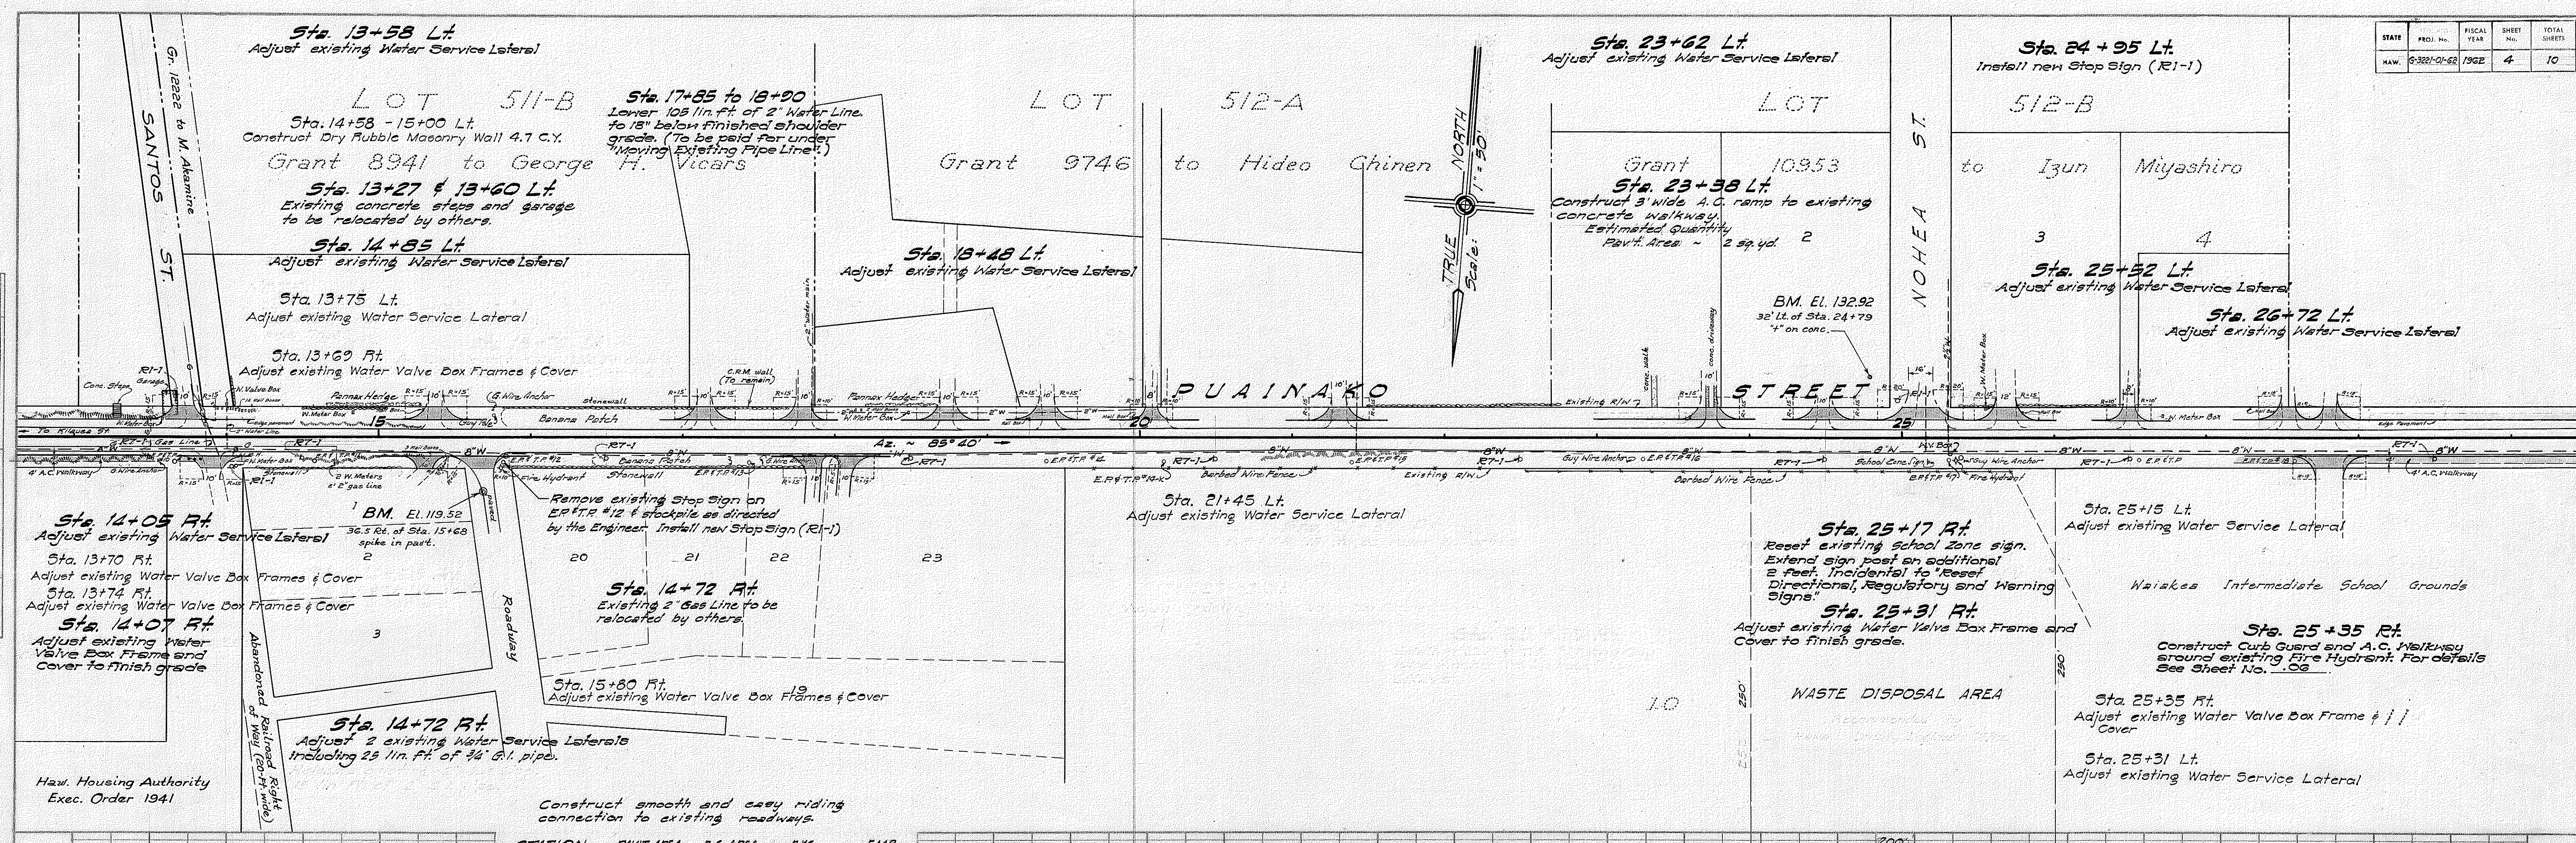

STATION	PAVT. AREA	B.C. AREA	ENC.	EMB.
13+77 Lt.	22 S.Y.	26 S.Y.	7 C.Y.	7 C.Y.
13+86 Rt.	22 S.Y.	26 S.Y.	3 "	0 "
13+32 Rt.	14 S.Y.	18 S.Y.	8 "	4 "
13+36 Lt.	22 S.Y.	26 S.Y.	4 "	4 "
13+68 Rt.	30 S.Y.	37 S.Y.	10 C.Y.	0 "
17+12 Lt.	22 S.Y.	26 S.Y.	7 "	4 "
17+80 Lt.	2 S.Y.	9 S.Y.	9 "	0 "
17+90 Rt.	18 S.Y.	22 S.Y.	2 "	0 "
18+08 Rt.	18 S.Y.	22 S.Y.	2 "	0 "
18+73 Lt.	22 S.Y.	26 S.Y.	3 "	2 "
19+42 Lt.	22 S.Y.	26 S.Y.	2 "	0 "
20+08 "	15 S.Y.	19 S.Y.	7 "	3 "
21+31 "	22 S.Y.	26 S.Y.	2 "	4 "
23+73 "	17 S.Y.	21 S.Y.	2 "	0 "
24+50 "	22 S.Y.	26 S.Y.	4 "	4 "
25+12 "	37 S.Y.	41 S.Y.	0 "	6 "
25+70 "	24 S.Y.	28 S.Y.	2 "	0 "
26+30 "	13 S.Y.	17 S.Y.	0 "	4 "

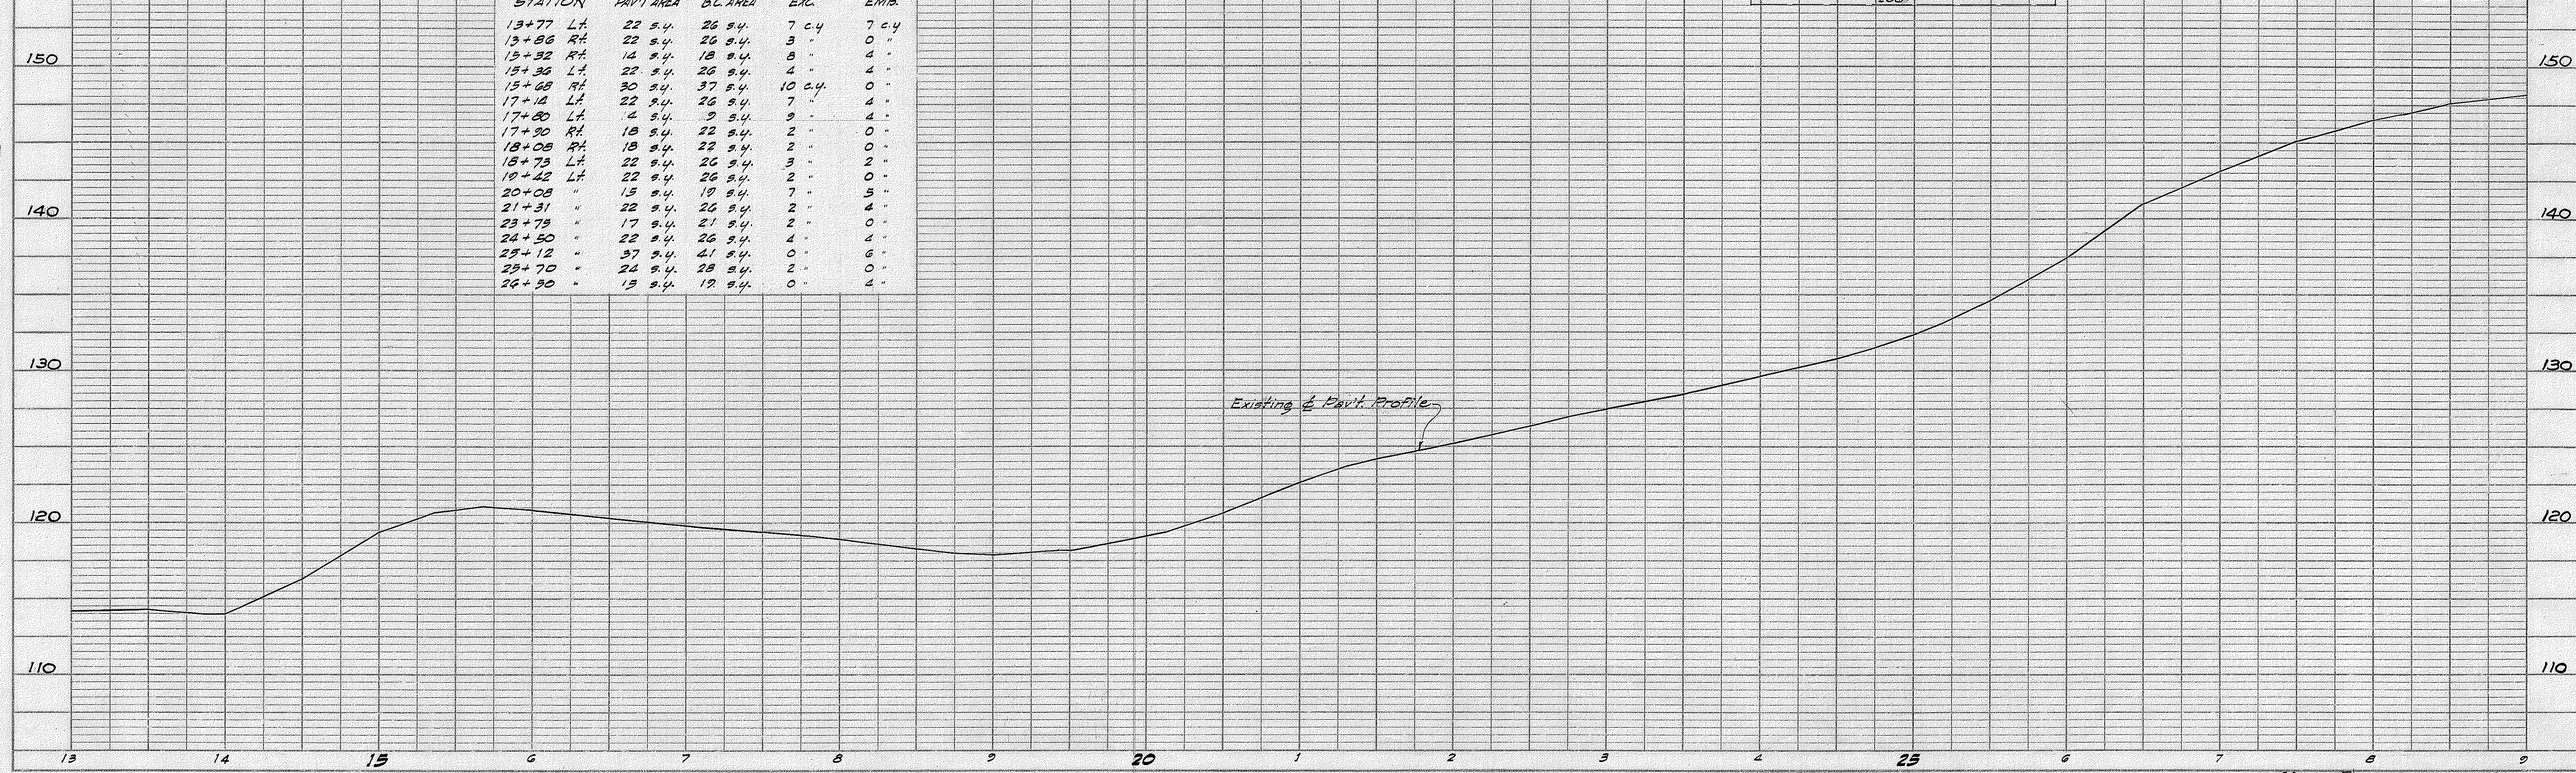

STATE	PROJ. No.	FISCAL YEAR	SHEET No.	TOTAL SHEETS
HAW.	3-3221-01-62	1962	5	10

PLAN	DATE	BY
SURVEYED		
PLOTTED		
NOTE BOOK		
NO.		

PROFILE	DATE	BY
SURVEYED		
PLOTTED		
NOTE BOOK		
NO.		

