FED. ROAD DIST. NO.	STATE	FED. AID PROJ. NO.	FISCAL YEAR	SHEET NO.	TOTAL SHEETS
Hawaii	HAW	12-J	1938	1	60

REVISED 3/30/38

INDEX TO DRAWINGS	
SHEET NO.	DESCRIPTION
1	Title Sheet.
2-3	Typical Sections.
4-12	Plan & Profile.
13-14	Standard Road Details.
15-17	Culverts, Syphons & Miscellaneous Details.
18	30½" Semicircular Metal Flume
19-20	Highway Overpass.
21-33	Bridge Details.
34-60	Cross Sections.

TERRITORY OF HAWAII

TERRITORIAL HIGHWAY DEPARTMENT

HONOLULU, T.H.

PLANS OF

KAUAI BELT ROAD

FEDERAL AID PROJECT NO. 12 J

DISTRICTS OF KOLOA AND WAIMEA

ISLAND OF KAUAI

CONVENTIONAL SIGNS

Stone wall
Wire fence
Existing road
℄ New Highway
Culverts
Water main
Sewer main
Railroad
Bridge

SCALES

PLAN		1 INCH = 100 FEET
PROFILE	HOR.	1 INCH = 100 FEET
	VERT.	1 INCH = 10 FEET
CROSS SECTIONS		1 INCH = 10 FEET

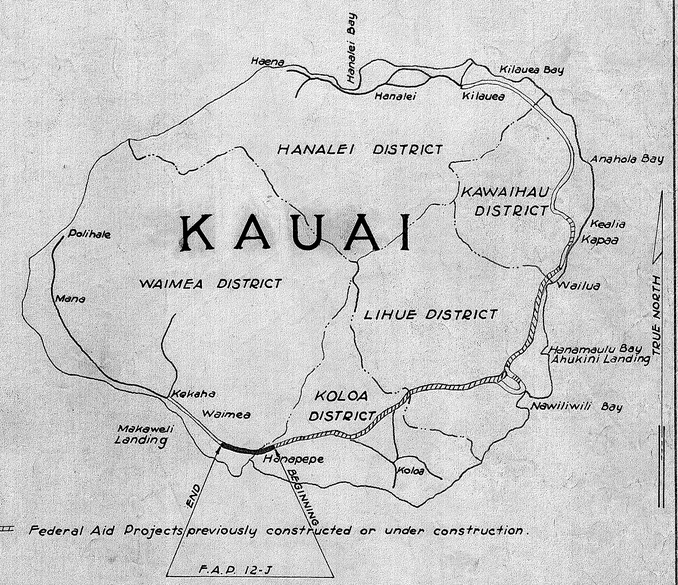

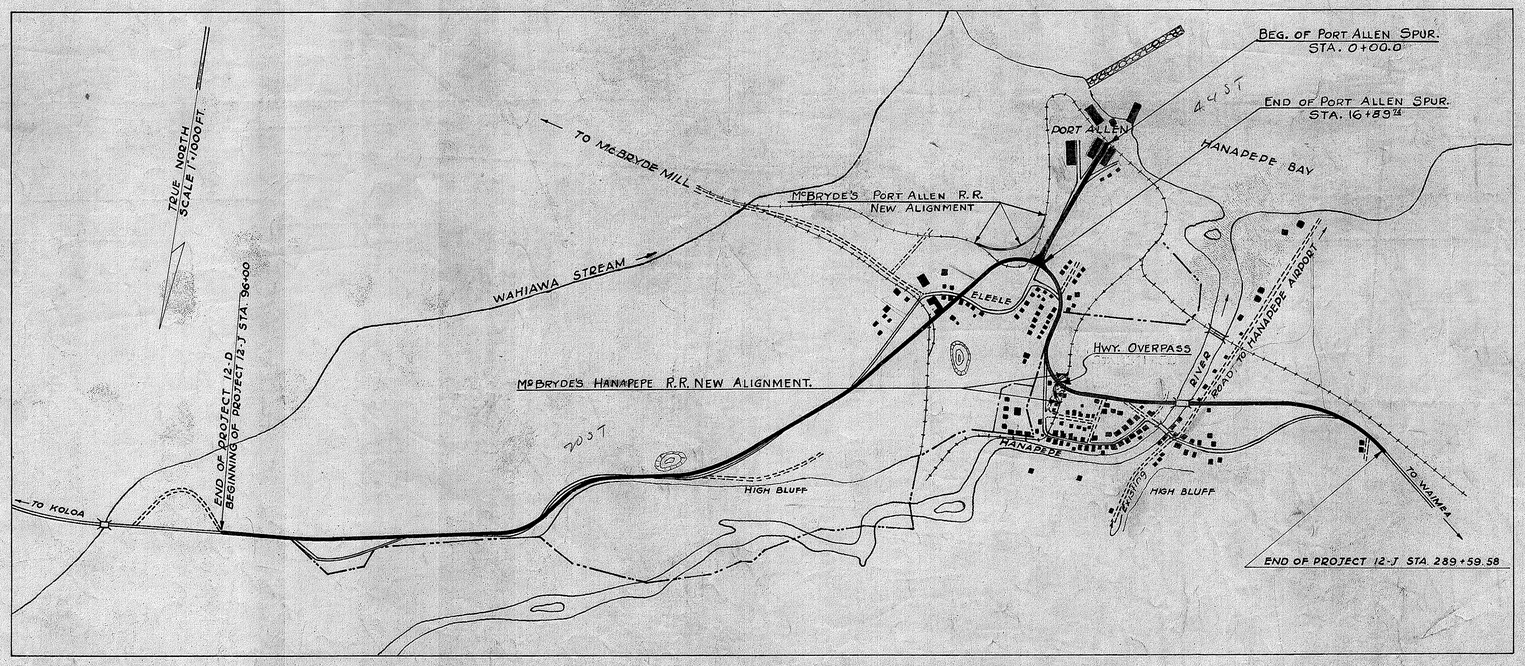

LAYOUT OF PROJECT

SCALE 1 INCH = 1000 FEET

GROSS LENGTH	= 3.971 Mi.
BRIDGES OVER 20'-0" SPAN	= 0.053 Mi.
NET LENGTH	= 3.918 Mi.

ORIGINAL PLAN	SURVEY PLOTTED BY	R.M.S.
	DRAWN BY	"
	TRACED BY	R.M.S.
NOTE BOOK	CHECKED BY	"
No.	QUANTITIES BY	"
	CHIEF ENG'R	"

APPROVED

Louis E. Cain
Date
Territorial Highway Engineer

RECOMMENDED FOR APPROVAL

Principal Highway Engr. Bureau of Pub. Rds.

RECOMMENDED FOR APPROVAL

Chief Engineer, Bureau of Pub. Roads.

APPROVED

Chief, Bureau of Public Roads.

4438.1