DIST. NO.	STATE	PROJ. NO.	FISCAL YEAR	SHEET NO.	TOTAL SHEETS
HAWAII	HAW.	50B-01-74 550B-01-74	1974	1	2

INDEX TO DRAWINGS

SHEET NO.	DESCRIPTION
1	TITLE SHEET
2	TYPICAL SECTIONS

STATE OF HAWAII

DEPARTMENT OF TRANSPORTATION

HIGHWAYS DIVISION

"AS BUILT"

PLANS FOR

KAUMUALII HIGHWAY, RESURFACING
KAUMAKANI TO HANAPEPE

PROJECT NO. 50B-01-74

KOKEE ROAD, RESURFACING, PHASE II

PROJECT NO. 550B-01-74

DISTRICT OF WAIMEA
ISLAND OF KAUAI

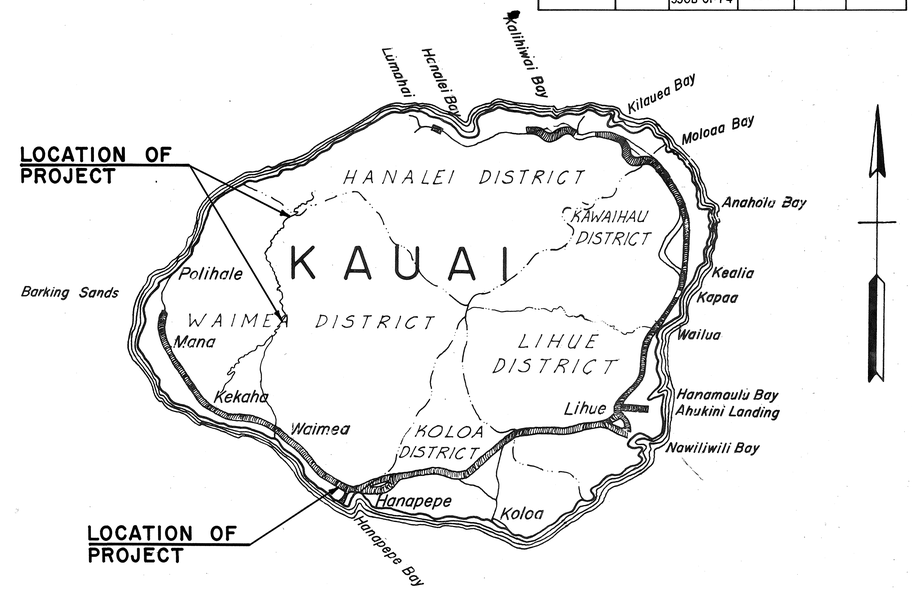

FEDERAL AID PROJECTS PREVIOUSLY CONSTRUCTED OR UNDER CONSTRUCTION

Kauai District
Designed By

Sept. 1973 Date

548-7537 Phone-Loc

A. Nishimura PS&E By

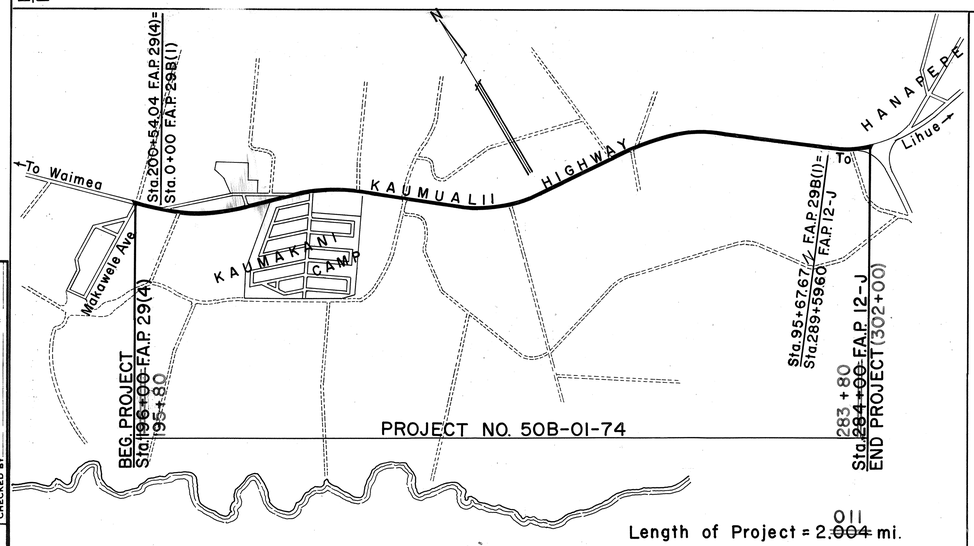

Length of Project = 2.~~004~~ 011 mi.

KAUMUALII HIGHWAY
Scale: 1" = 1000'

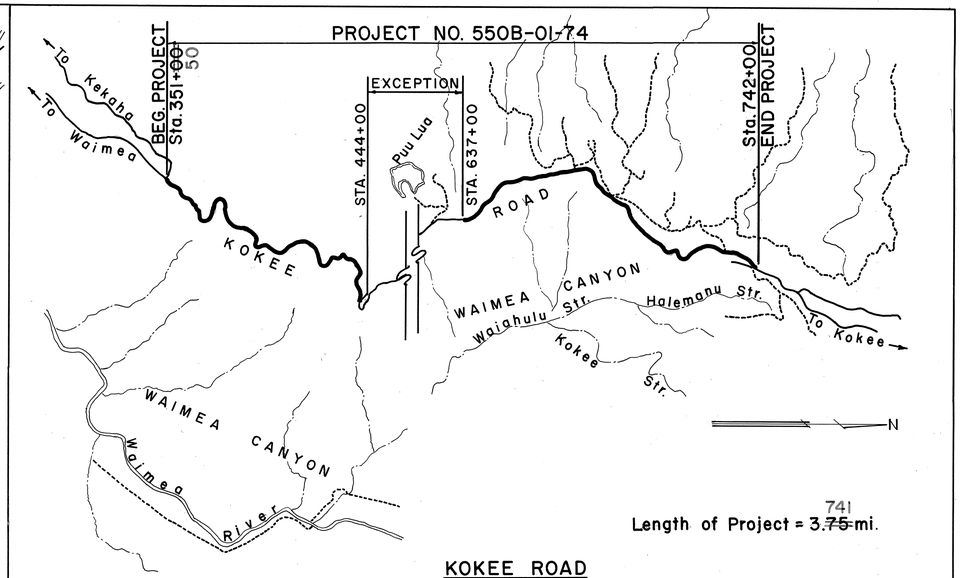

Length of Project = 3.~~75~~ 741 mi.

KOKEE ROAD
Scale: 1" = 2000'

LAYOUT OF PROJECTS

ALL CHANGES MADE DURING CONSTRUCTION HAVE BEEN INCORPORATED ON THESE PLANS IN RED EXCEPT CHANGES IN THE ORIGINAL THEORETICAL QUANTITIES. FOR ACTUAL QUANTITIES, REFER TO PROJECT LEDGER AND/OR COMPUTATION BOOK.

RESIDENT ENGINEER — DATE 6-1-81

DEPARTMENT OF TRANSPORTATION
STATE OF HAWAII
APPROVED:
FOR DIR. OF TRANSPORTATION — DATE 10/17/73

ORIGINAL PLAN	SURVEY PLOTTED BY	DATE
	DESIGNED BY	
	DRAWN BY	
	TRACED BY	
NOTE BOOK No.	QUANTITIES BY	
	QUANTITIES CHECKED BY	
	CHECKED BY	

NTED ON HELTZEN 150M AGEPROOF