FED. ROAD DIST. NO.	STATE	PROJ. NO.	FISCAL YEAR	SHEET NO.	TOTAL SHEETS
HAWAII	HAW.	LT-K-04-78	1978	1	6

INDEX TO DRAWINGS

SHEET NO.	DESCRIPTION
1	TITLE SHEET
2	TYPICAL SECTION & GENERAL NOTES
3-5	PLANS
6	STANDARD DETAILS

STATE OF HAWAII

DEPARTMENT OF TRANSPORTATION

LAND TRANSPORTATION FACILITIES DIVISION

AS-BUILT

PLANS FOR

KAUAI BELT ROAD SHOULDER STABILIZATION

PUHI TOWARDS KAPAA

PROJECT NO. LT-K-04-78

DISTRICT OF LIHUE

ISLAND OF KAUAI

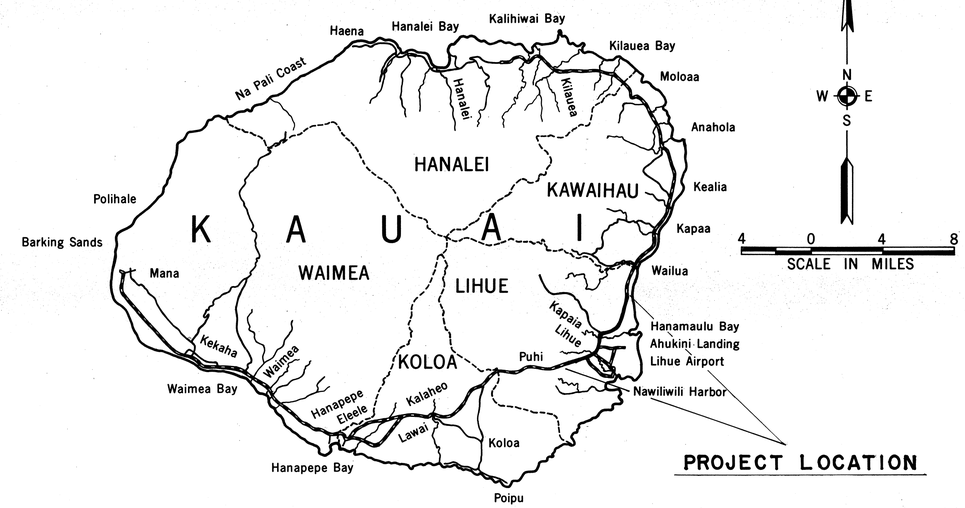

FEDERAL AID PROJECTS PREVIOUSLY CONSTRUCTED OR UNDER CONSTRUCTION

ALL CHANGES MADE DURING CONSTRUCTION HAVE BEEN NOTED IN RED ON THESE TRACINGS AND CHECKED BY

RESIDENT ENGINEER — 2-21-79 DATE

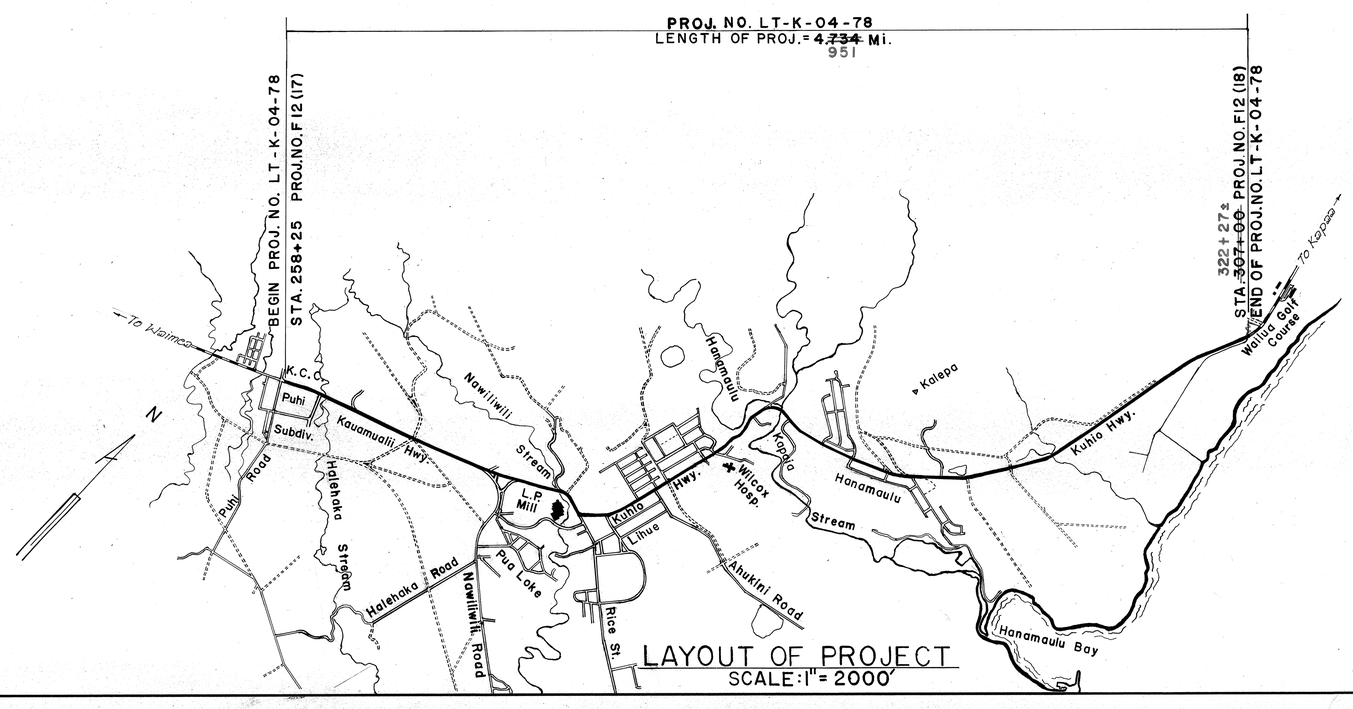

LAYOUT OF PROJECT
SCALE: 1" = 2000'

KAUAI DISTRICT — DESIGNED BY
ALLAN NISHIMURA — P. S. & E. BY
548-7537 — PHONE
Feb., 1978 — DATE

DEPARTMENT OF TRANSPORTATION
STATE OF HAWAII

APPROVED:

Ryokichi Higashionna — April 5, 78
DIR. OF TRANSPORTATION — DATE

1-5-8