FED. ROAD DIST. NO.	STATE	FED. AID PROJ. NO.	FISCAL YEAR	SHEET NO.	TOTAL SHEETS
HAWAII	HAW.	DP-056-1(27)	1980	1	18

INDEX TO DRAWINGS

SHEET NO.	DESCRIPTION
1	TITLE SHEET
2	TRAFFIC CONTROL PLAN AND NOTES
3	GEOMETRICS AND STRIPING PLAN
4	TRAFFIC SIGNAL PLAN
5	MISCELLANEOUS DETAILS
6-18	STANDARD DETAILS

STATE OF HAWAII

DEPARTMENT OF TRANSPORTATION

HIGHWAYS DIVISION

HONOLULU, HAWAII

"AS-BUILT"

PLANS FOR

KUHIO HIGHWAY

TRAFFIC SIGNALS AT KAUMUALII HIGHWAY

FEDERAL AID PROJECT NO. DP-056-1(27)

DISTRICT OF LIHUE

ISLAND OF KAUAI

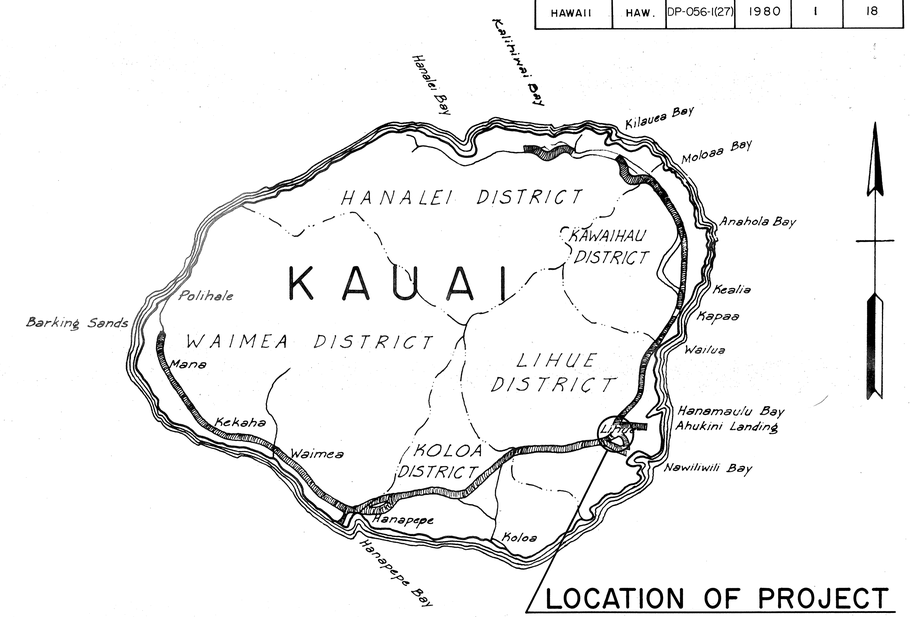

LOCATION OF PROJECT

FEDERAL AID PROJECTS PREVIOUSLY CONSTRUCTED OR UNDER CONSTRUCTION

ALL CHANGES MADE DURING CONSTRUCTION HAVE BEEN INCORPORATED ON THESE PLANS IN RED EXCEPT CHANGES IN THE ORIGINAL THEORETICAL QUANTITIES. FOR ACTUAL QUANTITIES, REFER TO PROJECT LEDGER AND/OR COMPUTATION BOOK.

Donald Nagamine — RESIDENT ENGINEER

4-12-82 — DATE

DESIGN CLASSIFICATION	
ADT (1980)	16,820
ADT (2000)	28,060
DHV	2,505
D	60/40
T	6.5 %
T_{24}	6.0 %
V	25 MPH

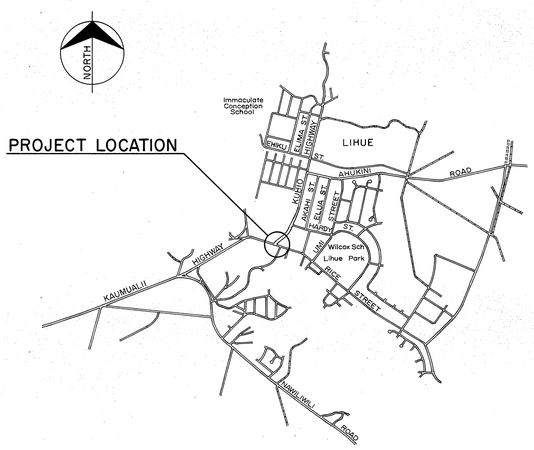

LAYOUT PLAN

2000 0 2000 4000 6000

SCALE IN FEET

ORIGINAL PLAN	SURVEY PLOTTED BY	DATE
	DESIGNED BY	
	DRAWN BY	
	TRACED BY	
NOTE BOOK No.	QUANTITIES BY	
	QUANTITIES CHECKED BY	
	CHECKED BY	

AUSTIN, TSUTSUMI, & ASSOC., INC.
ENGINEERS · SURVEYORS · HAWAII · GUAM

DESIGNED BY — JAMES SUGIHARA, P. S. & E. BY — 548-6932 PHONE — APR. 30, 1980 DATE

DEPARTMENT OF TRANSPORTATION

APPROVED: [signature] — DIVISION ADMINISTRATOR — 5.19.80 DATE

DEPARTMENT OF TRANSPORTATION
STATE OF HAWAII

APPROVED: Ryokichi Higashiona — DIR. OF TRANSPORTATION — May 8, 1980 DATE

PRINTED ON WILTGEN 192M AGEPROOF