| FED. ROAD DIST. NO. | STATE | FED. AID PROJ. NO. | FISCAL YEAR | SHEET NO. | TOTAL SHEETS |
|---|---|---|---|---|---|
| HAWAII | HAW. | F-058-1(1) | 1990 | 20 | 29 |

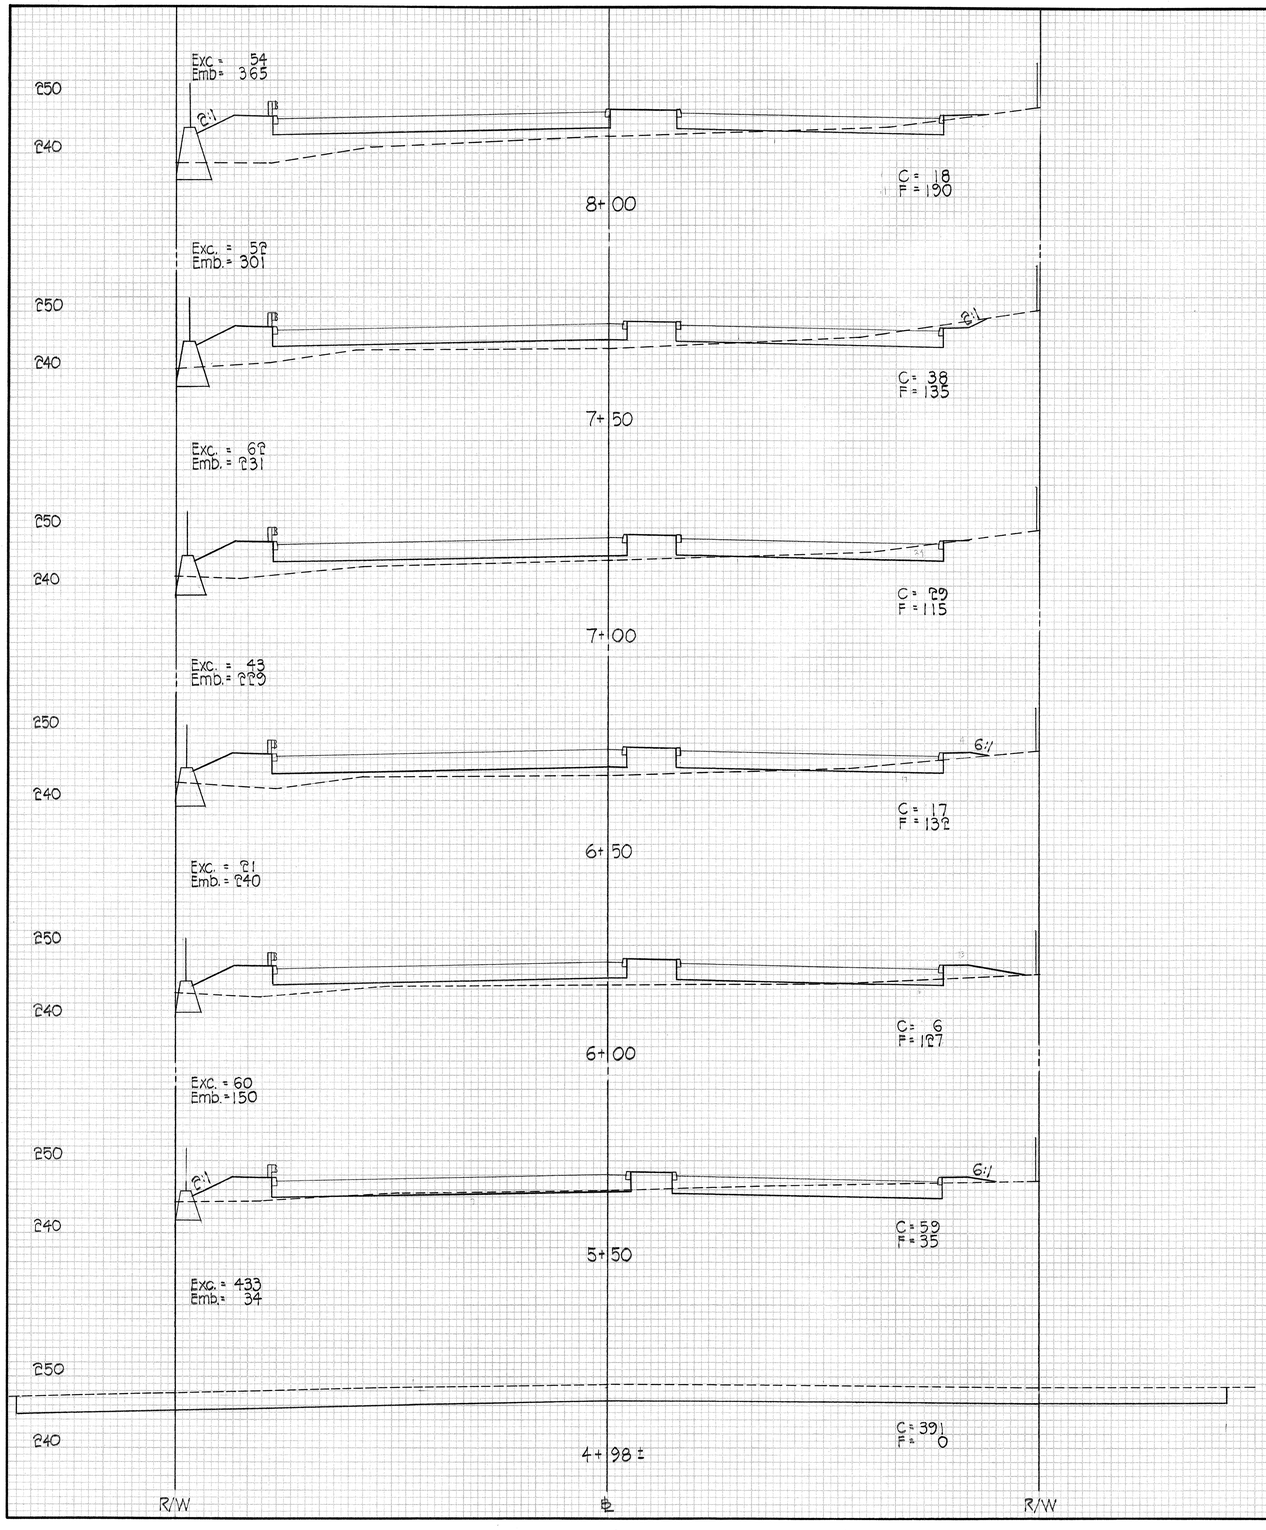


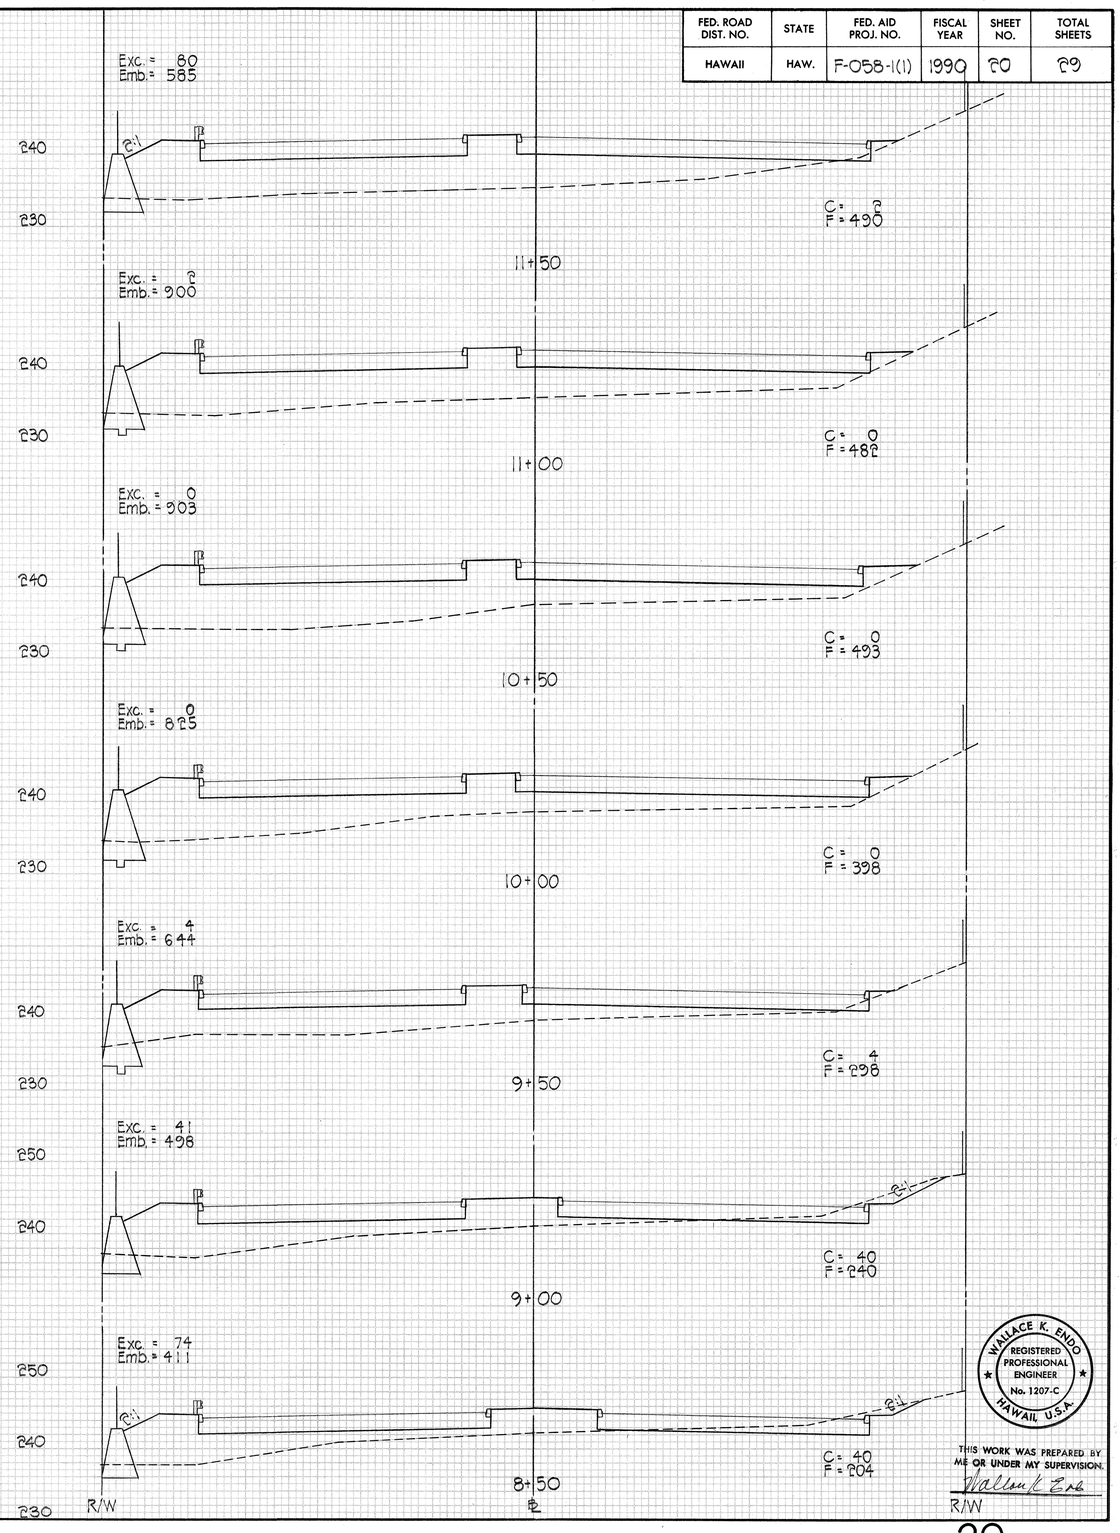


ORIGINAL SURVEY — SURVEYED, PLOTTED, NOTE BOOK, TEMPLATE, AREAS, AREAS CHECKED, NO. — BY — DATE

FINAL SURVEY — SURVEYED, PLOTTED, NOTE BOOK, TEMPLATE, AREAS, AREAS CHECKED, NO. — BY — DATE

WALLACE K. ENDO
REGISTERED PROFESSIONAL ENGINEER
No. 1207-C
HAWAII, U.S.A.

THIS WORK WAS PREPARED BY ME OR UNDER MY SUPERVISION.
Wallace K. Endo

| FED. ROAD DIST. NO. | STATE | FED. AID PROJ. NO. | FISCAL YEAR | SHEET NO. | TOTAL SHEETS |
|---|---|---|---|---|---|
| HAWAII | HAW. | F-058-1(1) | 1990 | 21 | 69 |

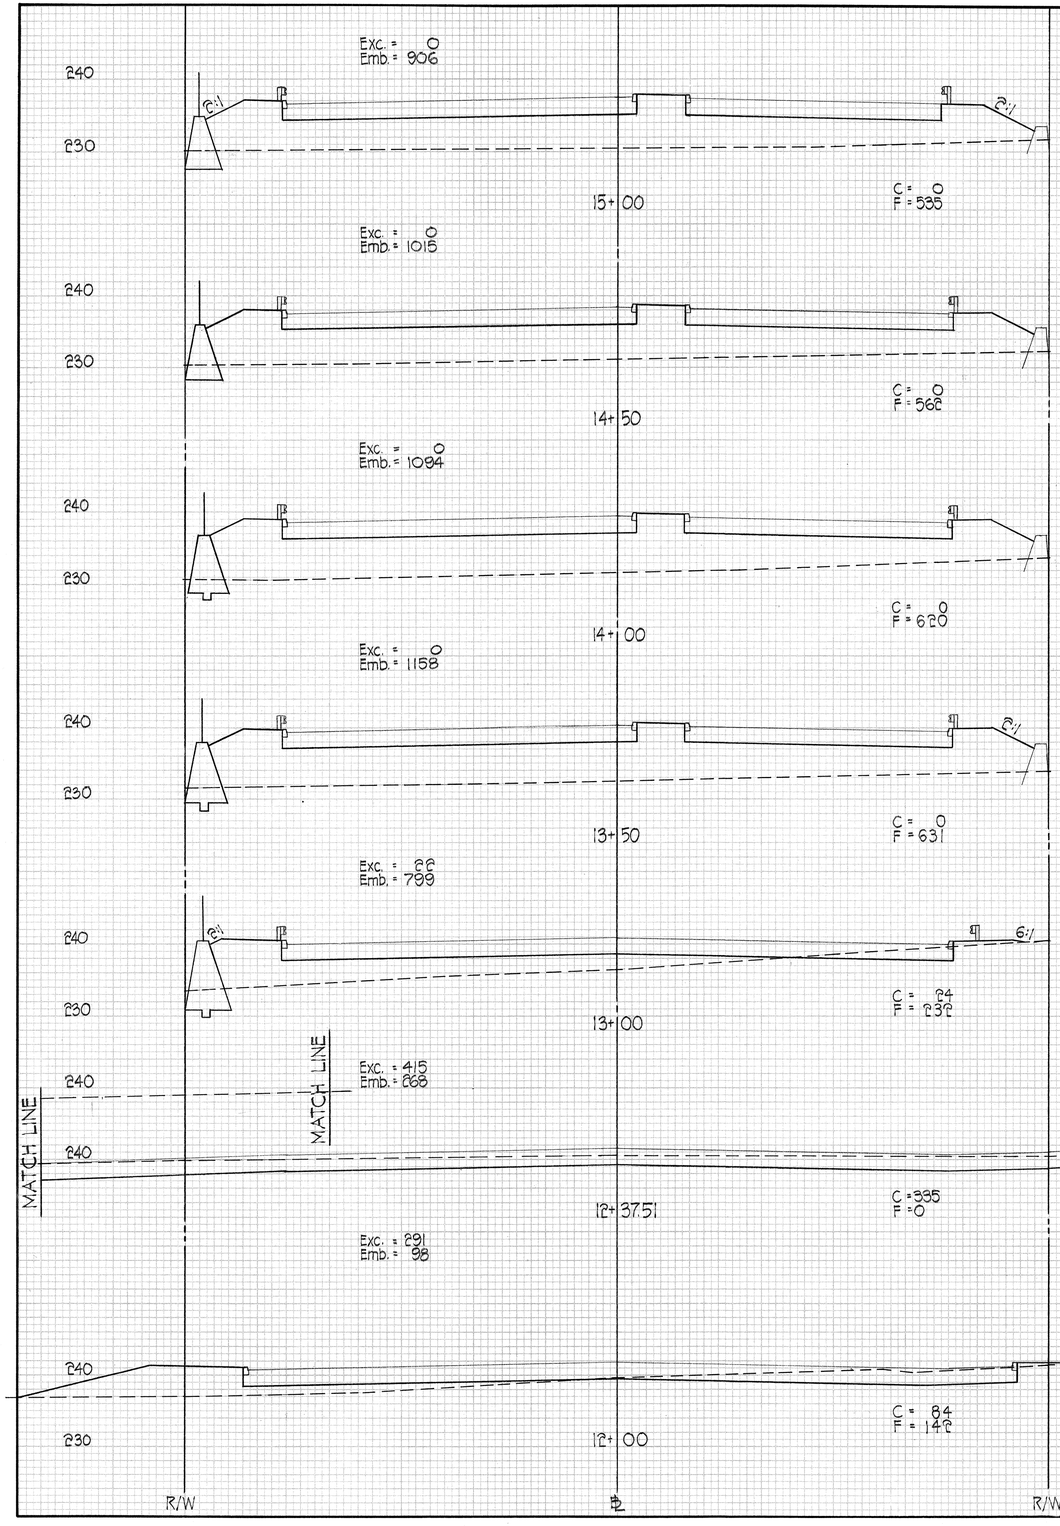


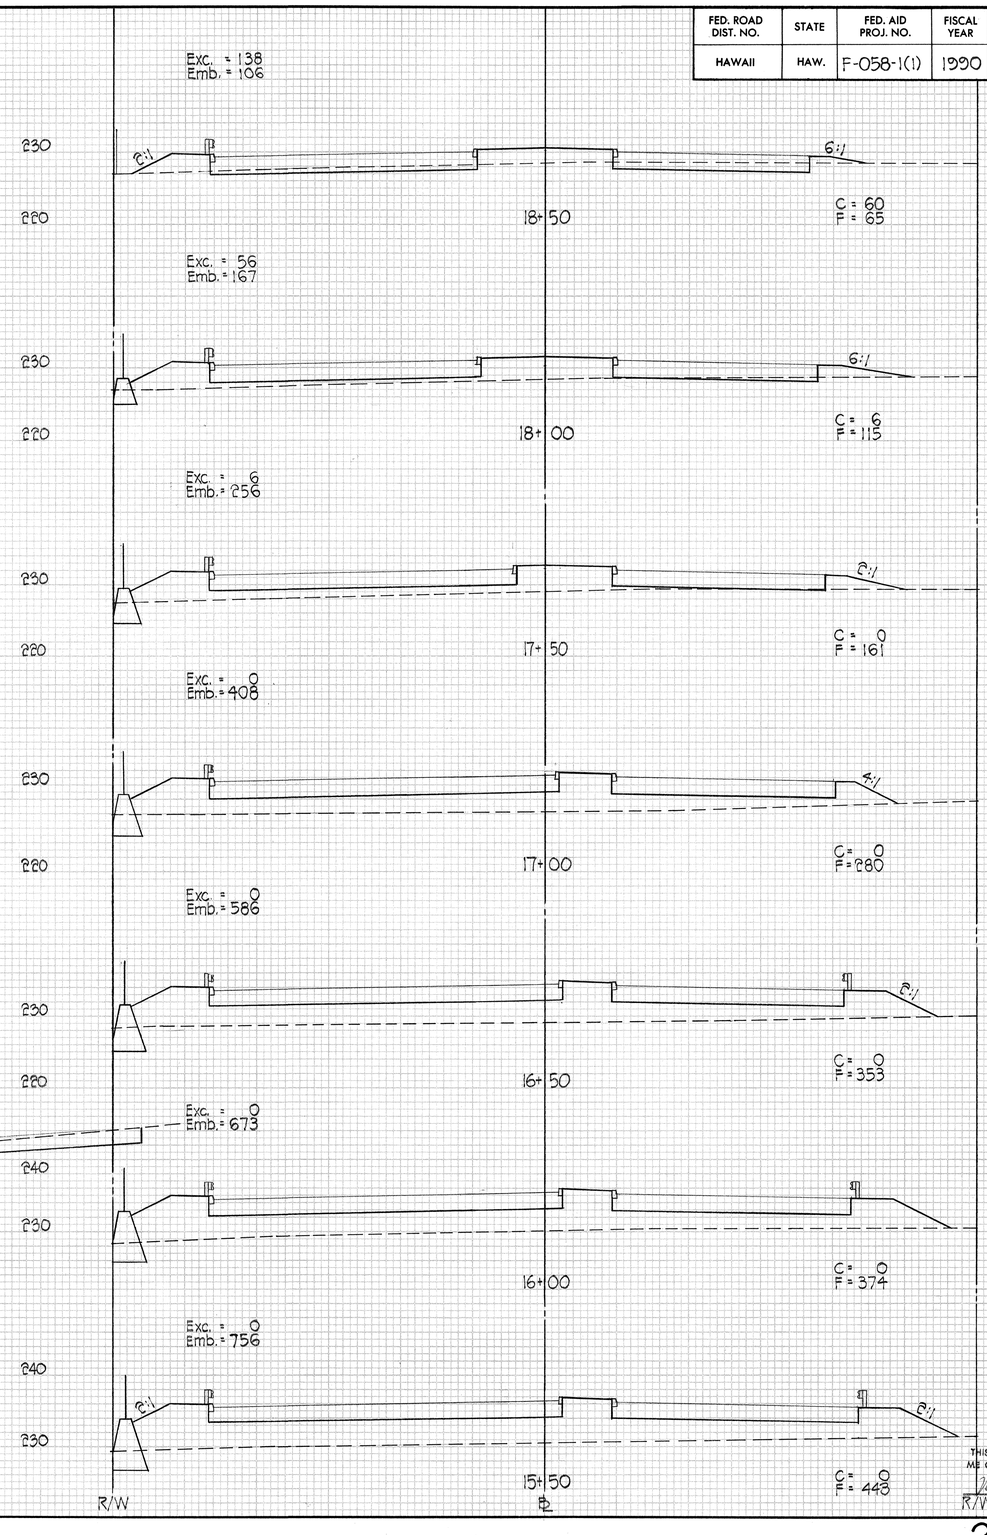


WALLACE K. ENDO
REGISTERED PROFESSIONAL ENGINEER
No. 1207-C
HAWAII, U.S.A.

THIS WORK WAS PREPARED BY ME OR UNDER MY SUPERVISION.

Wallace K. Endo

FINAL SURVEY — SURVEYED, PLOTTED, TEMPLATE, AREAS, AREAS CHECKED, NOTE BOOK, NO., BY, DATE

ORIGINAL SURVEY — SURVEYED, PLOTTED, TEMPLATE, AREAS, AREAS CHECKED, NOTE BOOK, NO., BY, DATE

| FED. ROAD DIST. NO. | STATE | FED. AID PROJ. NO. | FISCAL YEAR | SHEET NO. | TOTAL SHEETS |
|---|---|---|---|---|---|
| HAWAII | HAW. | F-058-1(1) | 1990 | 22 | 29 |

Exc. = 402
Emb. = 10

230
220
R/W
6:1
6:1
22+00
C = 256
F = 5

Exc. = 519
Emb. = 10

230
220
6:1
21+50
C = 308
F = 6

Exc. = 589
Emb. = 7

230
220
6:1
21+00
C = 388
F = 4

Exc. = 529
Emb. = 4

230
220
20+50
C = 249
F = 6

Exc. = 407
Emb. = 9

230
220
4:1
20+00
C = 197
F = 8

R/W
Exc. = 303
Emb. = 31

230
220
4:1
6:1
19+50
C = 130
F = 25

Exc. = 203
Emb. = 69

230
220
3:1
20:1
19+00
C = 89
F = 49
R/W
℄
R/W

230
220
20:1
25+00
C = 100
F = 0

Exc. = 198
Emb. = 1

230
220
4:1
24+50
C = 107
F = 1

Exc. = 199
Emb. = 2

230
220
6:1
24+00
C = 108
F = 1

Exc. = 218
Emb. = 2

℄
R/W
R/W
230
220
23+50
C = 121
F = 1

R/W
Exc. = 235
Emb. = 3

230
220
23+00
C = 133
F = 2

R/W
Exc. = 295
Emb. = 7

230
220
2:1
6:1
22+50
C = 186
F = 6
R/W
℄
R/W

ORIGINAL SURVEY — SURVEYED, PLOTTED, TEMPLATE, AREAS CHECKED, NOTE BOOK, NO., BY, DATE

FINAL SURVEY — SURVEYED, PLOTTED, TEMPLATE, AREAS CHECKED, NOTE BOOK, NO., BY, DATE

WALLACE K. ENDO
REGISTERED PROFESSIONAL ENGINEER
No. 1207-C
HAWAII, U.S.A.

THIS WORK WAS PREPARED BY ME OR UNDER MY SUPERVISION.
Wallace K. Endo

| FED. ROAD DIST. NO. | STATE | FED. AID PROJ. NO. | FISCAL YEAR | SHEET NO. | TOTAL SHEETS |
|---|---|---|---|---|---|
| HAWAII | HAW. | F-058-1(1) | 1990 | 23 | 29 |

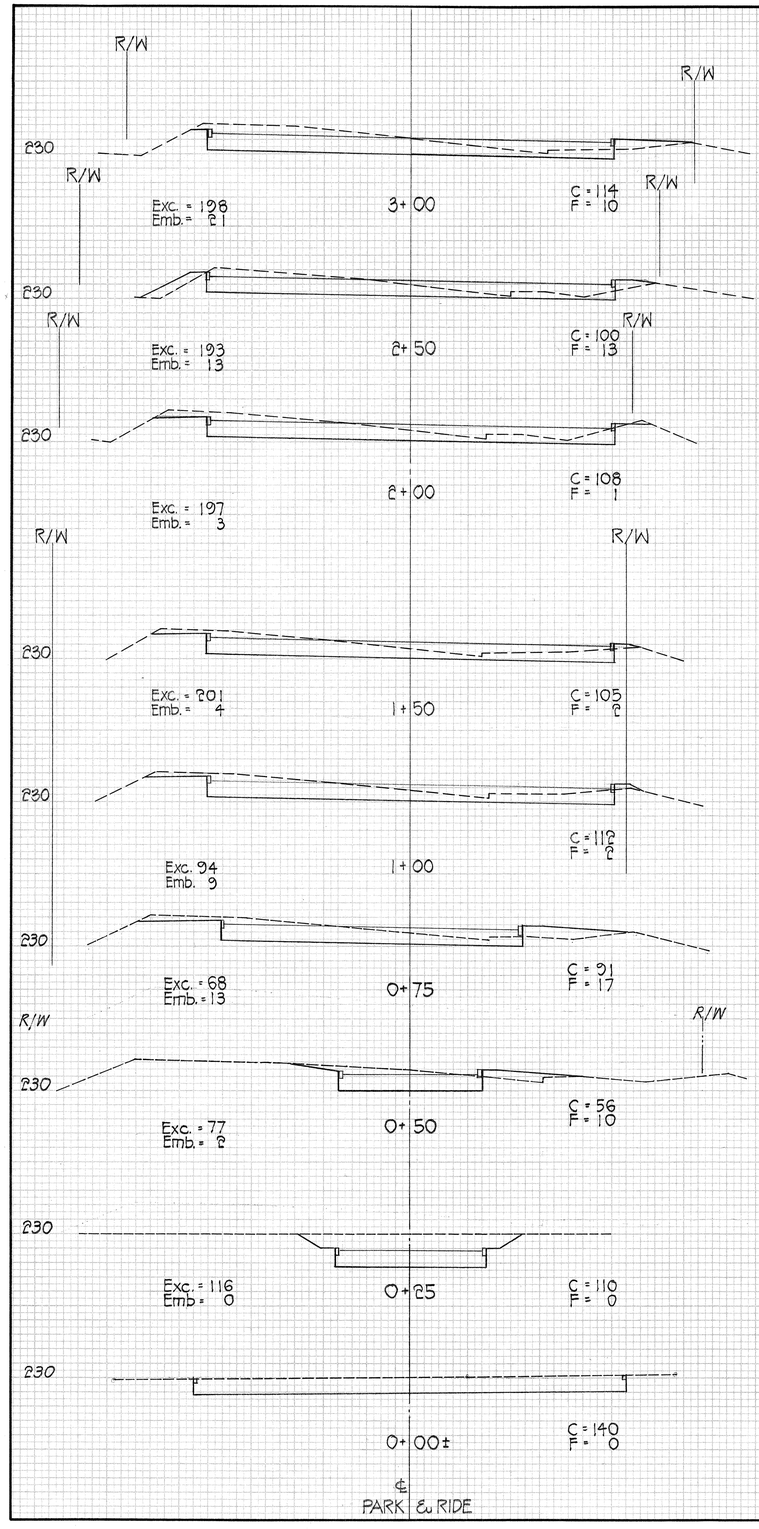


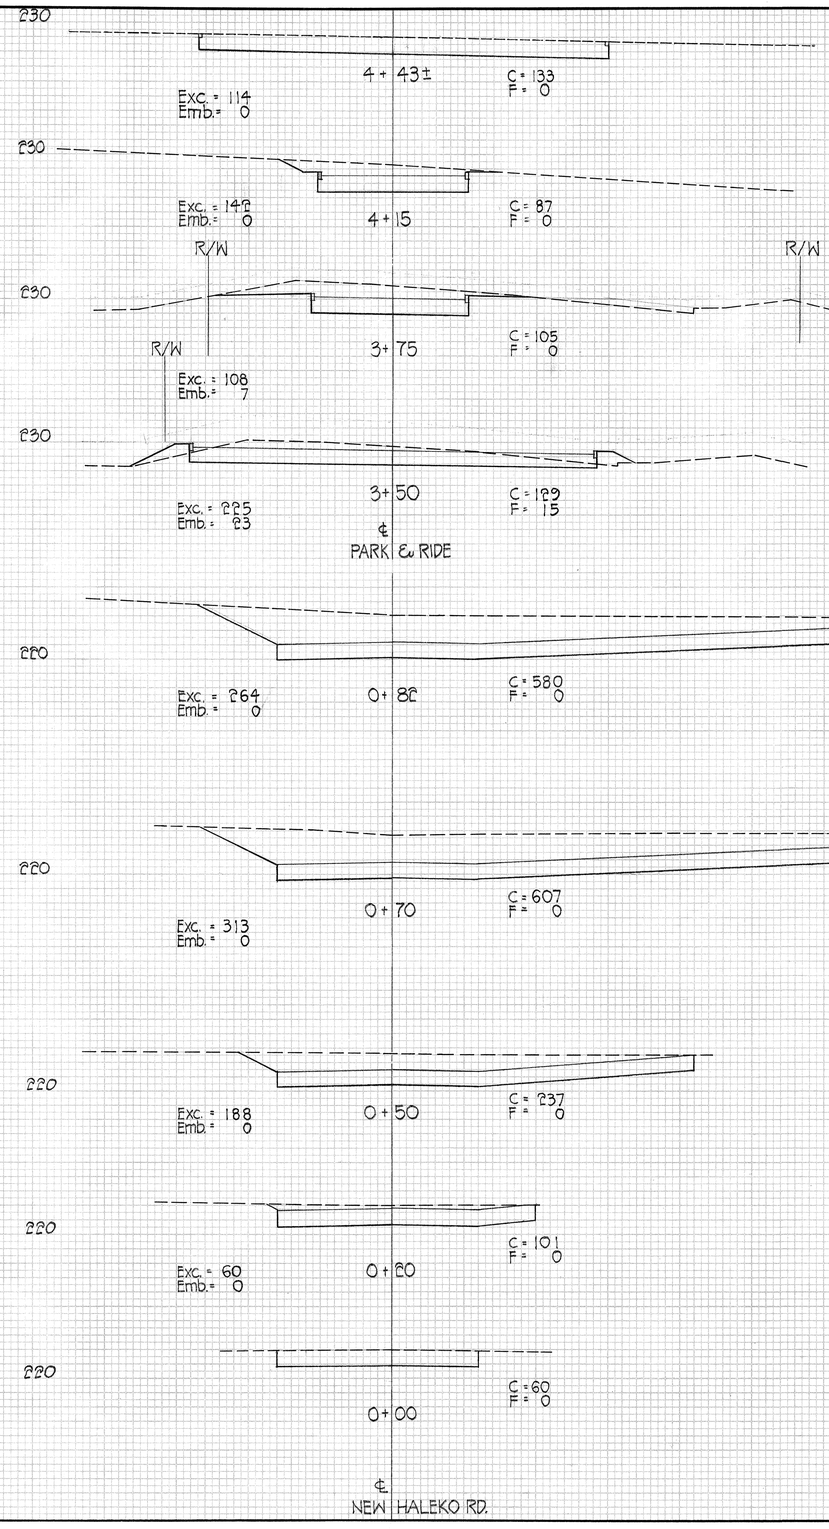


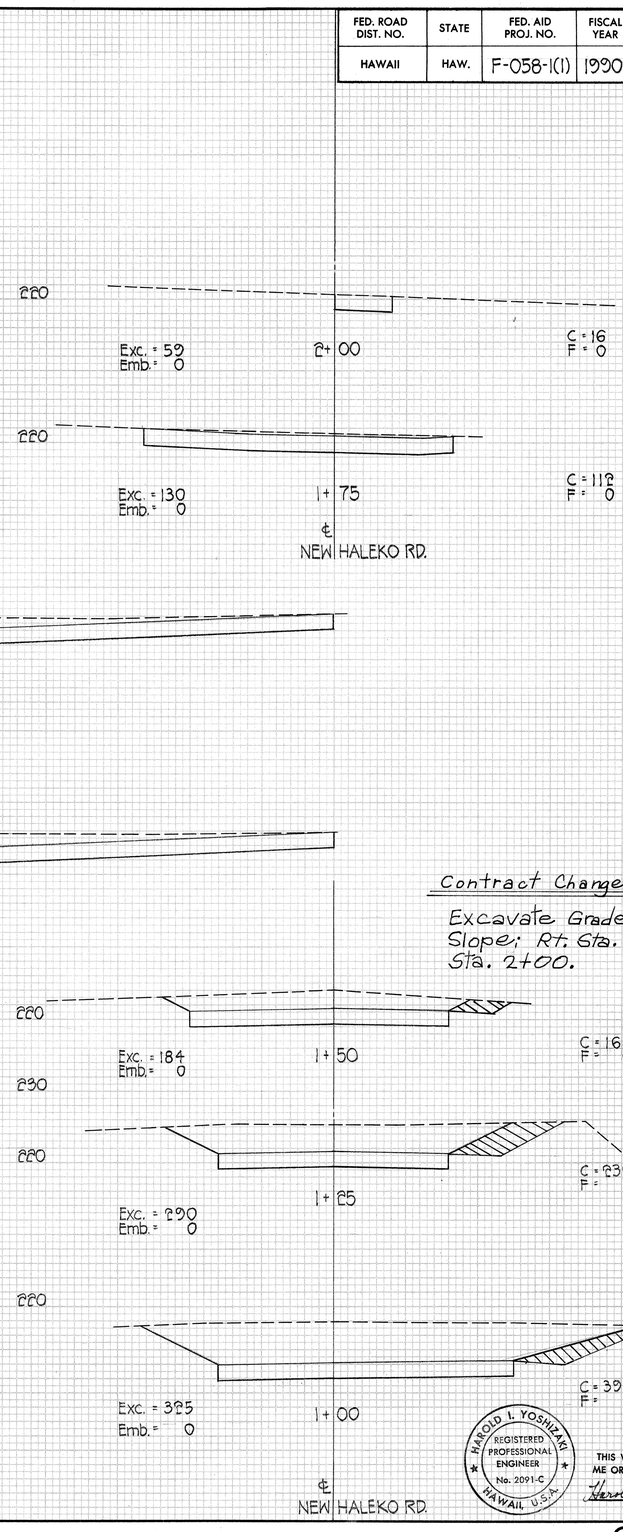


HAROLD I. YOSHIZAKI
REGISTERED PROFESSIONAL ENGINEER
No. 2091-C
HAWAII, U.S.A.

THIS WORK WAS PREPARED BY ME OR UNDER MY SUPERVISION.
Harold I. Yoshizaki

Exc = 1593 1733
Emb = 95

Exc 1813 CY