FED. ROAD DIST. NO.	STATE	FED. AID PROJ. NO.	FISCAL YEAR	SHEET NO.	TOTAL SHEETS
HAWAII	HAW.	F-058-1(1)	1990	18	29

PHASE DIAGRAM

*Programmed Visibility Signal

SIGNAL INDICATIONS

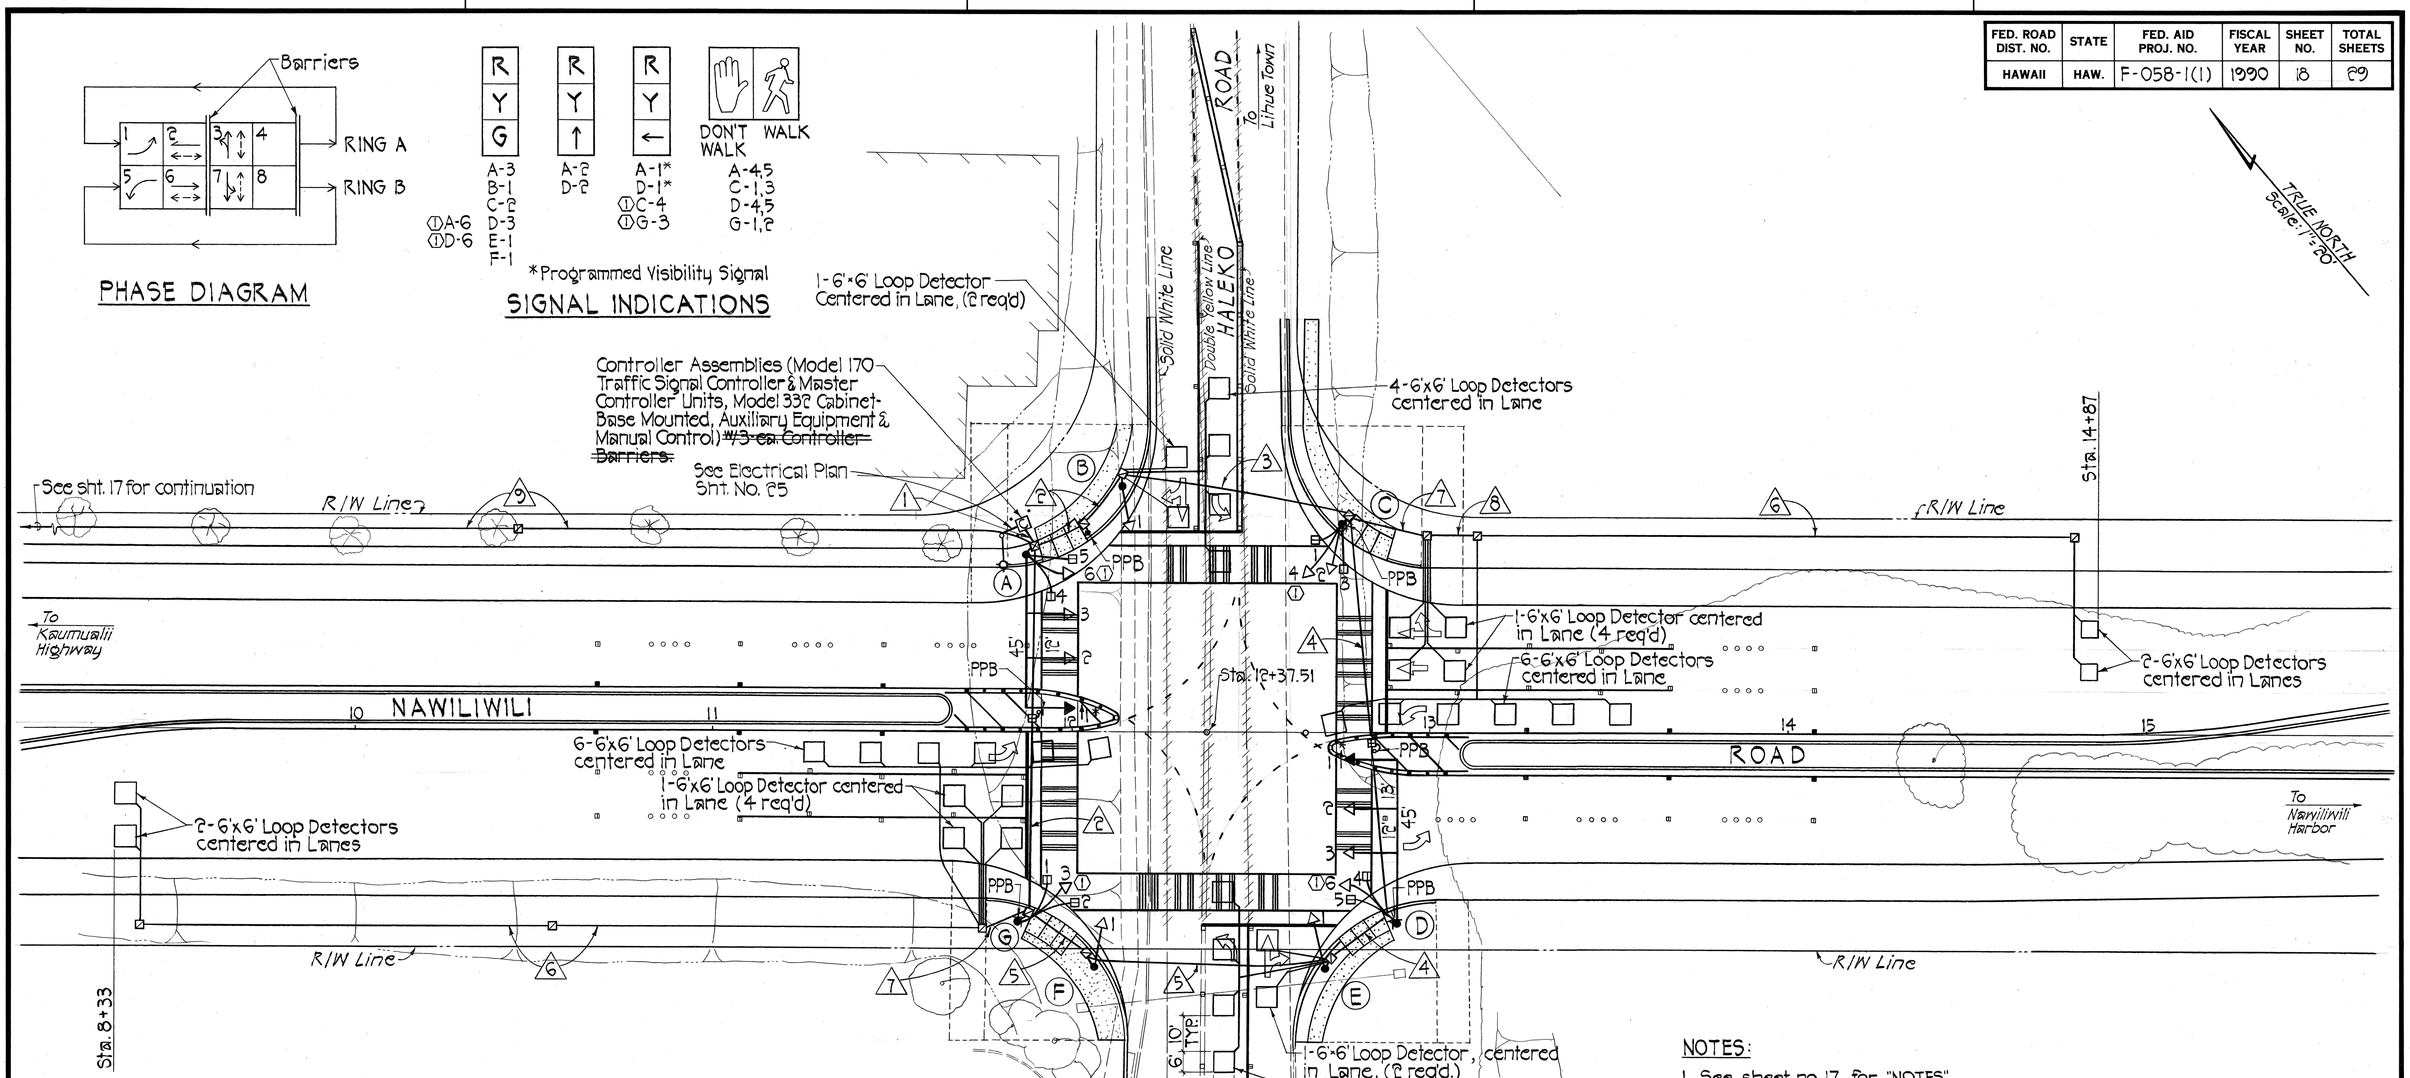

PLAN
Scale: 1"=20'

KUKUI GROVE SHOPPING CENTER

Contract Change Order No. 9
All #20 Conductor Control Cable shall include 1-#19 Conductor Control Cable.

CONDUIT & CABLE SCHEDULE

△	CONDUIT	CABLE
1	6-2"Sch. 80	2-26C #14, 1-24C #20, 14-2C #14
2	2-2"Sch. 80	1-26C #14, 7-2C #14
3	2-2"Sch. 80	1-26C #14, 5-2C #14
4	2-2"Sch. 80	1-26C #14, 1-2C #14
5	2-2"Sch. 80	1-26C #14, 3-2C #14
6	1-2"Sch. 80	1-2C #14
7	1-2"Sch. 80	3-2C #14
8	1-2"Sch. 80	2-2C #14
9	1-2"Sch. 80	1-24C #20

NOTES:

1. See sheet no. 17 for "NOTES".
2. See sheet no. 11 for striping, arrow, marking and signing.
3. See Electrical Plan, sheet no. 25 for electric service connections.

DATE	REVISION
12-26-89	① Added Traffic Signal Indications A-6, C-4, D-6 & G-3

HAROLD I. YOSHIZAKI
REGISTERED PROFESSIONAL ENGINEER
No. 2091-C
HAWAII, U.S.A.

THIS WORK WAS PREPARED BY ME OR UNDER MY SUPERVISION.
Harold I. Yoshizaki

STATE OF HAWAII
DEPARTMENT OF TRANSPORTATION
HIGHWAYS DIVISION

TRAFFIC SIGNAL PLAN
AT HALEKO ROAD

NAWILIWILI ROAD REALIGNMENT
HALEHAKA ROAD TO KAUMUALII HIGHWAY
FED. AID PROJECT NO. F-058-1(1)

SCALE: AS NOTED DATE: Sept. 1989

SHEET No. 1 OF 1 SHEETS

ORIGINAL PLAN | SURVEY PLOTTED BY | DRAWN BY | TRACED BY | DESIGNED BY | QUANTITIES BY | CHECKED BY | DATE
NOTE BOOK No.

ADD 18