FED. ROAD DIST. NO.	STATE	PROJ. NO.	FISCAL YEAR	SHEET NO.	TOTAL SHEETS
HAWAII	HAW.	50B-01-92M	1992	5	7

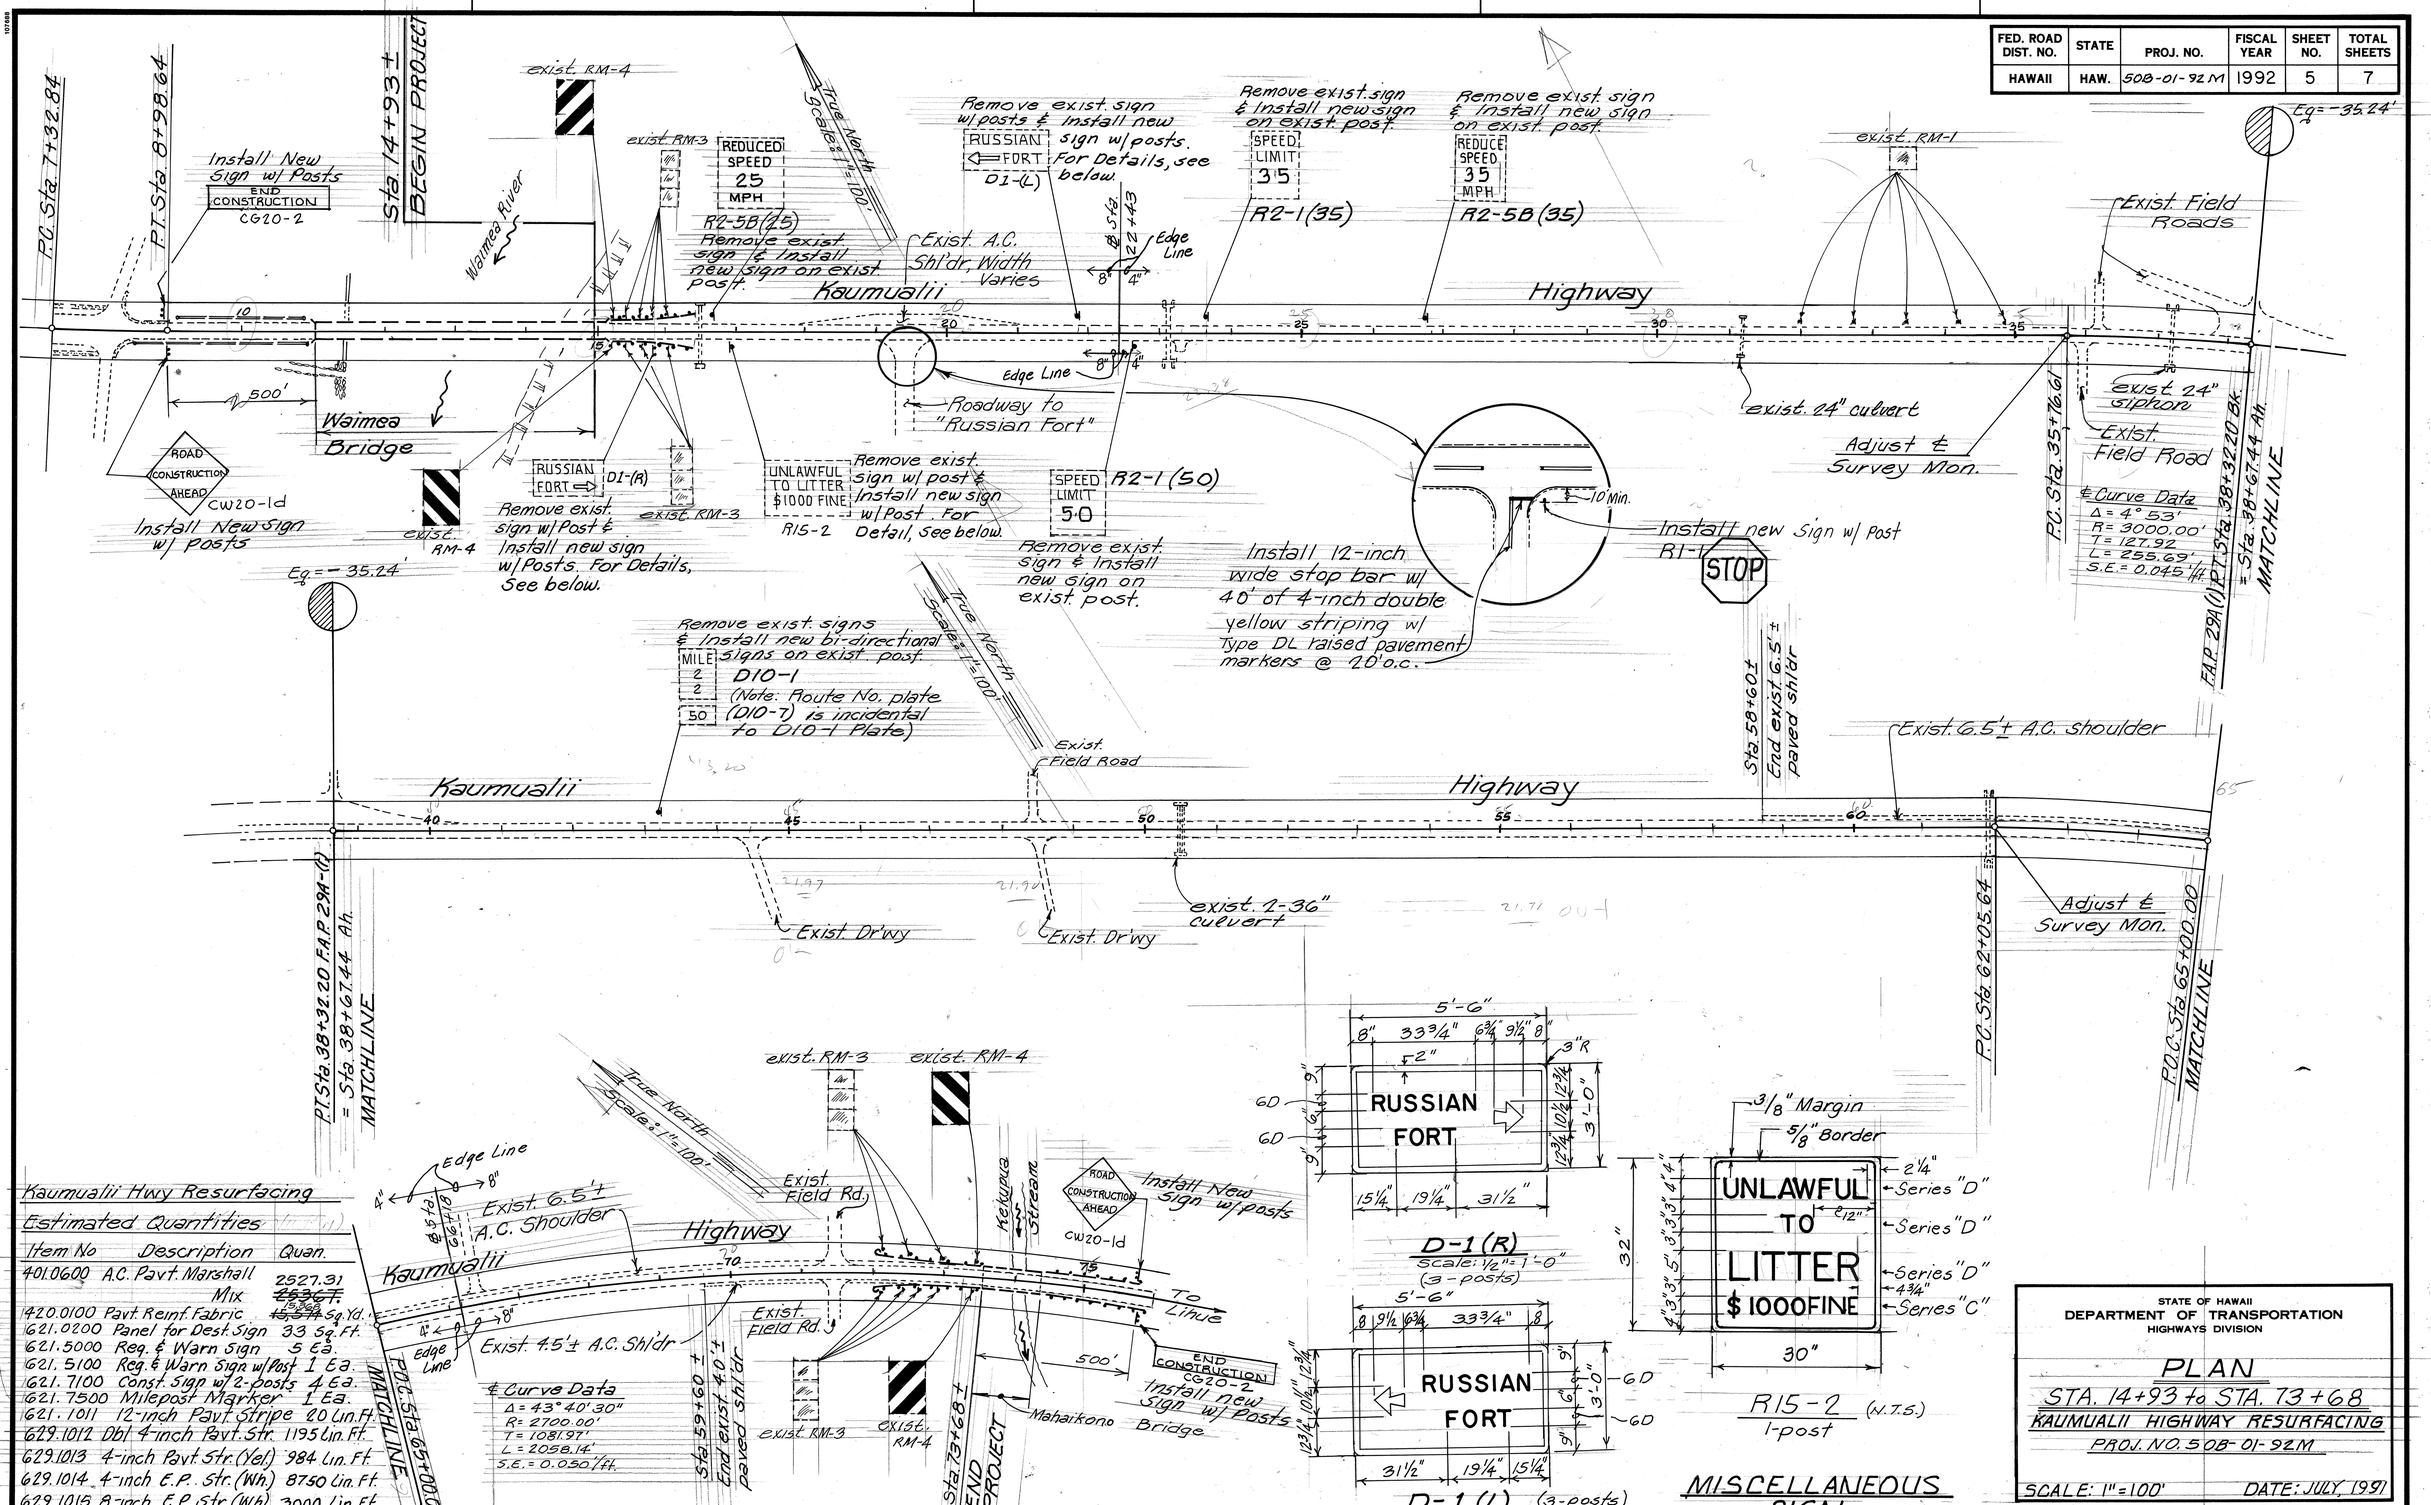

Kaumualii Hwy Resurfacing

Estimated Quantities

Item No	Description	Quan.
401.0600	A.C. Pavt. Marshall Mix	2527.31 ~~2536.7~~ ~~15,374~~ 15,388 Sq. Yd.
420.0100	Pavt. Reinf. Fabric	
621.0200	Panel for Dest. Sign	33 Sq. Ft.
621.5000	Reg. & Warn Sign	5 Ea.
621.5100	Reg. & Warn Sign w/ Post	1 Ea.
621.7100	Const. Sign w/ 2-posts	4 Ea.
621.7500	Milepost Marker	1 Ea.
621.1011	12-inch Pavt. Stripe	20 Lin. Ft.
629.1012	Dbl 4-inch Pavt. Str.	1195 Lin. Ft.
629.1013	4-inch Pavt. Str. (Yel)	984 Lin. Ft.
629.1014	4-inch E.P. Str. (Wh)	8750 Lin. Ft.
629.1015	8-inch E.P. Str. (Wh)	3000 Lin. Ft.

For Pavt. Markers & Survey Mon. See Sht. 3.

		DATE
SURVEY PLOTTED BY		
DRAWN BY		
TRACED BY		
DESIGNED BY		
QUANTITIES BY		
CHECKED BY		
ORIGINAL PLAN	NOTE BOOK	No.

STATE OF HAWAII
DEPARTMENT OF TRANSPORTATION
HIGHWAYS DIVISION

PLAN

STA. 14+93 to STA. 73+68

KAUMUALII HIGHWAY RESURFACING

PROJ. NO. 50B-01-92M

SCALE: 1" = 100' DATE: JULY, 1991

SHEET No. 5 OF 7 SHEETS