INDEX TO DRAWINGS	
SHEET NO.	DESCRIPTION
1	TITLE SHEET
2	STANDARD PLANS SUMMARY
3	GENERAL NOTES AND LEGEND
4	BRIDGE NO. 2–MANA
5	BRIDGE NO. 2 MANA
6	SHOULDER REPAIR–WAIMEA
7	SHOULDER REPAIR–WAIMEA
8	GROUTED RUBBLE PAVING
9	CONCRETE GUTTER REPAIR
10	CONCRETE GUTTER REPAIR

FED. ROAD DIST. NO.	STATE	FED. AID PROJ. NO.	FISCAL YEAR	SHEET NO.	TOTAL SHEETS
HAWAII	HAW.	HWY–K–02–96M	1997	1	10

50
56

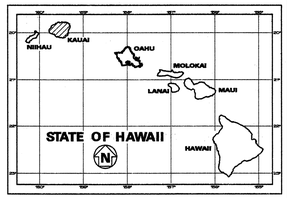

STATE OF HAWAII

DEPARTMENT OF TRANSPORTATION

HIGHWAYS DIVISION

HONOLULU, HAWAII

"AS-BUILT"

PLANS FOR

KAUMUALII HIGHWAY AND KUHIO HIGHWAY

STORM DAMAGE REPAIRS AT VARIOUS LOCATIONS

PROJECT NO. HWY–K–02–96M

DISTRICTS OF WAIMEA AND KAWAIHAU
ISLAND OF KAUAI

CHANGES MADE DURING CONSTRUCTION HAVE BEEN INCORPORATED ON THESE PLANS EXCEPT CHANGES IN THE ORIGINAL THEORETICAL QUANTITIES. FOR ACTUAL QUANTITIES, REFER TO PROJECT LEDGER AND/OR COMPUTATION BOOK.

Bernard Antonio — RESIDENT ENGINEER — 2/24/99 DATE

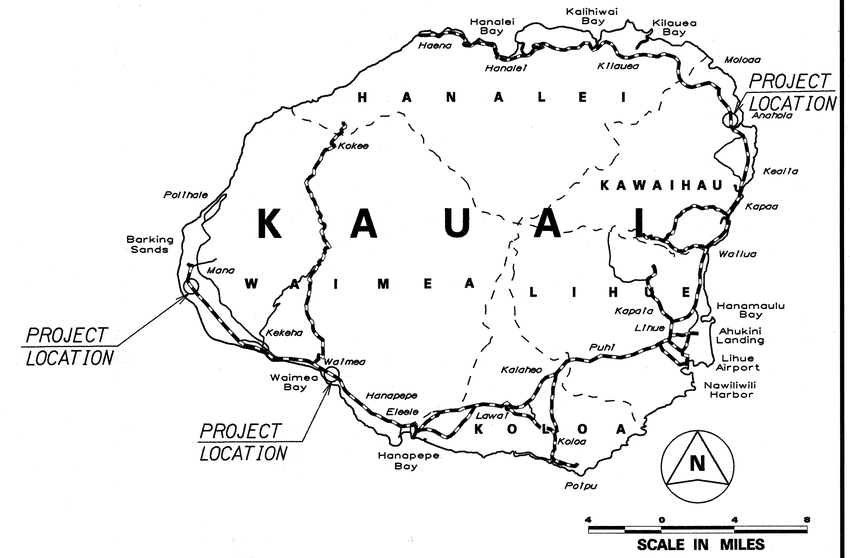

SCALE IN MILES

FEDERAL AID PROJECTS PREVIOUSLY CONSTRUCTED OR UNDER CONSTRUCTION

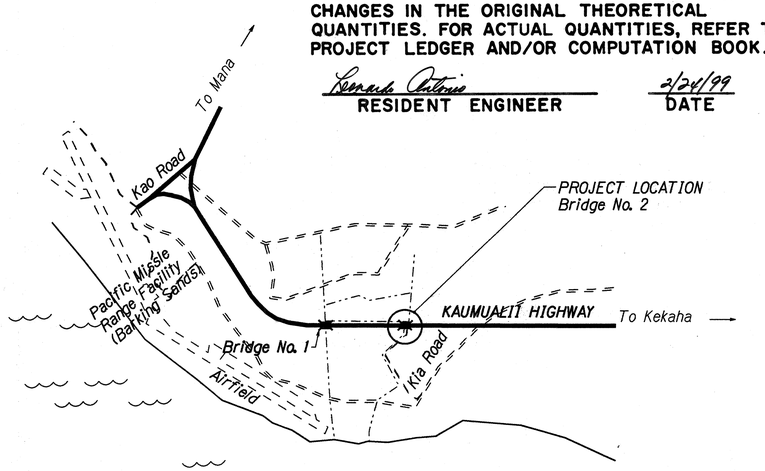

KAUMUALII HIGHWAY
M.P. 31.21 ±

SCALE IN THOUSAND FEET

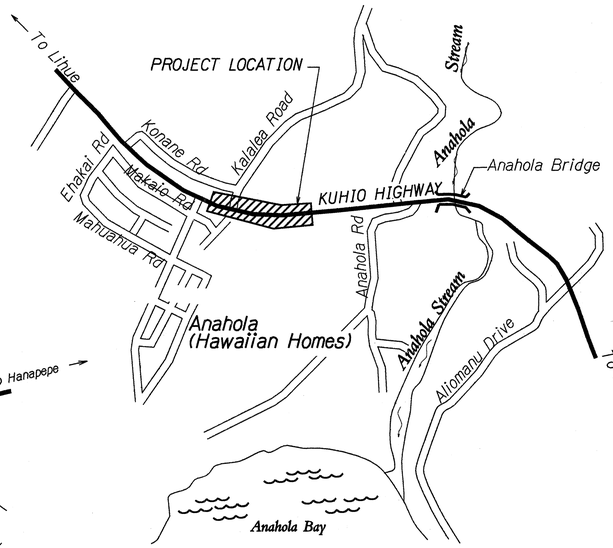

KUHIO HIGHWAY
M.P. 13.25 ±

SCALE IN THOUSAND FEET

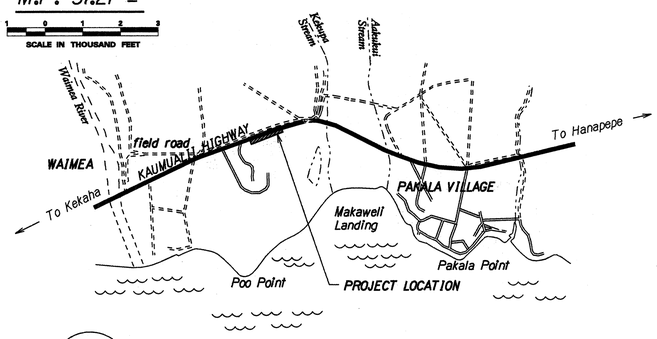

KAUMUALII HIGHWAY
M.P. 21.9 ±

SCALE IN THOUSAND FEET

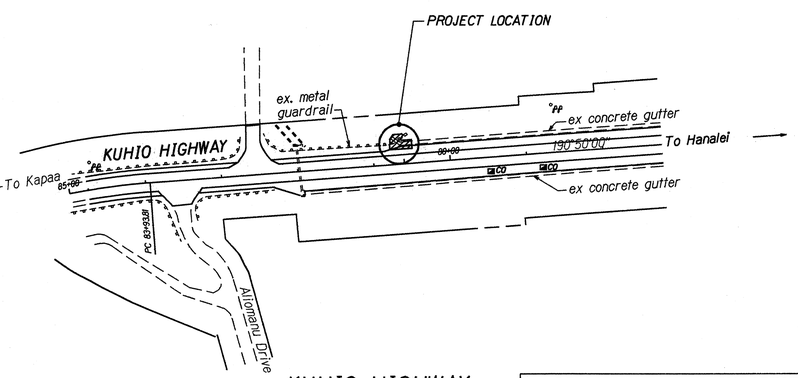

KUHIO HIGHWAY
M.P. 14.2 ±

SCALE IN HUNDRED FEET

HWY-K	KEVIN ITO	587-2244	APRIL, 1997
DESIGNED BY	P. S. & E. BY	PHONE	DATE

DEPARTMENT OF TRANSPORTATION
STATE OF HAWAII

APPROVED:

Glenn M. Okimoto — DIR. OF TRANSPORTATION — 5/16/97 DATE

d:\tgraca\fkms
7kmskfshl.dgn