FED. ROAD DIST. NO.	STATE	FED. AID PROJ. NO.	FISCAL YEAR	SHEET NO.	TOTAL SHEETS
HAWAII	HAW.	STP-0700 (28)	1994	1	10

51
56

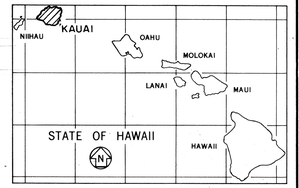

INDEX TO DRAWINGS

SHEET NO.	DESCRIPTION
1	TITLE SHEET
2	STANDARD PLANS SUMMARY
3	GENERAL NOTES AND TYPICAL SECTION
4	PLAN - RICE STREET
5	GUARDRAIL DETAILS-NAWILIWILI BR.
6-10	PLAN - KUHIO HWY

STATE OF HAWAII

DEPARTMENT OF TRANSPORTATION
HIGHWAYS DIVISION
HONOLULU, HAWAII

"AS-BUILT"
PLANS FOR

GUARDRAIL AND SHOULDER IMPROVEMENTS
ROUTE 51, RICE STREET
ROUTE 56, KUHIO HIGHWAY

FEDERAL AID PROJECT STP-0700(28)

DISTRICT OF LIHUE
AND KAWAIHAU
ISLAND OF KAUAI

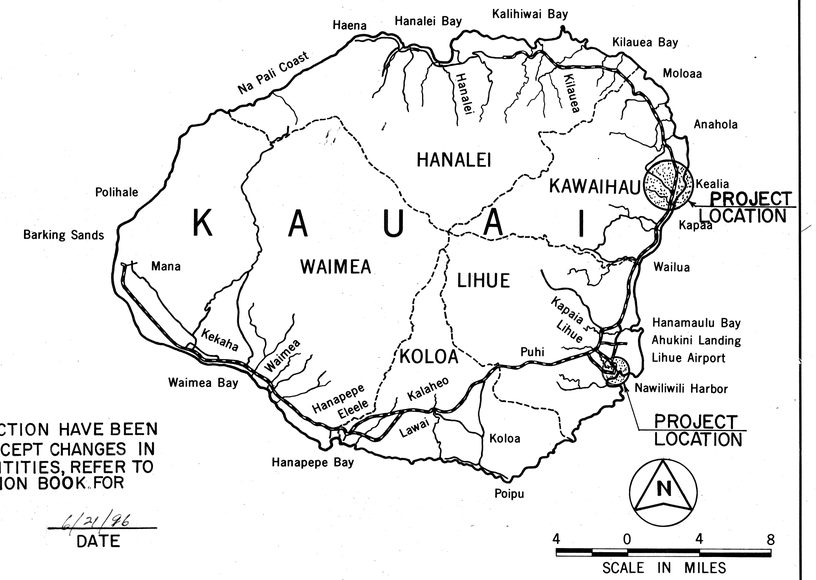

CHANGES MADE DURING CONSTRUCTION HAVE BEEN INCORPORATED ON THESE PLANS EXCEPT CHANGES IN THE ORIGINAL THEORETICAL QUANTITIES, REFER TO PROJECT LEDGER AND OR COMPUTATION BOOK FOR ACTUAL QUANTITIES.

Bernard Antonio — RESIDENT ENGINEER — 6/21/96 DATE

PROJECT LOCATIONS

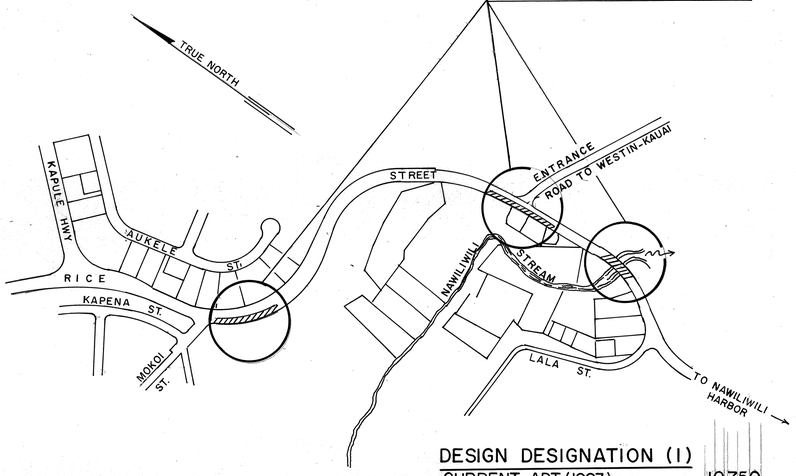

RICE STREET
SCALE : 1" = 600'

DESIGN DESIGNATION (1)

CURRENT ADT (1993)	10,750
DESIGN ADT (2013)	16,100
DHV	1,370
D	55/45
T_{24}	9.5 %

PROJECT LIMITS
LENGTH = 2.64 MI.

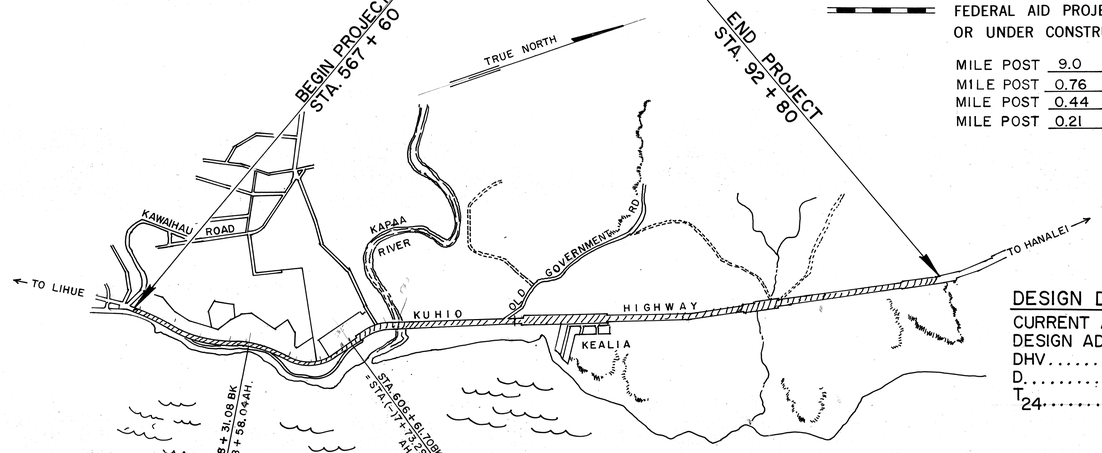

KUHIO HIGHWAY
SCALE : 1" = 1200'

FEDERAL AID PROJECTS PREVIOUSLY CONSTRUCTED OR UNDER CONSTRUCTION

MILE POST	9.0	TO MILE POST	11.65
MILE POST	0.76		
MILE POST	0.44		
MILE POST	0.21		

DESIGN DESIGNATION (11)

CURRENT ADT (1993)	11,190
DESIGN ADT (2013)	17,960
DHV	1,530
D	55/45
T_{24}	6.0 %

LAYOUT OF PROJECT

DEPARTMENT OF TRANSPORTATION FEDERAL HIGHWAY ADMINISTRATION	
APPROVED:	
DIVISION ADMINISTRATOR	6/15/93 DATE

DEPARTMENT OF TRANSPORTATION STATE OF HAWAII	
APPROVED:	
for DIR. OF TRANSPORTATION	6/10/93 DATE

KAUAI DISTRICT DESIGNED BY	JULIUS B. FRONDA P. S. & E. BY	587-2246 PHONE	JAN. 1993 DATE