FED. ROAD DIST. NO.	STATE	PROJ. NO.	FISCAL YEAR	SHEET NO.	TOTAL SHEETS
HAWAII	HAW.	HWY-K-03-04M	2004	1	20

STATE OF HAWAII

DEPARTMENT OF TRANSPORTATION

HIGHWAYS DIVISION

HONOLULU, HAWAII

"AS-BUILT"

PLANS FOR

KAUMUALII HIGHWAY & KUHIO HIGHWAY

MISCELLANEOUS PAVEMENT RECONSTRUCTION/RESURFACING AT VARIOUS LOCATIONS

PROJECT NO. HWY-K-03-04M

DISTRICTS OF WAIMEA, LIHUE, KAWAIHAU & HANALEI

ISLAND OF KAUAI

50 56 560

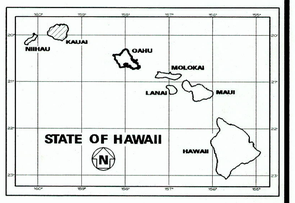

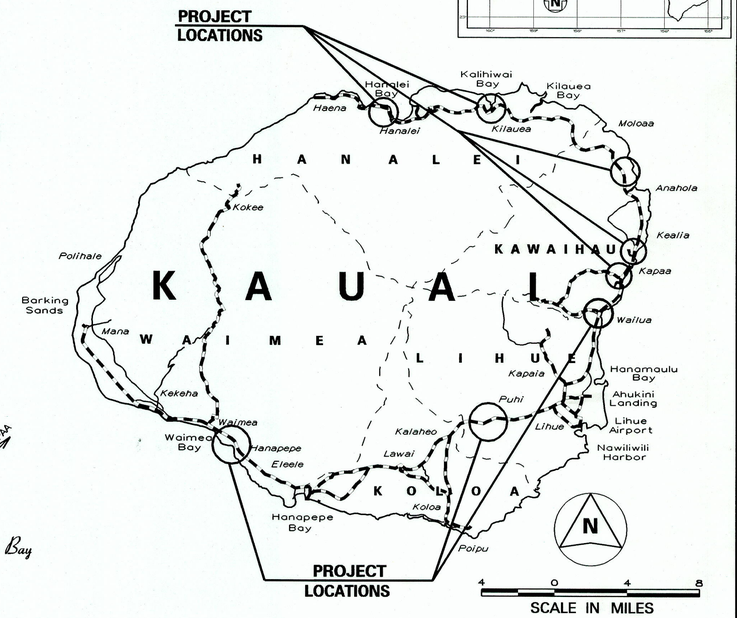

FEDERAL AID PROJECTS PREVIOUSLY CONSTRUCTED OR UNDER CONSTRUCTION

	INDEX TO DRAWINGS
SHEET NO.	DESCRIPTION
1	TITLE SHEET
2	STANDARD PLANS SUMMARY
3	GENERAL NOTES & LEGEND
4–5	WATER POLLUTION & EROSION CONTROL NOTES
6–7	TYPICAL SECTIONS
8	DRAIN INLET ADJUSTMENT DETAILS
9	BRIDGE JOINT REPAIR NOTES & DETAILS
10–13	ROADWAY PLAN
14	GRADING PLAN AND PROFILE
15	PAVEMENT MARKING LEGEND, DETAILS & NOTES
16	LOW SPEED UNDIVIDED HIGHWAY WORK ZONE SIGNING PLAN, NOTES & DETAILS
17	HIGH SPEED UNDIVIDED HIGHWAY WORK ZONE SIGNING PLAN, NOTES & DETAILS
18–19	PAVEMENT MARKING PLAN
20	PAVEMENT MARKING & CONSTRUCTION SIGNS SUMMARY

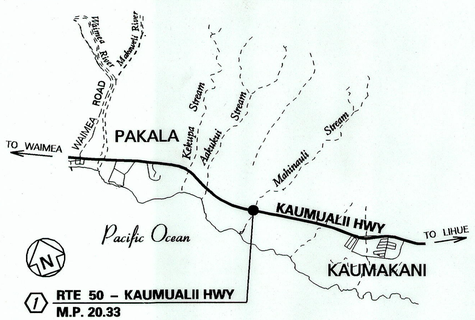

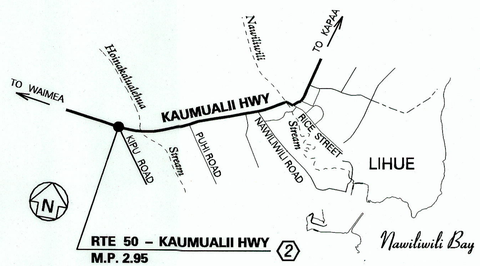

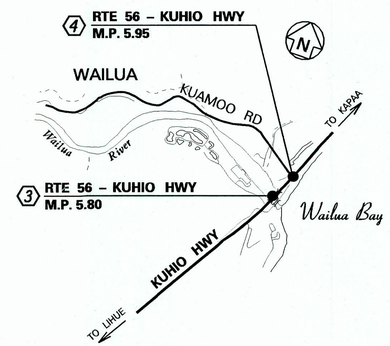

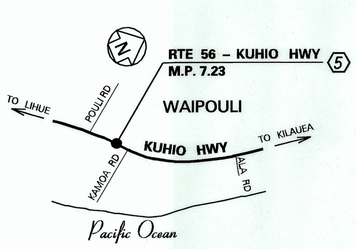

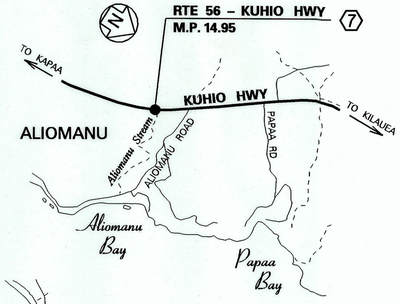

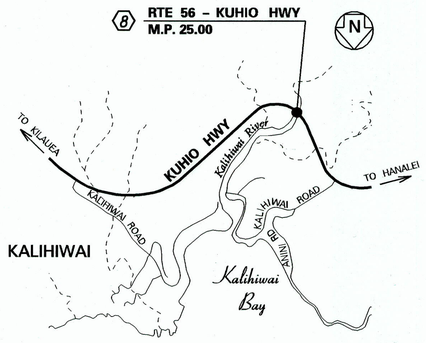

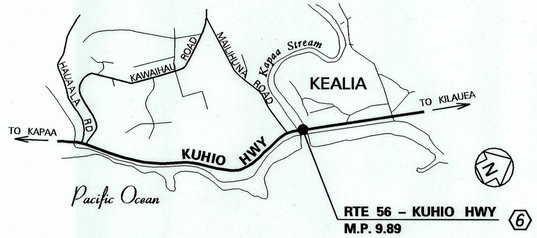

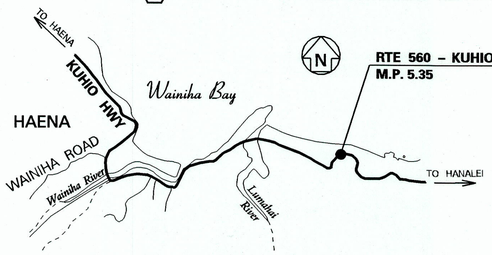

LAYOUT PLAN

NOT TO SCALE

1 MAHINAULI BRIDGE APPROACHES, KAUMUALII HWY AT MILE POST 20.33

2 KAUMUALII HWY / KIPU ROAD INTERSECTION PAVEMENT REPAIRS AT MILE POST 2.95

3 WAILUA BRIDGE JOINT REPAIRS, KUHIO HWY AT MILE POST 5.80

4 KUHIO HWY / KUAMOO ROAD INTERSECTION PAVEMENT REPAIRS AT MILE POST 5.95

5 KUHIO HWY, ADJUST GRATED DROP INLET AT MILE POST 7.23

6 KAPAA STREAM BRIDGE JOINT REPAIRS, KUHIO HWY AT MILE POST 9.89

7 ALIOMANU BRIDGE APPROACHES, KUHIO HWY AT MILE POST 14.95

8 KALIHIWAI BRIDGE APPROACHES, KUHIO HWY AT MILE POST 25.00

9 KUHIO HWY, RTE 560 PAVEMENT REPAIRS AT MILE POST 5.35

CHANGES MADE DURING CONSTRUCTION HAVE BEEN INCORPORATED ON THESE PLANS EXCEPT CHANGES IN THE ORIGINAL THEORETICAL QUANTITIES. FOR ACTUAL QUANTITIES, REFER TO PROJECT LEDGER AND/OR COMPUTATION BOOK.

2/12/15

RESIDENT ENGINEER — DATE

DEPARTMENT OF TRANSPORTATION
STATE OF HAWAII

APPROVED:

4-15-04

for DIR. OF TRANSPORTATION — DATE

HWY-K DESIGNED BY — HWY-KE MANAGED BY — 274-3118 PHONE — APRIL 2004 DATE

DOT-Highway Design Section