DIST. NO.	STATE	PROJ. NO.	FISCAL YEAR	SHEET NO.	TOTAL SHEETS
HAWAII	HAW.	G3325-02-63	1964	4	6

SIGN NOTES

1. The shape, color, dimensions, symbol, wording, lettering and reflectorization of all signs shall be in accordance with the "Manual on Uniform Traffic Control Devices for Streets and Highways", dated June 1961 and the BPR Manual "Standard Highway Signs", dated September 1961 unless otherwise specified.
2. All Warning Signs shall be reflectorized unless specified.
3. All Warning Signs shall have 3/8" bolt holes drilled at appropriate locations unless otherwise noted.

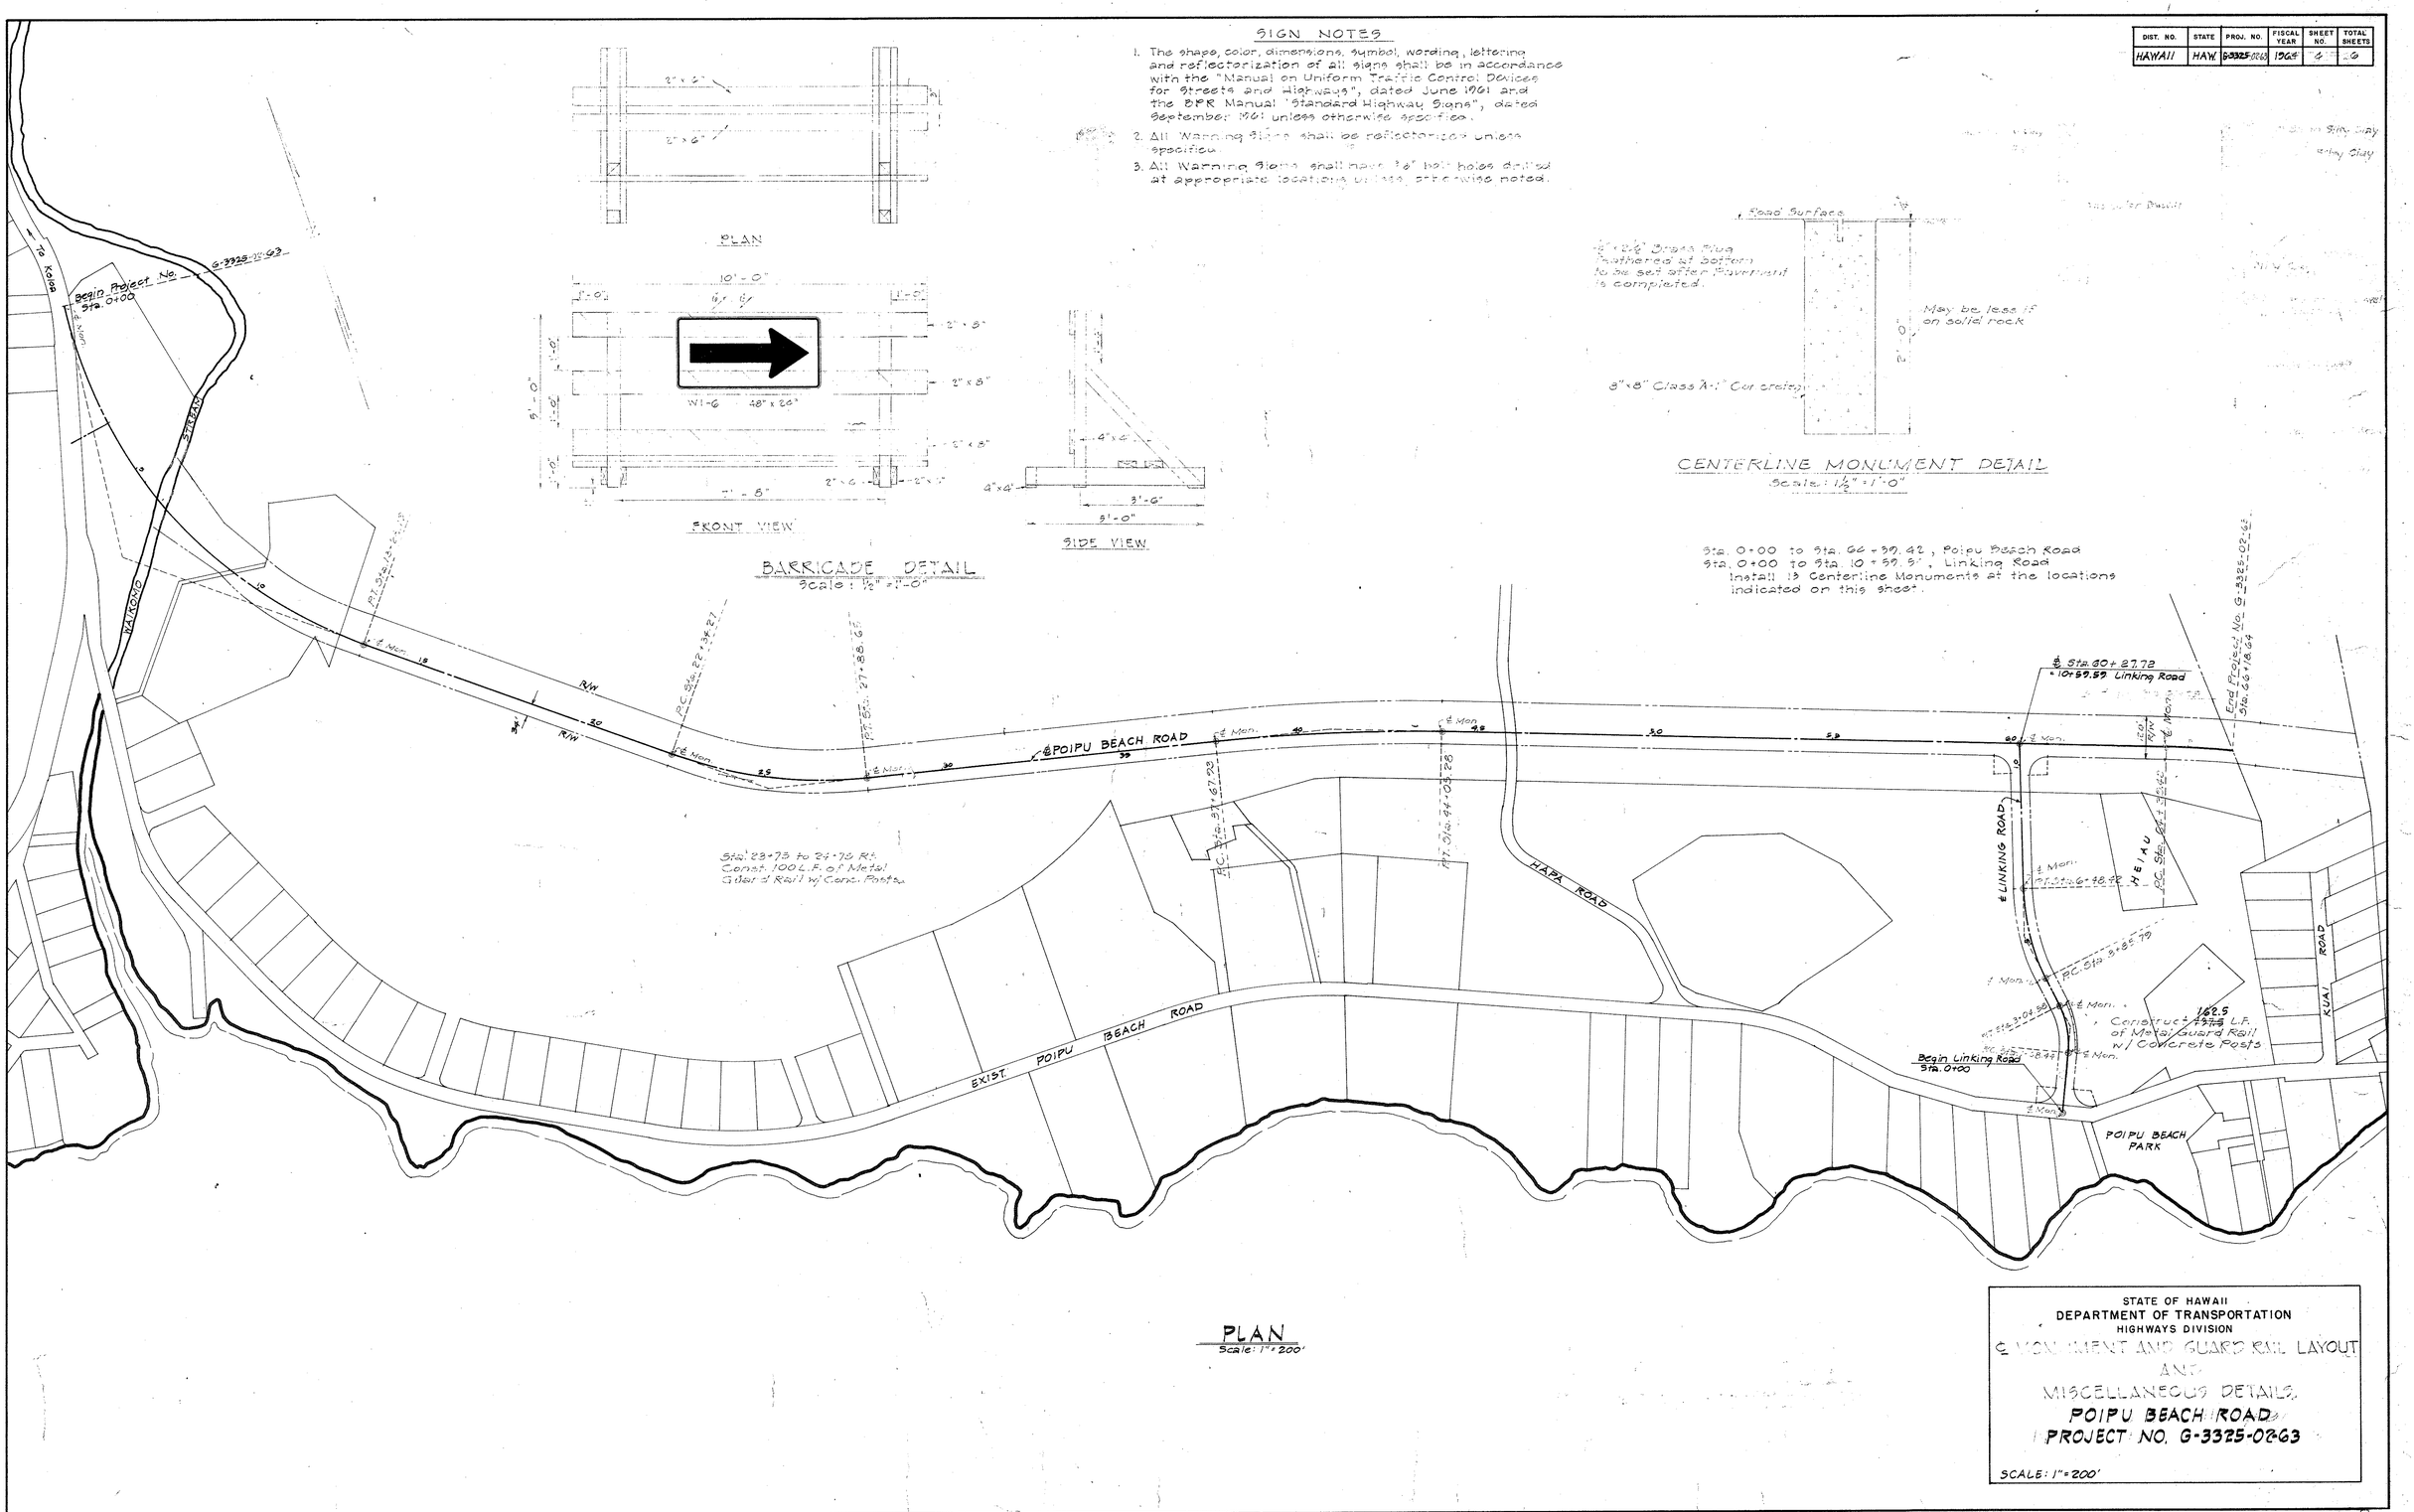

STATE OF HAWAII
DEPARTMENT OF TRANSPORTATION
HIGHWAYS DIVISION

℄ MONUMENT AND GUARD RAIL LAYOUT
AND
MISCELLANEOUS DETAILS
POIPU BEACH ROAD
PROJECT NO. G-3325-02-63

SCALE: 1" = 200'