FED. ROAD DIST. NO.	STATE	FED. AID PROJ. NO.	FISCAL YEAR	SHEET NO.	TOTAL SHEETS
Hawaii	Haw	WPGS 24A	1935	1	21

INDEX TO DRAWINGS	
Sheet No.	Description
1	Title Sheet
2	Typical Road Sections & Siphon Details.
3	Plan and Profile
4-5	Standard Details
6-13	Bridge Details
14-21	Cross Sections

TERRITORY OF HAWAII

TERRITORIAL HIGHWAY DEPARTMENT

HONOLULU, T. H.

PLANS OF

LIHUE ~ ROAD

U.S. WORKS PROGRAM GRADE CROSSING PROJECT NO. W.P.G.S. 24-A

HAWAII PROJECT NO. 24-A

DISTRICT OF LIHUE, KAUAI, T.H.

CONVENTIONAL SIGNS

- Edge of existing Road
- Existing Fence
- Boundary Line (not fenced)
- Existing Stone Wall
- Railroad
- Center Line
- Future Pavement
- Cement Rubble Masonry Wall
- Bridges

SCALES

PLANS		1 INCH = 100 FEET
PROFILE	HOR.	1 INCH = 100 FEET
	VERT.	1 INCH = 20 FEET
CROSS SECTIONS		1 INCH = 10 FEET

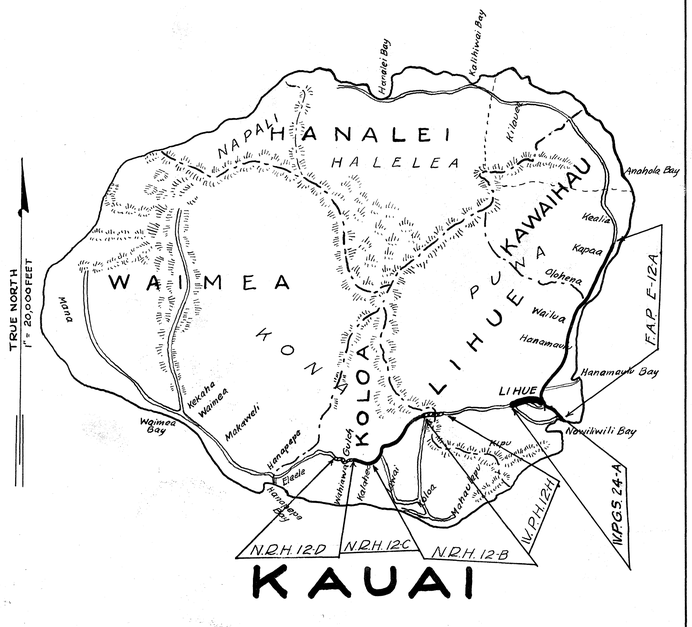

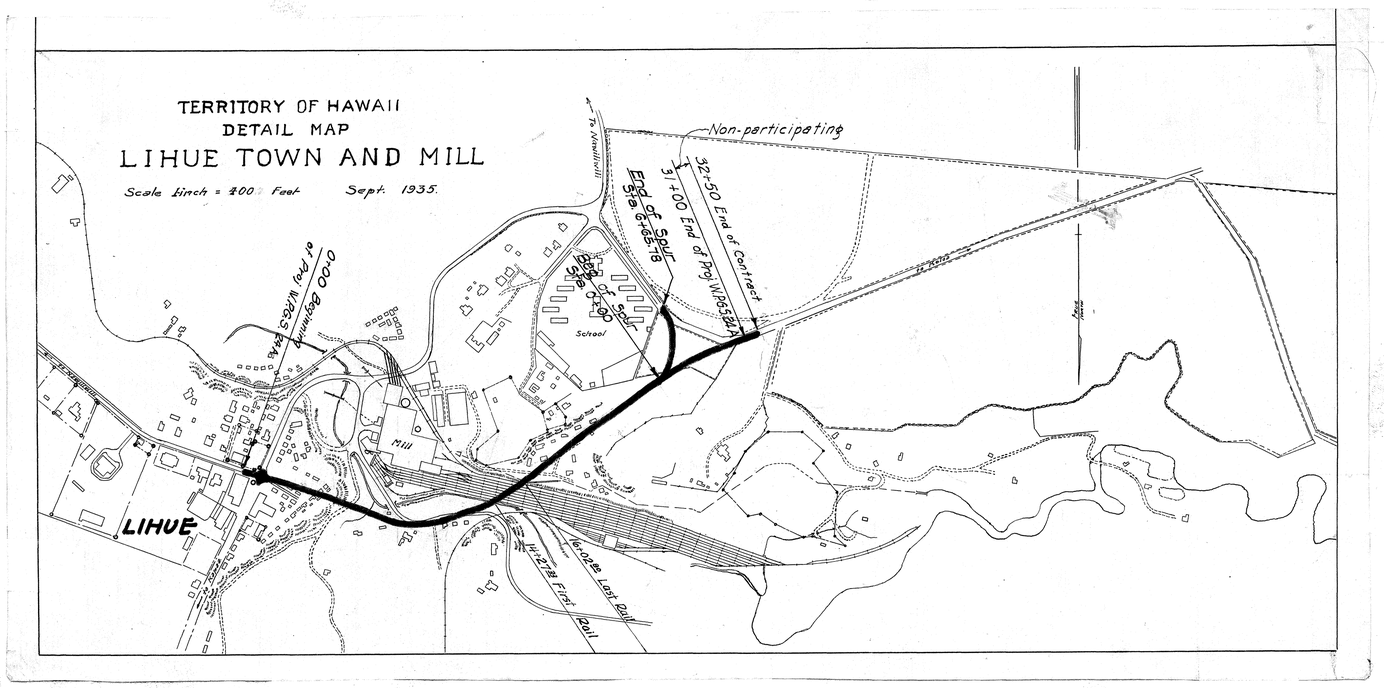

LAYOUT OF PROJECT

SCALE 1:4800

Project Proper	0.587 miles	Gross Length of Project	0.696	Miles
Spur	0.109 "	Bridges (over 20 ft Span)	0.058	" 0.059
Gross Length of Project	0.696 miles	Net Length Roadway	0.638	" 0.637

APPROVED

Louis E. Crane

TERRITORIAL HIGHWAY ENGINEER

RECOMMENDED FOR APPROVAL

[redacted]

PRINCIPAL HIGHWAY ENGINEER
Bureau of Public Roads.

RECOMMENDED FOR APPROVAL

[redacted]

CHIEF ENGINEER Bureau of Public Roads

APPROVED

[redacted]

DIRECTOR Bureau of Public Roads

R.M. Beth		9-35
		11-35
K.B.H. & H.V.M.		11-35
K.B.H.		11-35

4351.1