STATE	PROJ. NO.	FISCAL YEAR	SHEET NO.	TOTAL SHEETS
HAWAII	D-50-01-64	1964	1	3

INDEX TO DRAWINGS

SHEET NO.	DESCRIPTION
1	TITLE SHEET
2	TYPICAL SECTION
3	PLAN & PROFILE

STATE OF HAWAII

DEPARTMENT OF TRANSPORTATION

HIGHWAYS DIVISION

"AS BUILT" PLANS FOR

RESURFACING OF A PORTION OF

KAUAI BELT ROAD

(F.A.P. PROJECT NO. F-12 (17)

PROJECT NO. D-50-01-64

DISTRICTS OF KOLOA AND LIHUE

ISLAND OF KAUAI

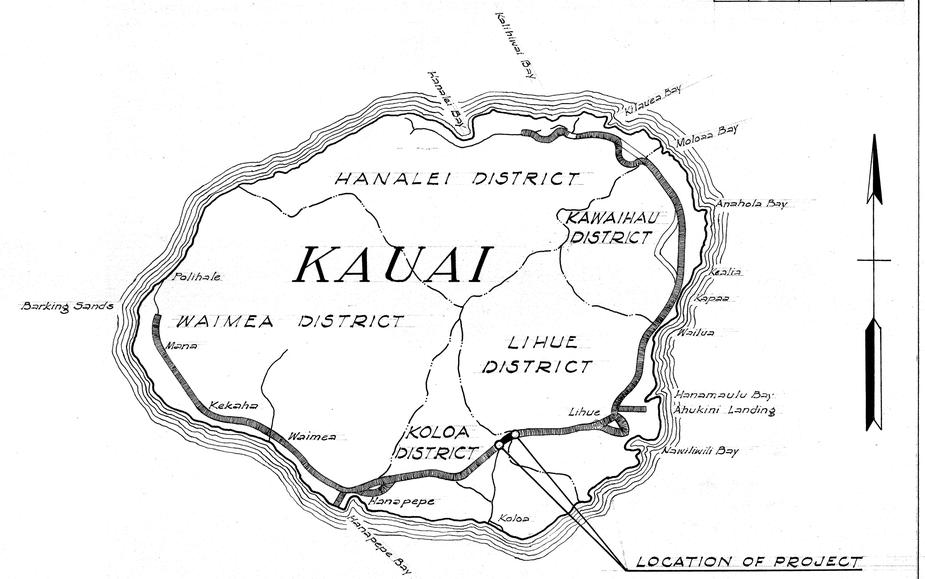

SCALES

PLAN	1 INCH = 100 FT.
PROFILE	HOR. 1 INCH = 100 FT.
	VER. 1 INCH = 10 FT.

CONVENTIONAL SIGNS

Baseline
Boundary Line
Fences (Named)
Existing Roadway
Pipe Culvert
Box Culvert
Telephone Line & Pole
Electric Line & Pole
Water Main

LAYOUT OF PROJECT

SCALE: 1" = 2000'

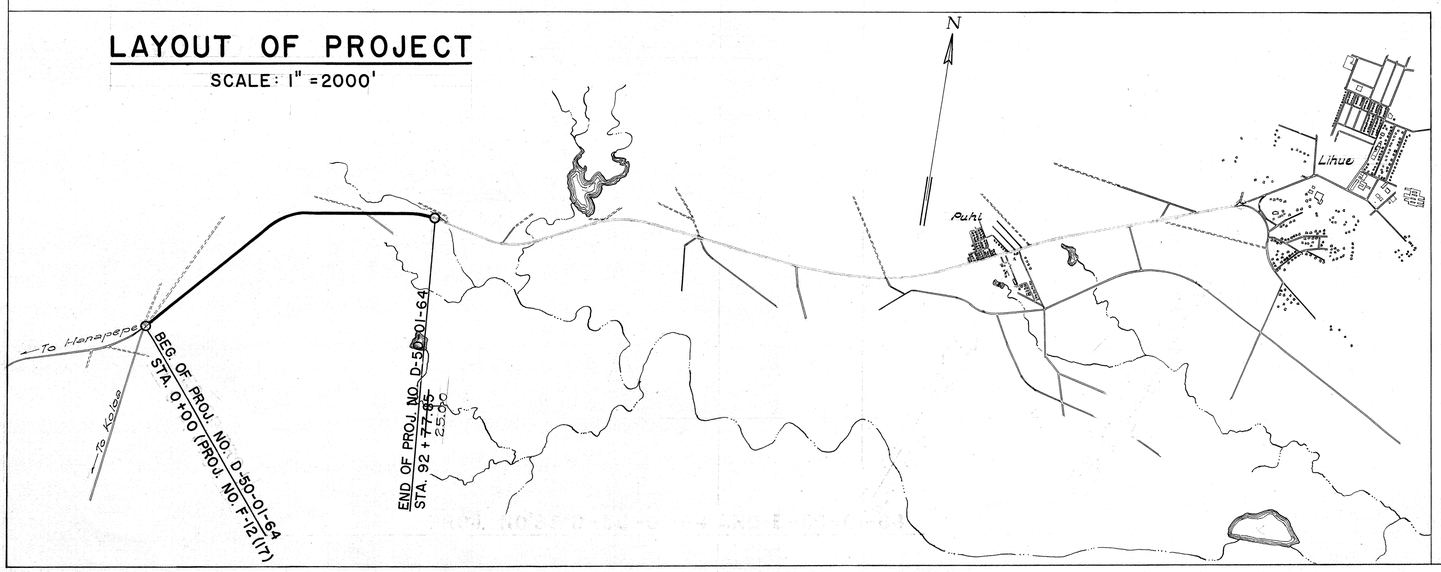

NOTE:

ALL CHANGES MADE DURING CONSTRUCTION HAVE BEEN NOTED IN RED ON THESE SHEETS AND CHECKED BY.

Shigeto Yamaguchi
PROJECT ENGINEER

3/9/67
DATE

APPROVED: DATE 4 May 64

Luis Ustarido
DIRECTOR OF TRANSPORTATION