PROJ. NO. D-50-02-64
DATE: 1964

INDEX TO DRAWINGS

SHEET NO.	DESCRIPTION
1	Title Sheet
2	Typical Section
3-4	Plan and Profile

STATE OF HAWAII

DEPARTMENT OF TRANSPORTATION

HIGHWAYS DIVISION

AS BUILT

PLANS OF

RESURFACING AND WIDENING OF A PORTION OF

KAUAI BELT ROAD

AT KAUMAKANI

PROJECT NO. D-50-02-64

DISTRICT OF WAIMEA

ISLAND OF KAUAI

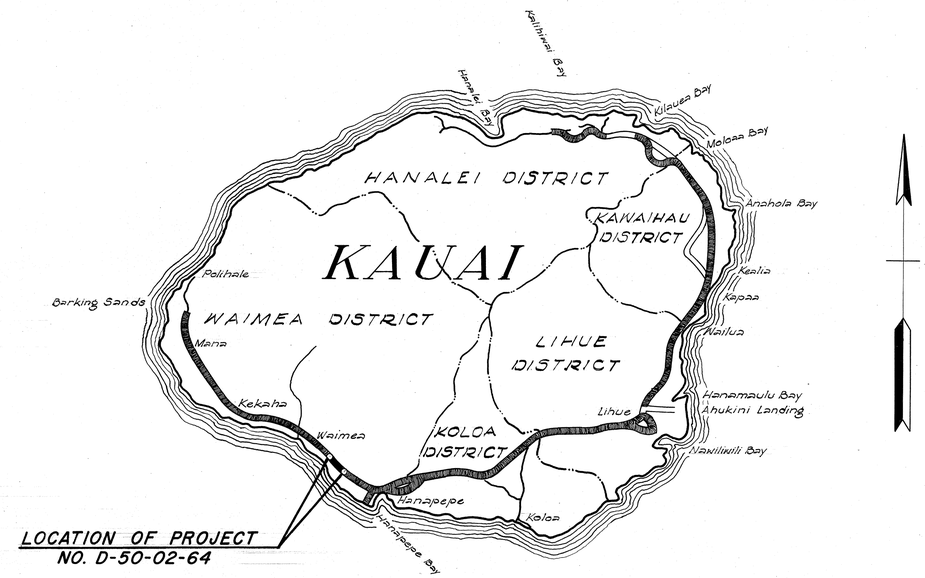

FEDERAL AID PROJECTS PREVIOUSLY CONSTRUCTED OR UNDER CONSTRUCTION

SCALES

PLAN	1 INCH = 100 FT.
PROFILE HOR.	1 INCH = 100 FT.
PROFILE VER.	1 INCH = 10 FT.

CONVENTIONAL SIGNS

Baseline (7.5)
Boundary Line
Fences (Named)
Existing Roadway
Pipe Culvert
Box Culvert
Telephone Line & Pole (T)
Electric Line & Pole (E)
Water Main (W_1)

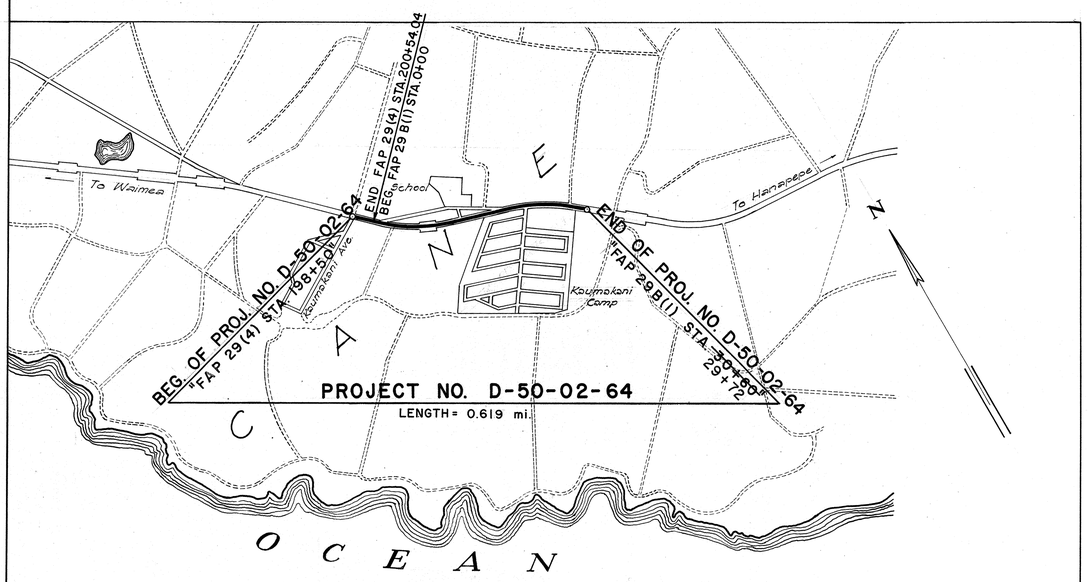

LAYOUT OF PROJECT

SCALE: 1" = 1000'

NOTE:

ALL CHANGES MADE DURING CONSTRUCTION HAVE BEEN NOTED IN RED ON THESE SHEETS AND CHECKED BY

Masami Murakami
PROJECT ENGINEER

9 Mar 67
DATE

APPROVED: DATE. 22 May 64

Jiro D. Matsuda
DIRECTOR OF TRANSPORTATION