


PED. ROAD DIST. No.	STATE	PROJ. No.	FISCAL YEAR	SHEET No.	TOTAL SHEETS
HAWAII	HAW.	C-50-01-66	1965	3	4

PLAN		BY	DATE
	SURVEYED		
	PLOTTED		
	ALIGNMENT CHECKED		
	RT. OF WAY CHECKED		
NO.			

PROFILE	SURVEYED		BY	DATE
	PLOTTED			
	GRADES CHECKED			
	B. M. S. NOTED			
	STRUCTURE NOTATIONS CH'KD.			
NO.				

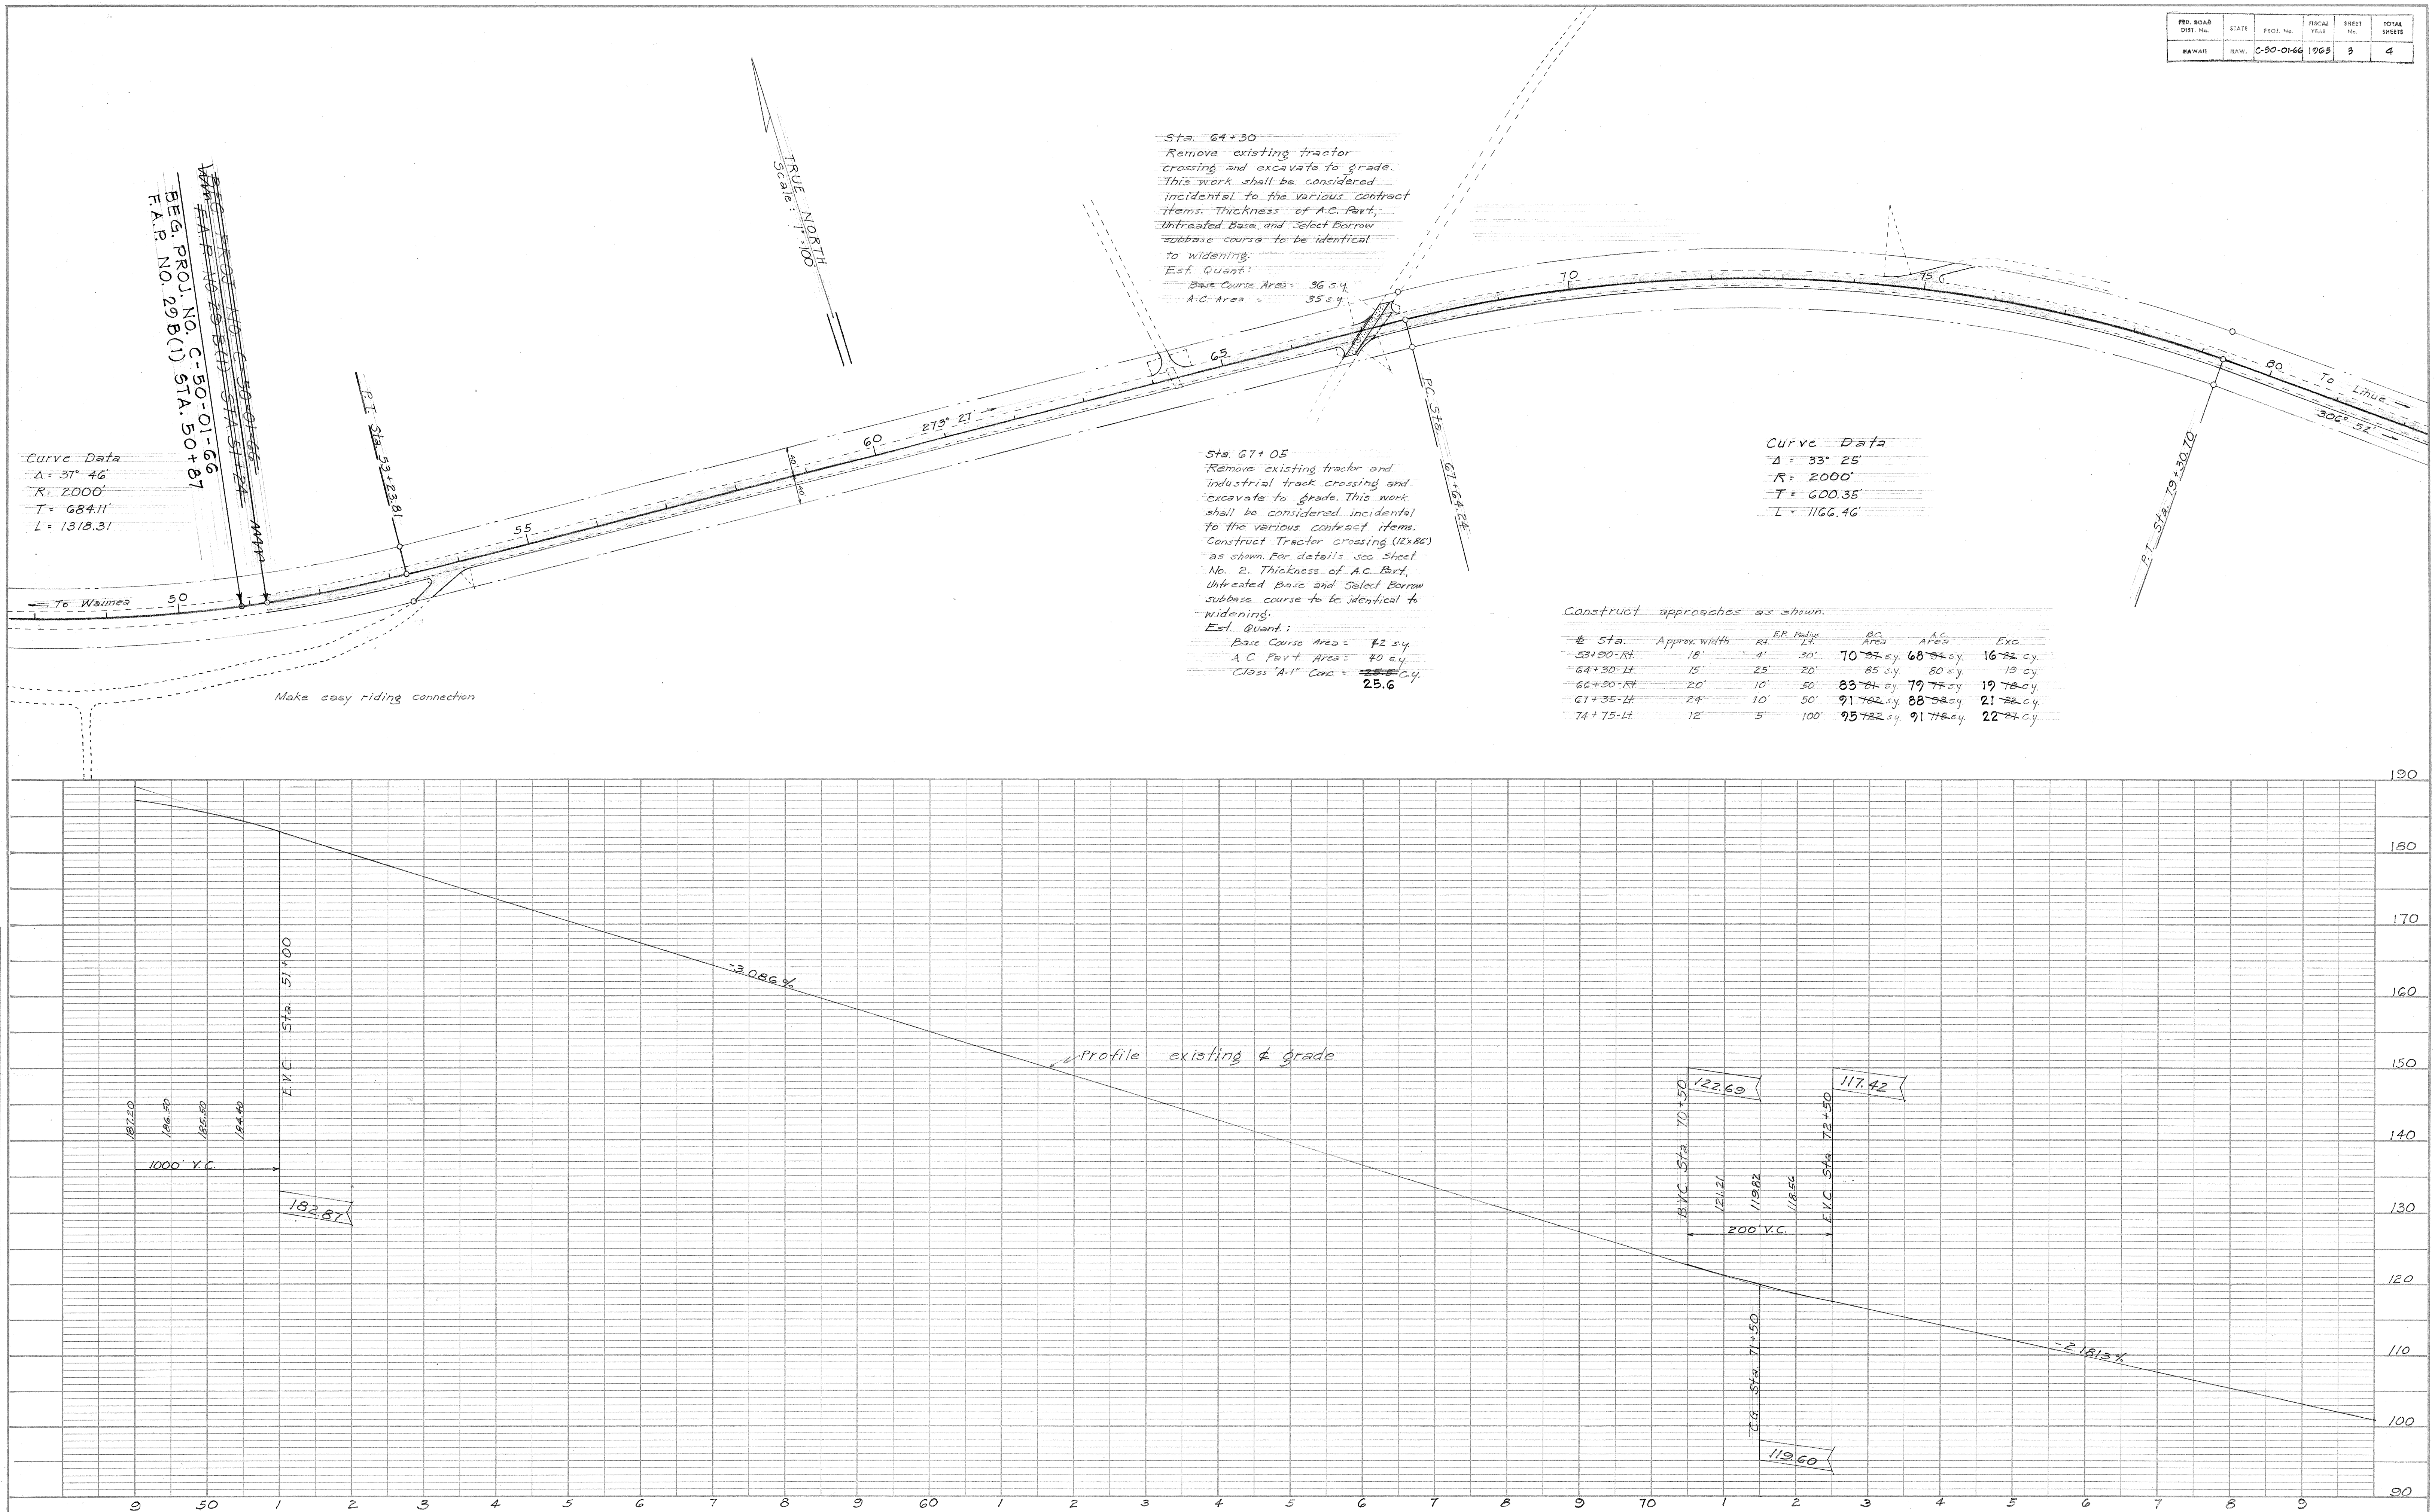

FED. ROAD DIST. No.	STATE	PROJ. No.	FISCAL YEAR	SHEET No.	TOTAL SHEETS
HAWAII	HAW.	C-50-01-66	1965	4	4

