FED. ROAD DIST. No.	STATE	PROJ. No.	FISCAL YEAR	SHEET No.	TOTAL SHEETS
HAWAII	HAW.	C-50-01-66	1965	1	4

INDEX TO DRAWINGS

SHEET NO.	DESCRIPTION
1	Title Sheet
2	Typical Section
3-4	Plan and Profile

STATE OF HAWAII

DEPARTMENT OF TRANSPORTATION

HIGHWAYS DIVISION

"AS BUILT" PLANS FOR

RESURFACING AND WIDENING OF A PORTION OF

KAUAI BELT ROAD

(KAUMAKANI TOWARD HANAPEPE)

PROJECT NO. C-50-01-66

DISTRICT OF WAIMEA

ISLAND OF KAUAI

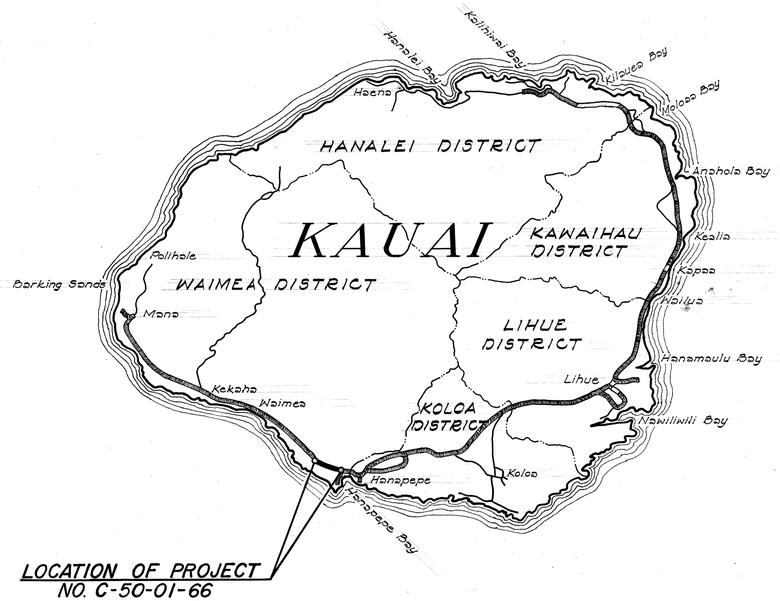

SCALES

PLAN	1 INCH = 100 FT.
PROFILE	HOR. 1 INCH = 100 FT.
	VER. 1 INCH = 10 FT.

CONVENTIONAL SIGNS

Baseline (7 | 5)
Boundary Line
Fences (Named)
Existing Roadway
Pipe Culvert
Box Culvert
Telephone Line & Pole (T)
Electric Line & Pole (E)
Water Main (W)

FEDERAL AID PROJECTS PREVIOUSLY CONSTRUCTED OR UNDER CONSTRUCTION

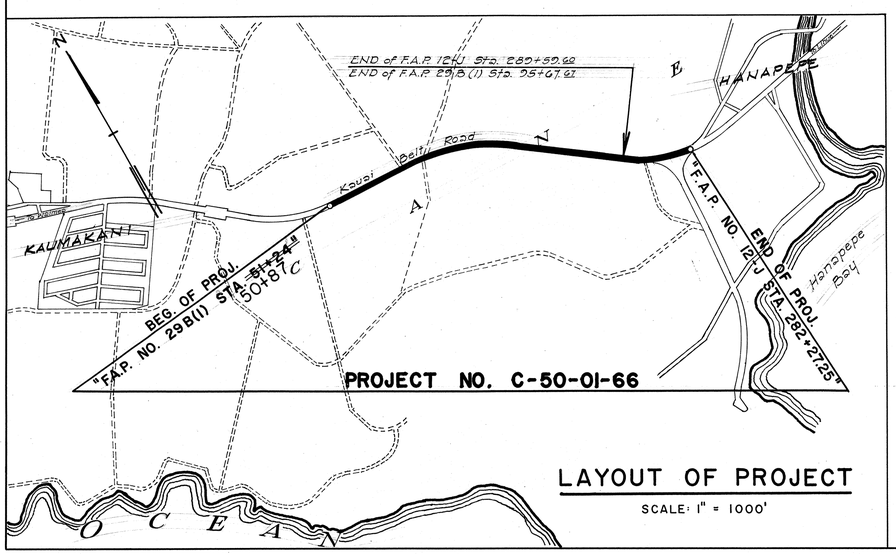

LAYOUT OF PROJECT

SCALE: 1" = 1000'

NOTE:
ALL CHANGES MADE DURING CONSTRUCTION HAVE BEEN NOTED IN RED ON THESE TRACINGS AND CHECKED BY:

Shigeto Yamaguchi — RESIDENT ENGINEER

4/6/67 — DATE

APPROVED: DATE 27 Nov 65

Tsuyo Matsuda
DIRECTOR OF TRANSPORTATION