DIST. NO.	STATE	PROJ. NO.	FISCAL YEAR	SHEET NO.	TOTAL SHEETS
HAWAII	HAW.	50D-03-69	1970	1	14

INDEX TO DRAWINGS

SHEET NO	DESCRIPTION
1	TITLE SHEET
2-3	PLAN & PROFILE
4	MISCELLANEOUS DETAIL
5-6	CROSS SECTIONS
7-14	STANDARD DETAILS

STATE OF HAWAII
DEPARTMENT OF TRANSPORTATION
HIGHWAYS DIVISION

AS-BUILT

PLANS FOR

SAFETY IMPROVEMENTS ON KAUMUALII HIGHWAY VICINITY OF HULEIA BRIDGE

PROJECT NO. 50D-03-69

DISTRICT OF LIHUE
ISLAND OF KAUAI

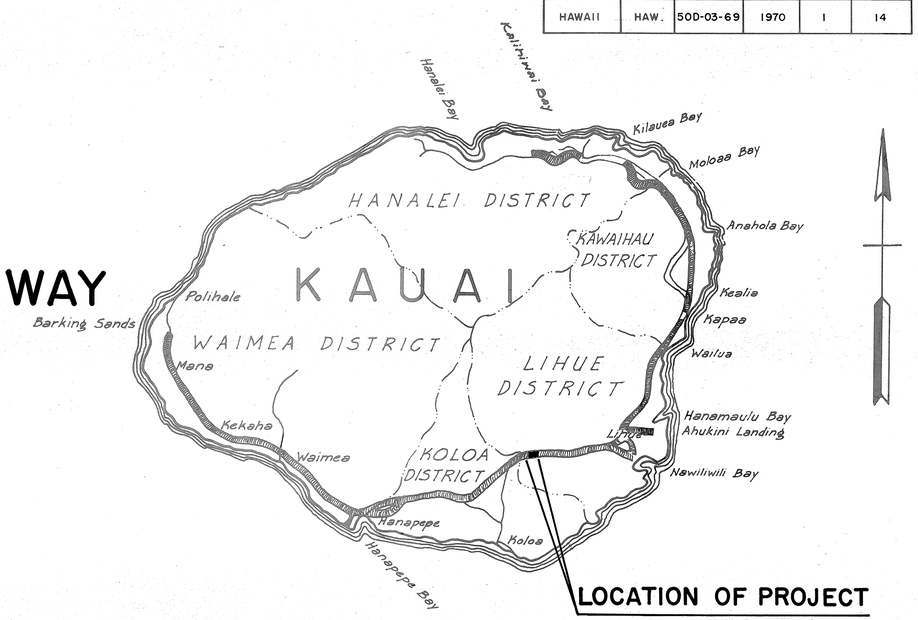

FEDERAL AID PROJECTS PREVIOUSLY CONSTRUCTED OR UNDER CONSTRUCTION

NOTE:
ALL CHANGES MADE DURING CONSTRUCTION HAVE BEEN NOTED IN RED ON THESE TRACINGS AND CHECKED BY:

Wayne Hinagumi
PROJECT ENGINEER

Feb. 15, 1972
DATE

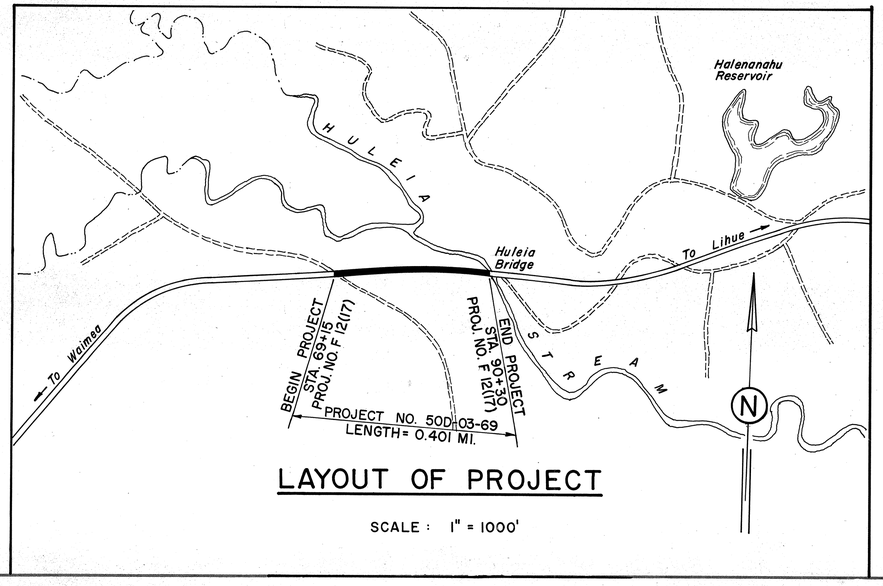

LAYOUT OF PROJECT

SCALE : 1" = 1000'

DEPARTMENT OF TRANSPORTATION
STATE OF HAWAII
APPROVED:
for E. Alvey Wright 8/13/70
DIR. OF TRANSPORTATION DATE

Kauai District Mike Miura - Design Unit "C" 548221-301 June 1970
Designed By P S & E By Phone-Loc. Date

ORIGINAL PLAN	SURVEY PLOTTED BY	DATE
	DESIGNED BY	
	DRAWN BY	
	TRACED BY	
NOTE BOOK No.	QUANTITIES BY	
	QUANTITIES CHECKED BY	
	CHECKED BY	

PRINTED ON ULTRAGEN 100% AGEPROOF