DIST. NO.	STATE	PROJ. NO.	FISCAL YEAR	SHEET NO.	TOTAL SHEETS
HAWAII	HAW.	50A-01-71	1971	1	6

INDEX TO DRAWINGS

SHEET NO.	DESCRIPTION
1	TITLE SHEET
2	TYPICAL SECTIONS
3 - 4	PLAN SHEETS
5 - 6	STANDARD DETAIL

STATE OF HAWAII
DEPARTMENT OF TRANSPORTATION
HIGHWAYS DIVISION

"AS BUILT"
PLANS FOR

KAUAI BELT ROAD RESURFACING
WAHIAWA TO HANAPEPE

PROJ. NO. 50A-01-71

DISTRICT OF KOLOA
ISLAND OF KAUAI

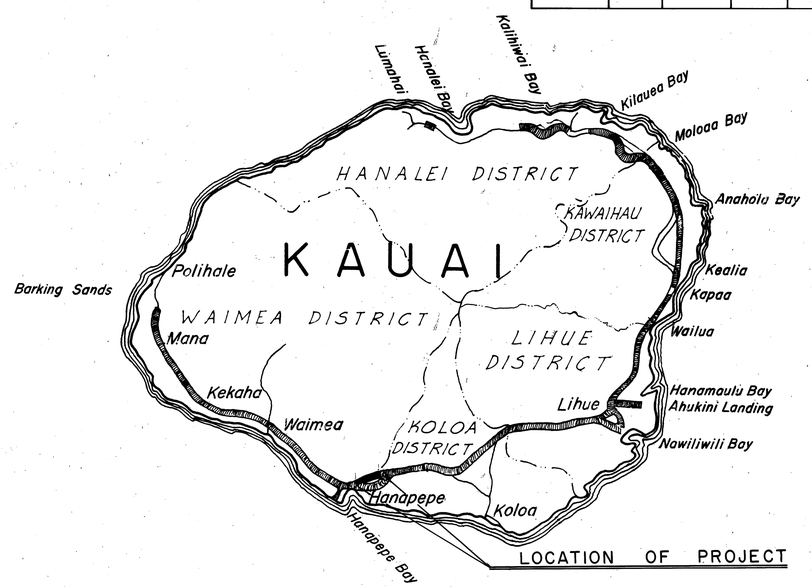

FEDERAL AID PROJECTS PREVIOUSLY CONSTRUCTED OR UNDER CONSTRUCTION

ALL CHANGES MADE DURING CONSTRUCTION HAVE BEEN INCORPORATED ON THESE PLANS EXCEPT CHANGES IN THE ORIGINAL THEORETICAL QUANTITIES.

Donald Nagamine 8-11-81
PROJECT ENGINEER DATE

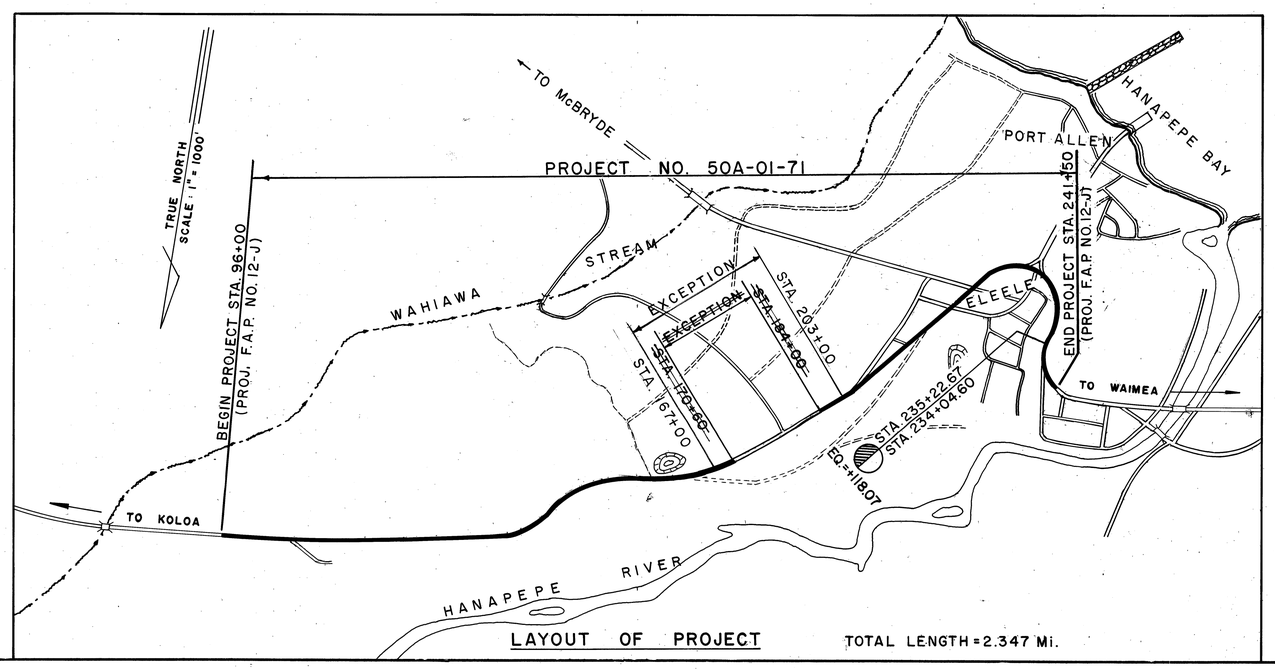

LAYOUT OF PROJECT TOTAL LENGTH = 2.347 Mi.

DEPARTMENT OF TRANSPORTATION STATE OF HAWAII	
APPROVED:	
for C. Leroy Wright DIR. OF TRANSPORTATION	10/6/70 DATE

Kauai District
Designed By

R. Mikami
PS&E By

548-2211-374
Phone-Loc

Oct. 1970
Date

ORIGINAL PLAN	SURVEY PLOTTED BY: DATE
	DESIGNED BY:
	DRAWN BY:
	TRACED BY:
NOTE BOOK No.	QUANTITIES BY:
	QUANTITIES CHECKED BY:
	CHECKED BY:

PRINTED ON ULTRALEN 150M AGEPROOF