FED. ROAD DIST. NO.	STATE	PROJ. NO.	FISCAL YEAR	SHEET NO.	TOTAL SHEETS
HAWAII	HAW.	50D-04-70	1970	2	17

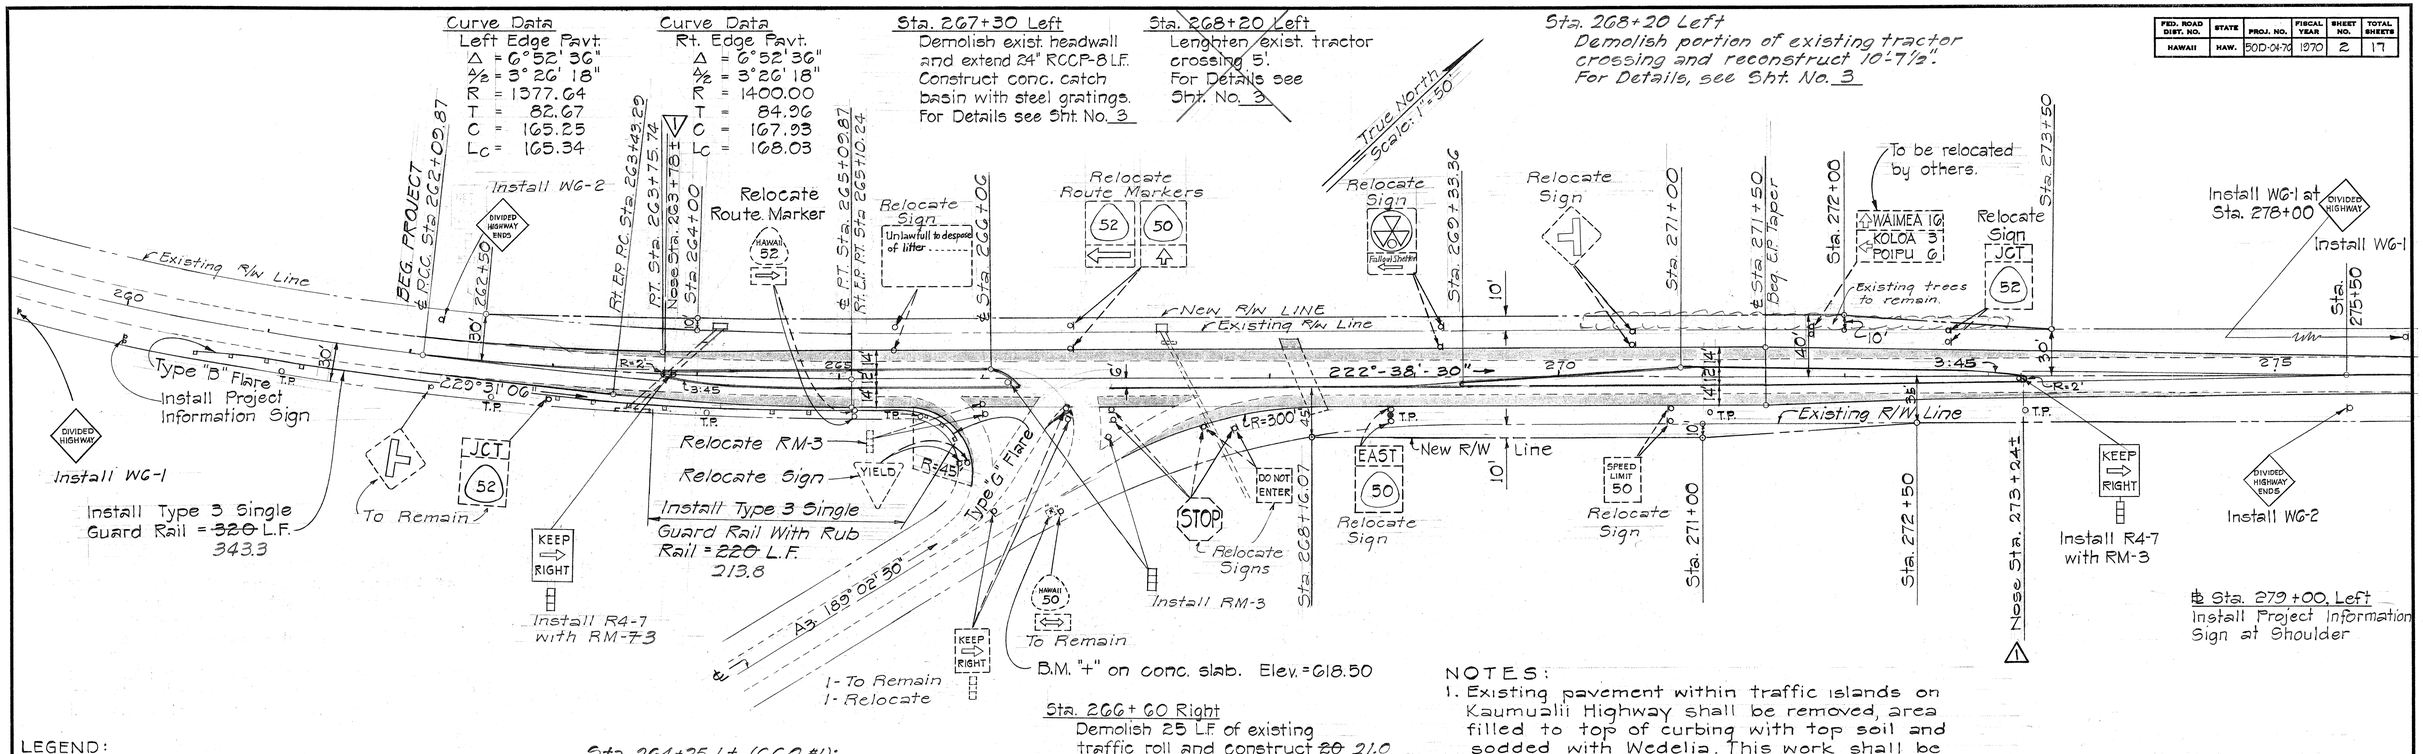

LEGEND:

- ----- Existing Facilities
- ——— New Facilities
- ○ Existing Telephone Poles
- ● Telephone Poles to be relocated by others.

Sta. 264+25 Lt. (C.C.O. #1):

Demolish existing headwall and extend 24" RCCP-8 L.F., and construct new headwall

Sta. 266+60 Right

Demolish 25 L.F. of existing traffic roll and construct ~~20~~ 21.0 L.F. of new Type G Curb. Relocate R4-7 sign and RM3.

NOTES:

1. Existing pavement within traffic islands on Kaumualii Highway shall be removed, area filled to top of curbing with top soil and sodded with Wedelia. This work shall be considered incidental to the various items of work.
2. Demolishing of existing concrete structures, as called for, shall be considered as incidental to the various items of work.
3. End Project and roadway widening taper at Sta. 276+00.
4. Provide one open lane both ways during working hours and two open lanes during non-working hours.
5. Utility poles within highway right of way to be relocated by others before Contractor's Notice to Proceed is issued.
6. The Engineer shall furnish the Contractor with the necessary informations and data on azimuths and centerline monument locations.
7. Contractor shall order all critical items as soon as Award is made. Critical items to be determined by the Engineer.
8. Placement of Pavement Markers to be determined by the Engineer.
9. All azimuths are referred to Δ Kilohana.

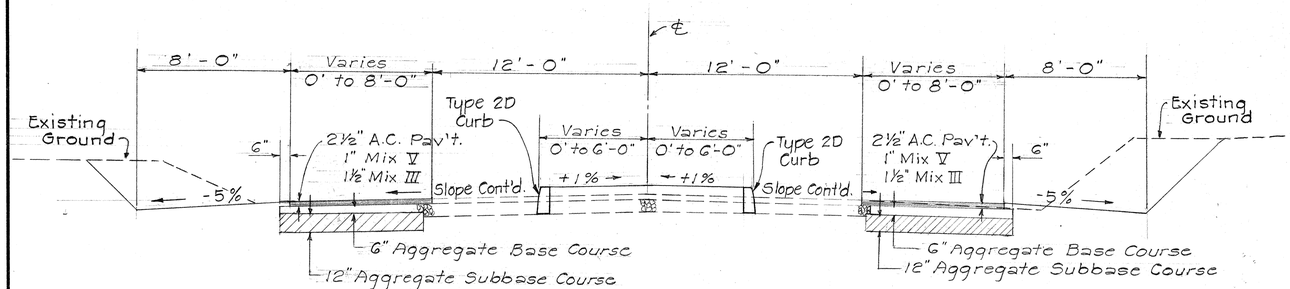

TYPICAL SECTION OF ROADWAY

Scale: ¼" = 1'-0"

ORIGINAL PLAN	SURVEY PLOTTED BY	DATE
	DRAWN BY	"
	TRACED BY	"
NOTE BOOK	DESIGNED BY	"
	QUANTITIES BY	"
No.	CHECKED BY	"

Δ - ADDENDUM NO. 1
October 22, 1970

STATE OF HAWAII
DEPARTMENT OF TRANSPORTATION
HIGHWAYS DIVISION

PLAN AND TYPICAL SECTION

KAUMUALII AND MALUHIA ROAD INTERSECTION IMPROVEMENTS

PROJECT NO. 50D-04-70

SHEET No. 1 OF 1 SHEETS

PRINTED ON NO. 1000H CLEARPRINT