DIST. NO.	STATE	PROJ. NO.	FISCAL YEAR	SHEET NO.	TOTAL SHEETS
HAWAII	HAW.	50A-01-72	1972	3	7

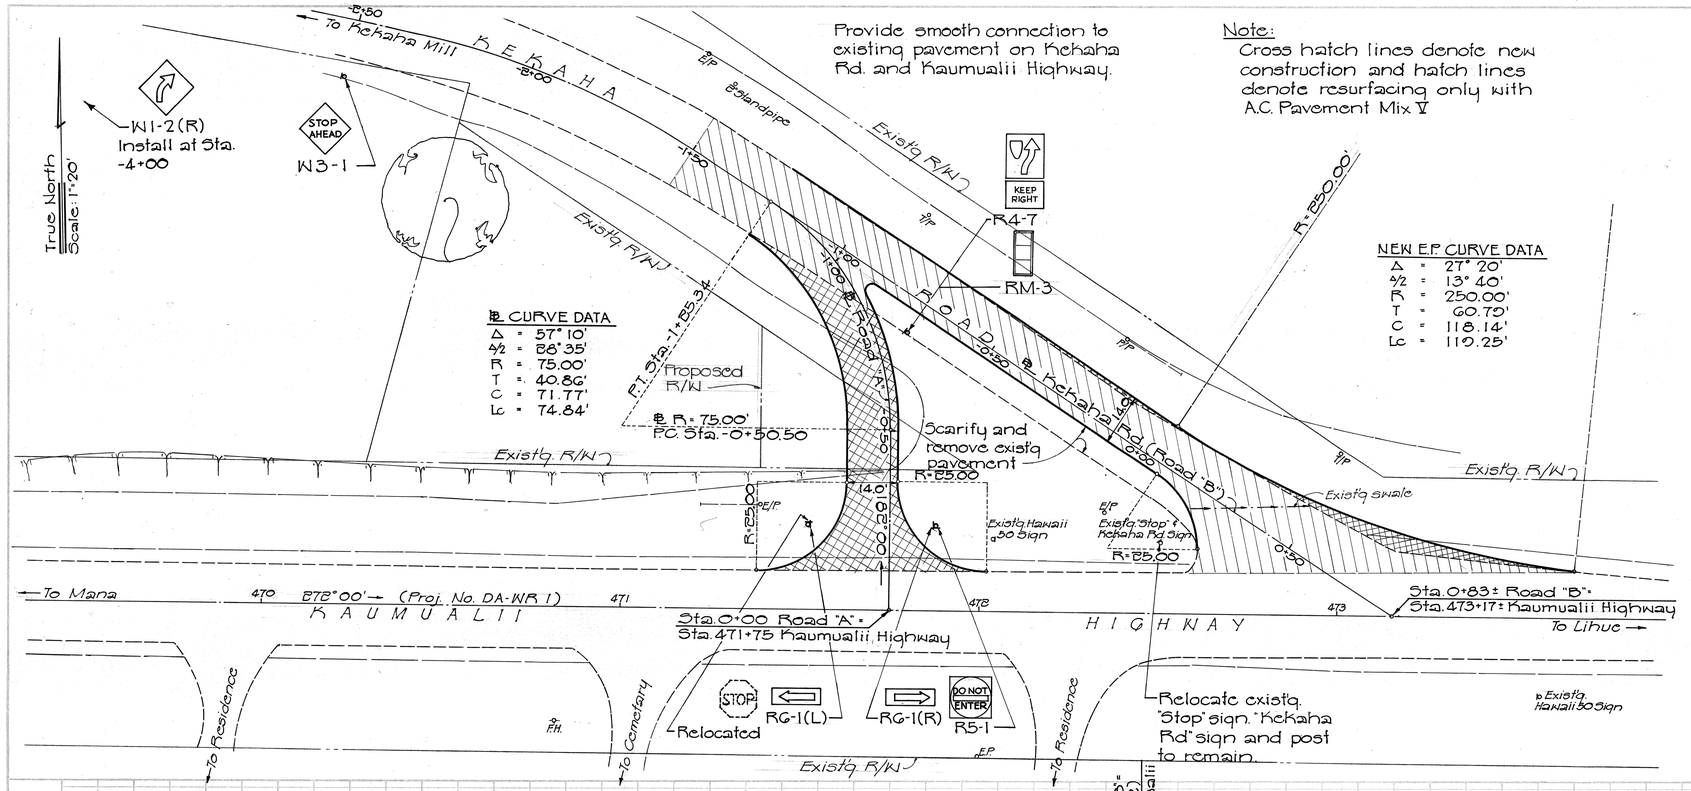

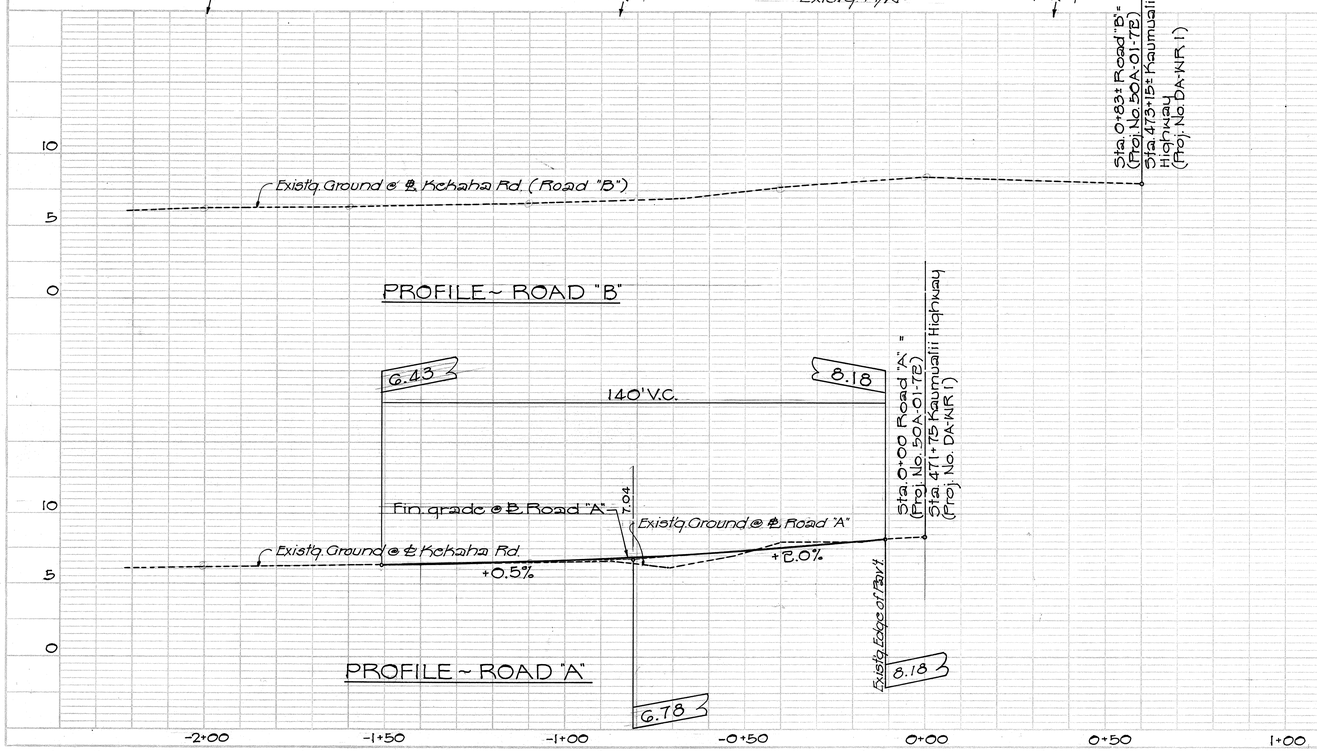

PLATE 1, PLAN-PROFILE
KEUFFEL & ESSER CO.