FED. ROAD DIST. NO.	STATE	~~FED. AID~~ PROJ. NO.	FISCAL YEAR	SHEET NO.	TOTAL SHEETS
HAWAII	HAW.	50CD-01-70	1974	19	49

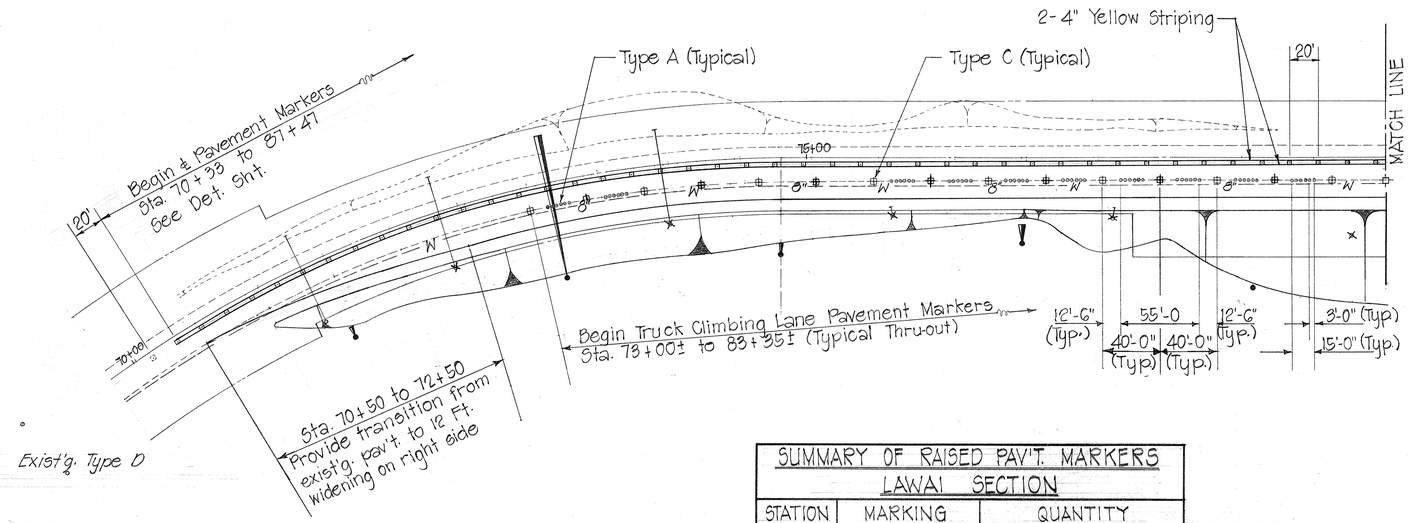

SUMMARY OF RAISED PAV'T. MARKERS LAWAI SECTION				
STATION	MARKING	QUANTITY		
		TYPE A	TYPE C	TYPE D
73+33 to 87+47	Centerline	—	—	~~87~~ 86
	Trucklane	174 ~~156~~	30 ~~27~~	—

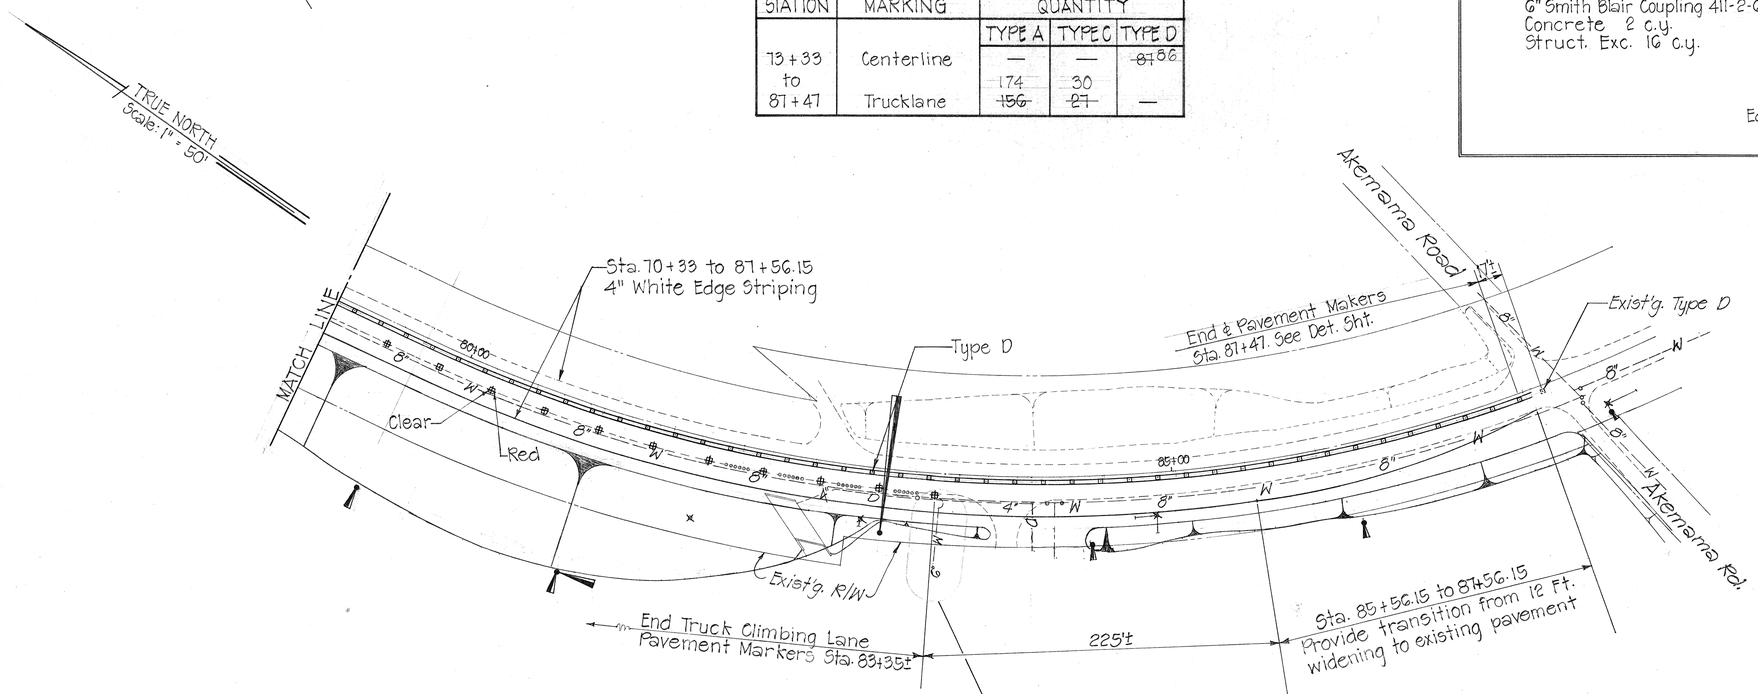

NOTE:

All Electrical, Telephone, and T.V. Cable works shall be done by the Kauai Electric, Hawaiian Telephone Co., and Derby Cable Vision, respectively.

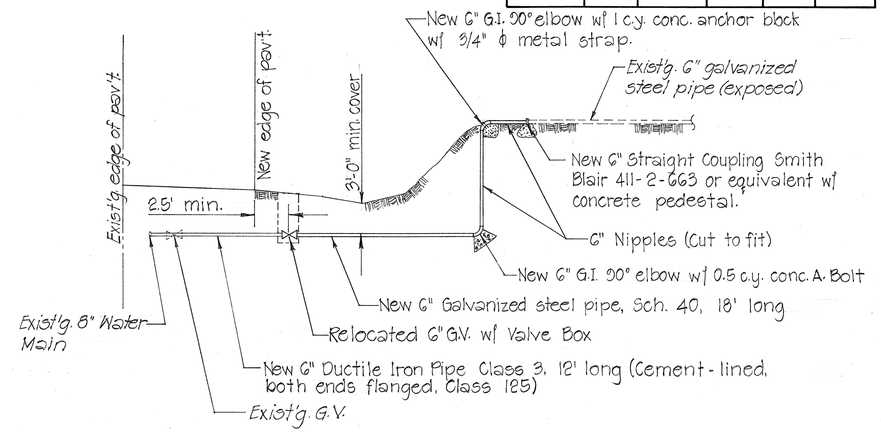

PROFILE Not to Scale

ESTIMATED QUANTITIES:

6" Ductile Iron Pipe, Class 3 12 L.F.
6" Galvanized Steel Pipe, Class 250 28± L.F.
6" Galvanized Steel Pipe, 90° Elbow 2 ea.
6" Smith Blair Coupling 411-2-663 1 ea.
Concrete 2 c.y.
Struct. Exc. 16 c.y.

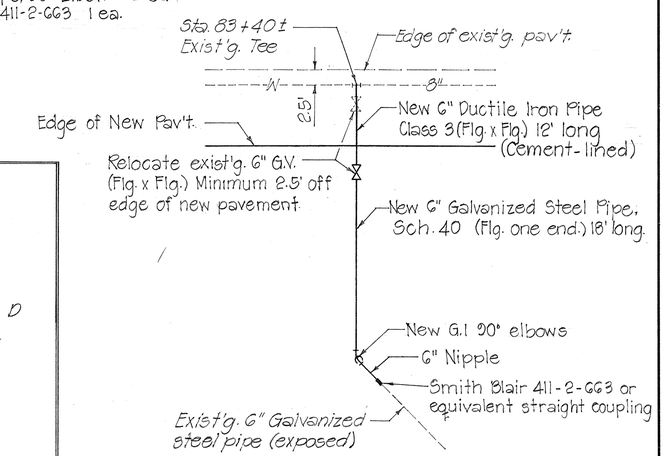

PLAN Not to Scale

INSET

Not to Scale

DATE	REVISION
3-22-74	ADD. NO. 1 Note for Electrical, Telephone and T.V. Cable works.

KENNETH F. IBARA REGISTERED PROFESSIONAL ENGINEER No. 2094 HAWAII, U.S.A.

THIS WORK WAS PREPARED BY ME OR UNDER MY SUPERVISION.

Kenneth F. Ibara
Signature
2/13/73

STATE OF HAWAII
DEPARTMENT OF TRANSPORTATION
HIGHWAYS DIVISION

PAV'T. MARKER & UTILITY RELOCATION PLAN

LAWAI SECTION

TRUCK CLIMBING LANES AT THREE LOCATIONS (WAHIAWA, LAWAI AND OMAO VALLEY)

PROJ. No 50 CD-01-70

ADD. 19