


FED. ROAD DIST. NO.	STATE	PROJ. NO.	FISCAL YEAR	SHEET NO.	TOTAL SHEETS
HAWAII	HAW.	50DE-01-86M	1986	4	12

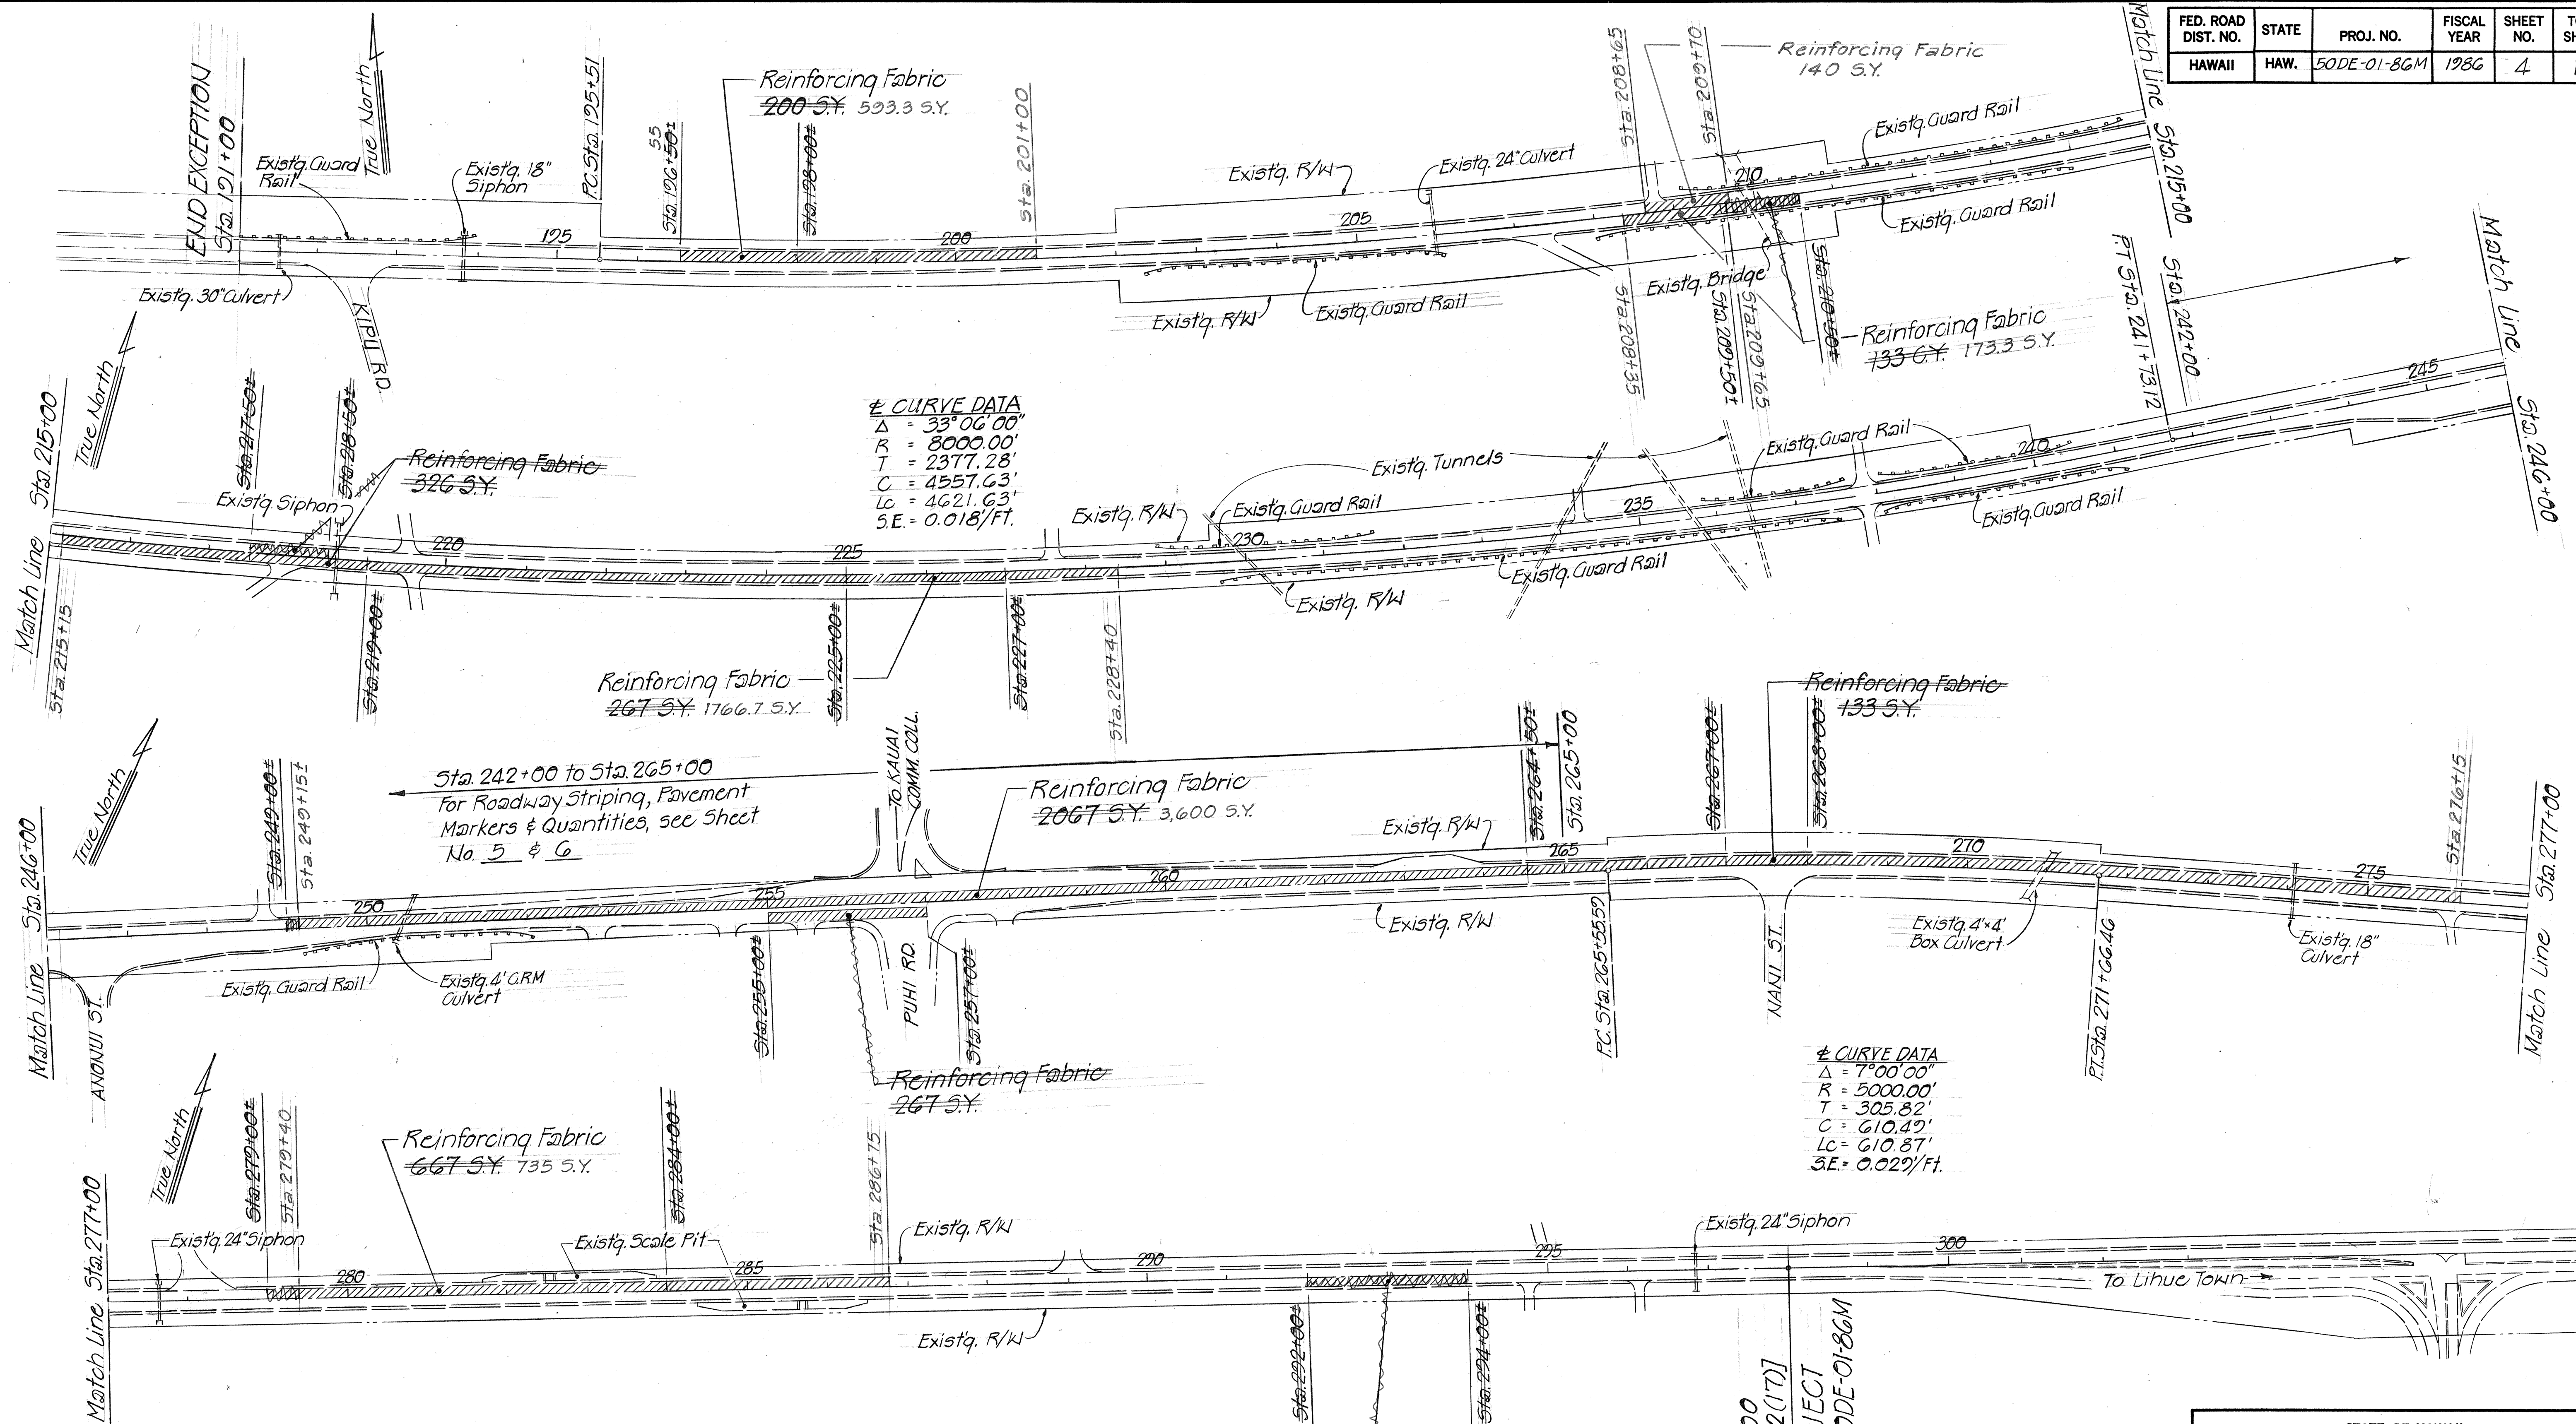

DATE	
SURVEY PLOTTED BY	
DRAWN BY	
CHECKED BY	
NOTE BOOK	
QUANTITIES BY	
CHECKED BY	

Sta. 298+00
[Proj. No. F12(17)]
END PROJECT
PROJ. No. 50DE-01-86M

STATE OF HAWAII
DEPARTMENT OF TRANSPORTATION
LAND TRANSPORTATION FACILITIES DIVISION

PLAN
KAUMUALII HIGHWAY RESURFACING
LIHUE TO PUHI
PROJ. No. 50DE-01-86M
Scale: 1"=100'
Aug. 1985

SHEET NO. 1 OF 1 SHEETS