


FED. ROAD DIST. NO.	STATE	FED. AID PROJ. NO.	FISCAL YEAR	SHEET NO.	TOTAL SHEETS
HAWAII	HAW.	STP-050-1(11)	1993	8	12

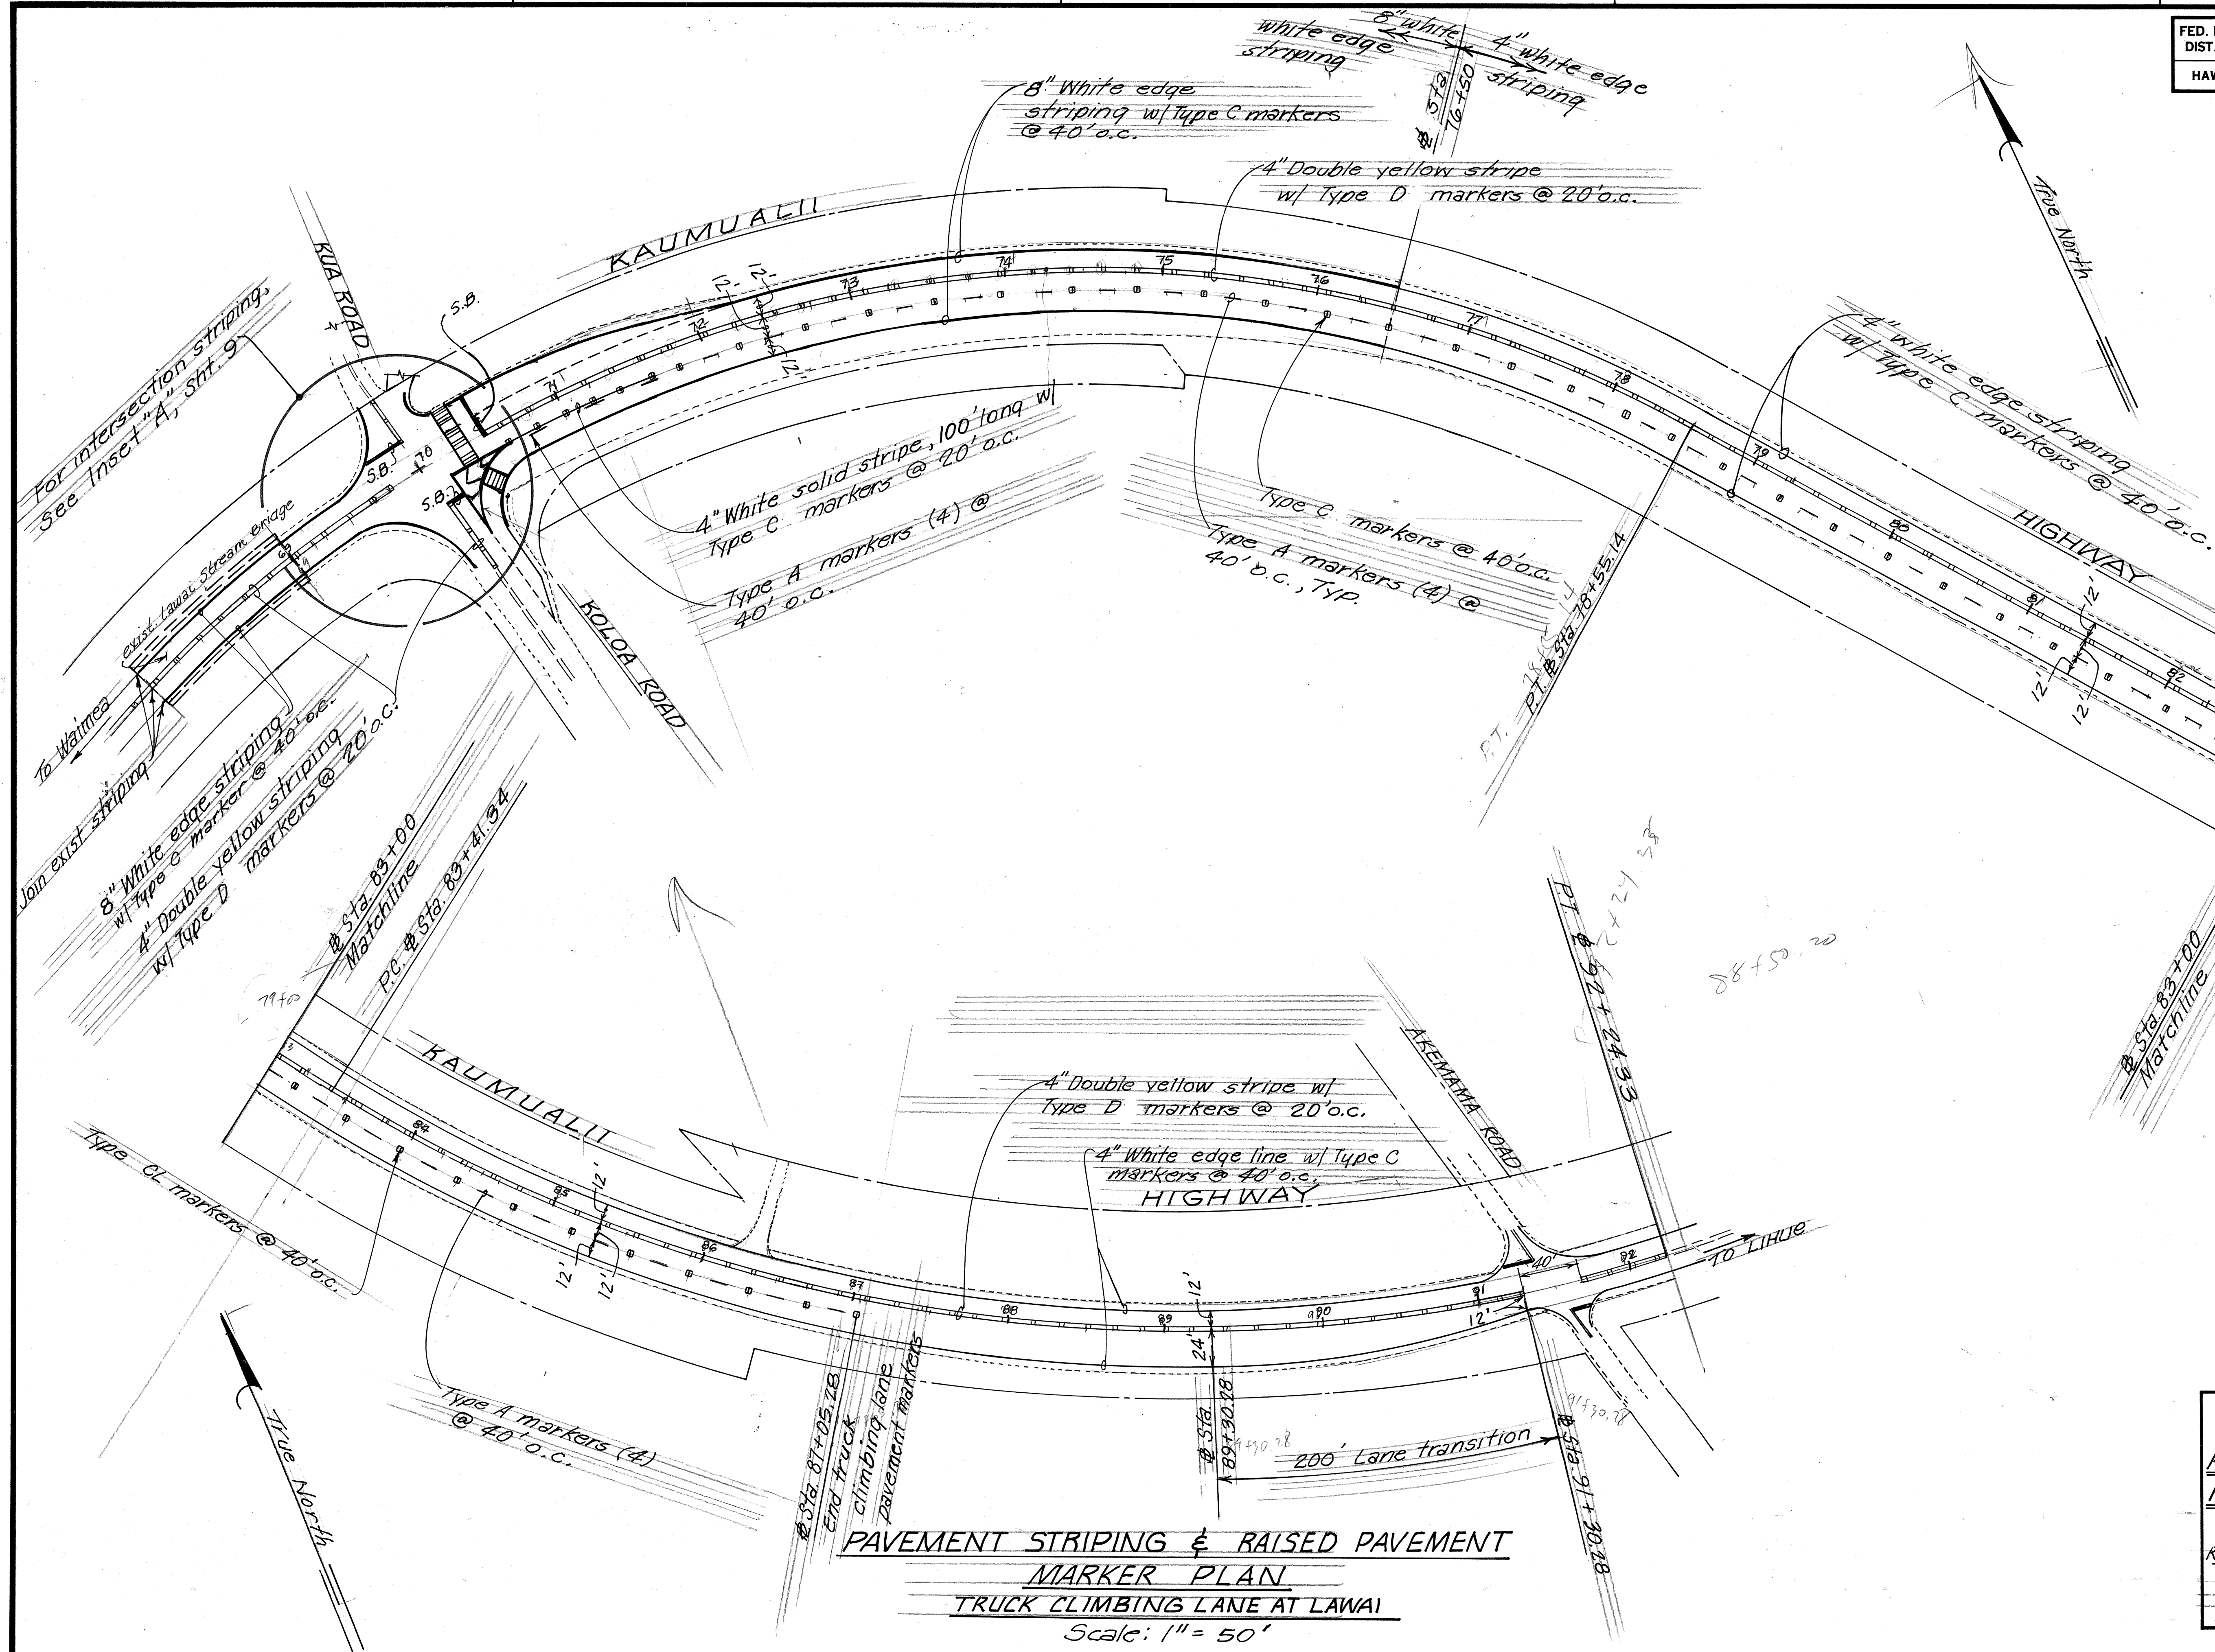


ORIGINAL PLAN	DATE
DESIGNED BY	
TRACED BY	
NOTED BY	
CHECKED BY	

STATE OF HAWAII DEPARTMENT OF TRANSPORTATION HIGHWAYS DIVISION
PAVEMENT STRIPING & RAISED PAVEMENT MARKER
PLAN
ROUTE 50, KAUMUALII HIGHWAY RESURFACING Lawai Bridge to Omao Road
PROJECT NO. STP-050-1(11) SCALE: AS SHOWN
MARCH 1993
SHEET No. 8 OF 12 SHEETS

DATE	
SURVEY PLOTTED BY	
DRAWN BY	
DESIGNED BY	
QUANTITIES BY	
CHECKED BY	
ORIGINAL PLAN	
NOTE BOOK	
NO.	

Curve Data (Kaunualii Hwy)
 $\Delta = 41^\circ 20'$
 $R = 2500'$
 $T = 943.01'$
 $L_c = 1803.51'$

FED. ROAD DIST. NO.	STATE	FED. AID PROJ. NO.	FISCAL YEAR	SHEET NO.	TOTAL SHEETS
HAWAII	HAW.	STP-050-1(11)	1993	10	12

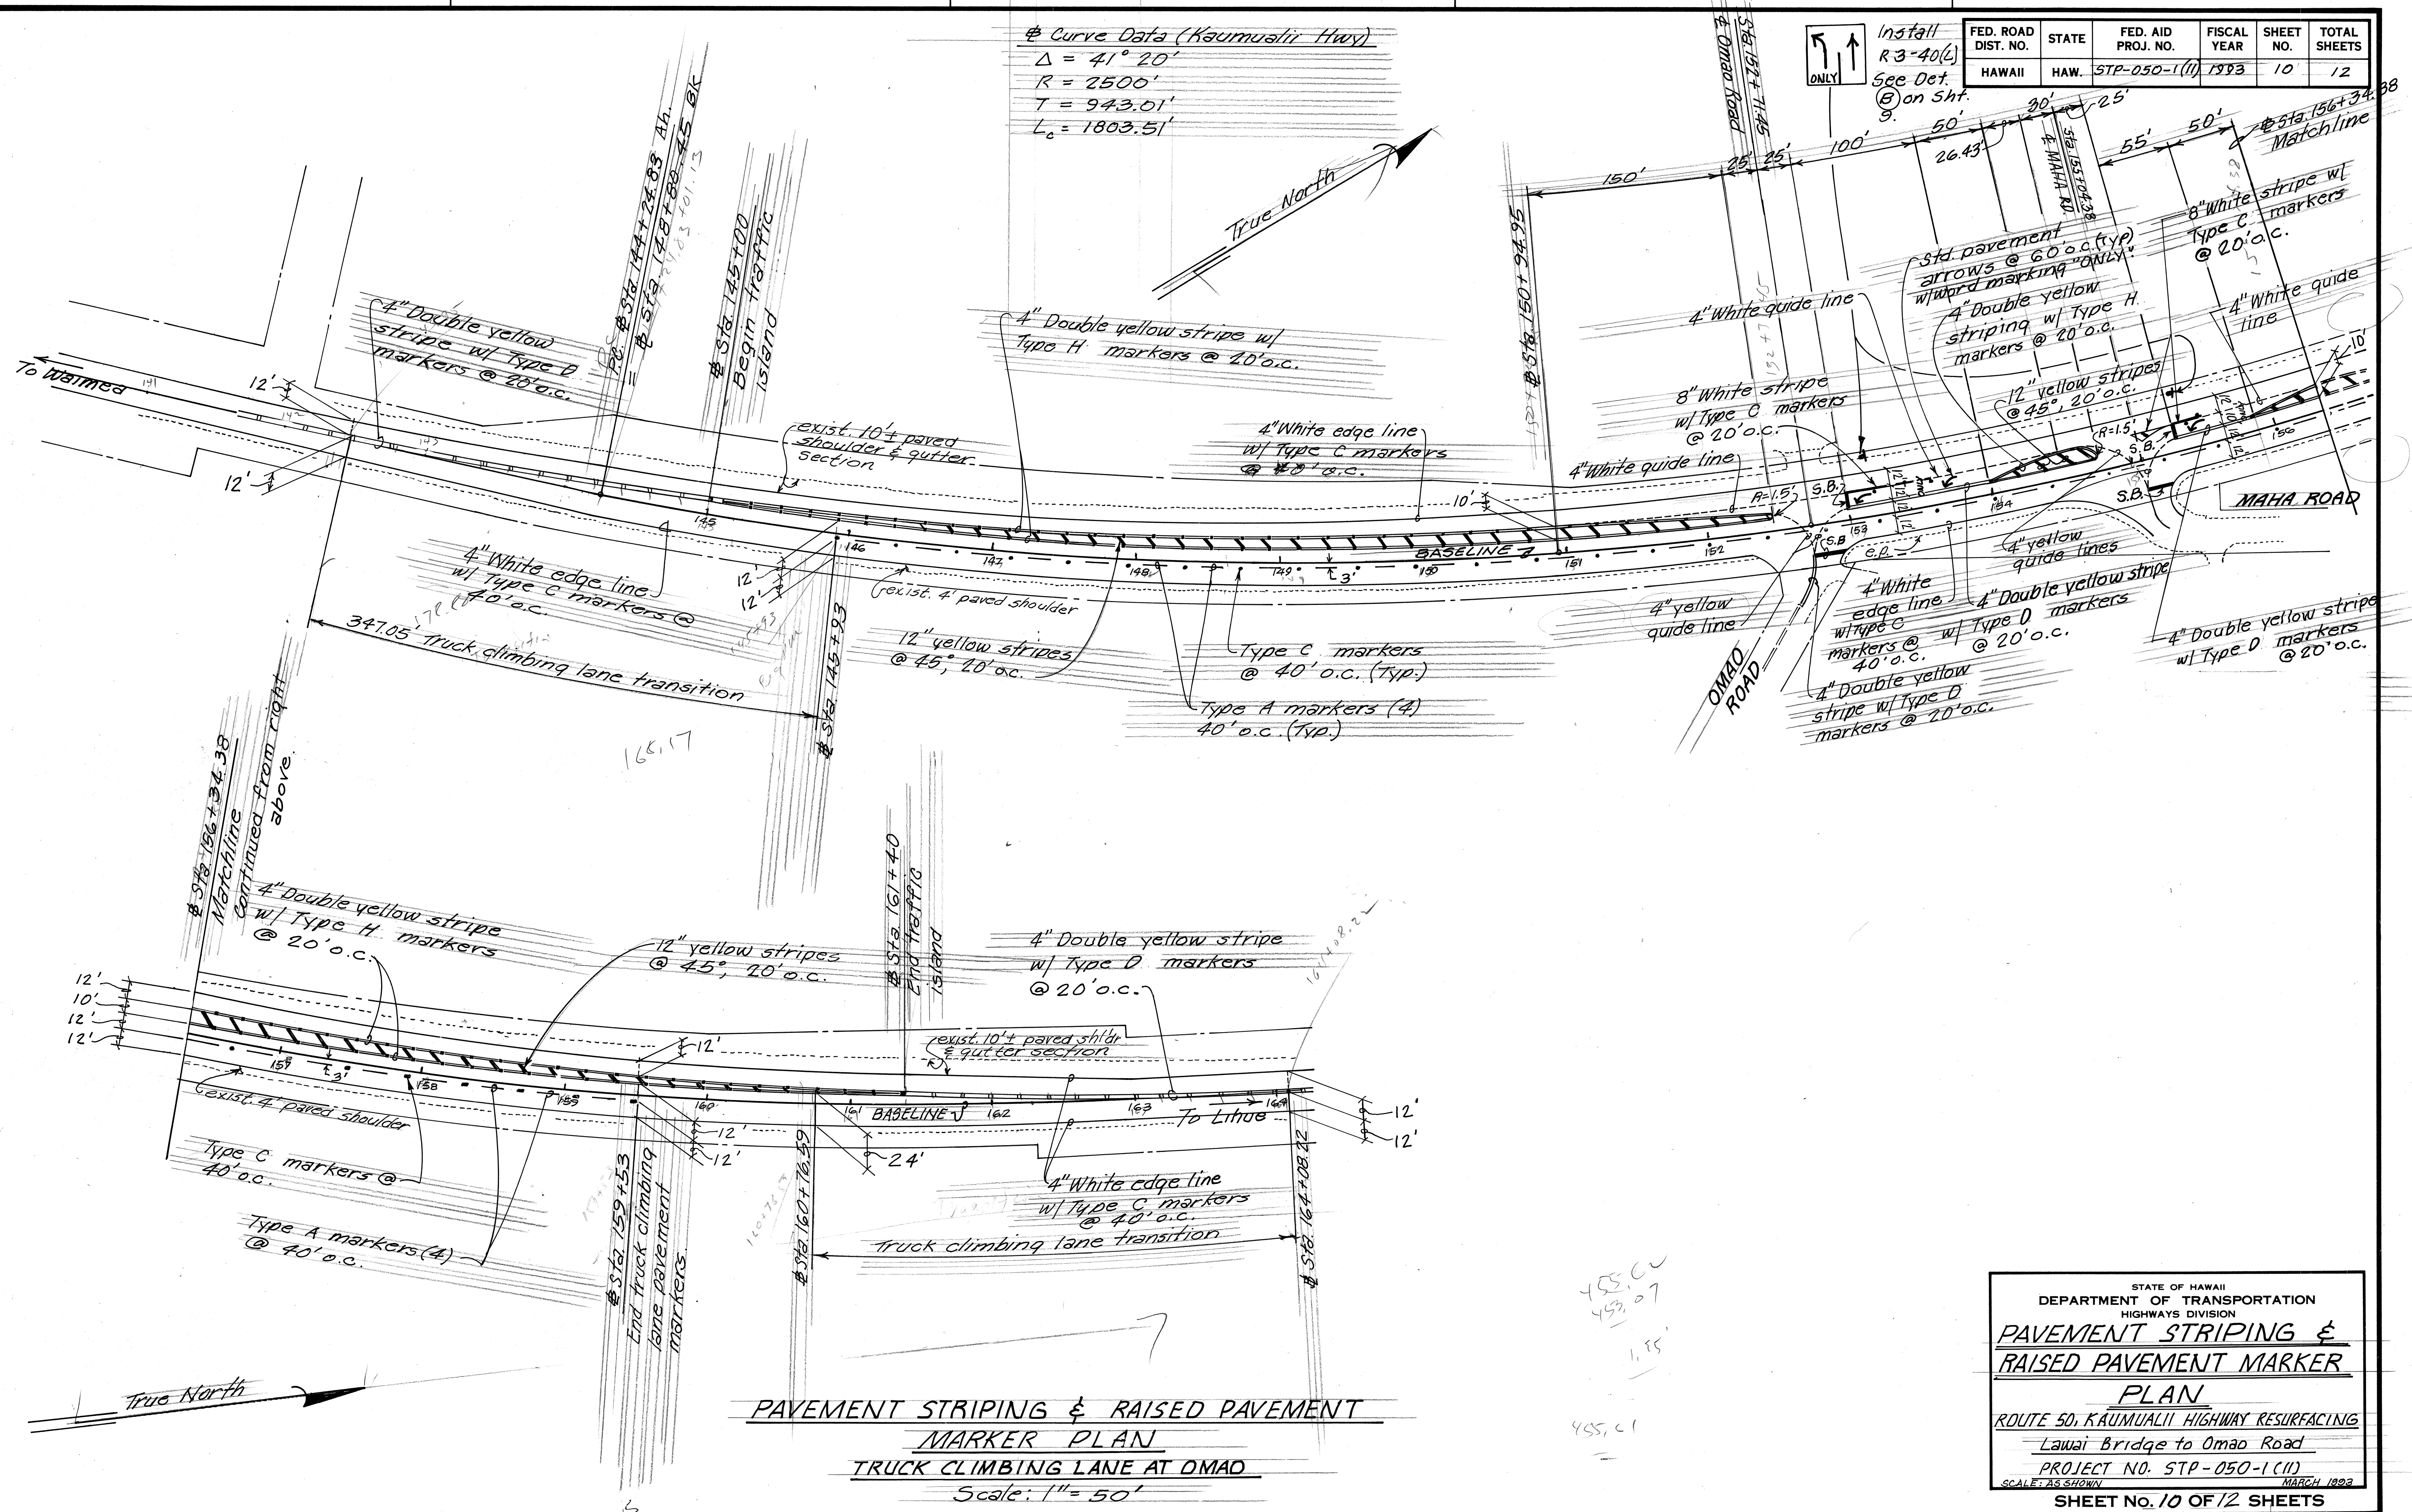

PAVEMENT STRIPING & RAISED PAVEMENT MARKER PLAN
TRUCK CLIMBING LANE AT OMAO
 Scale: 1" = 50'

STATE OF HAWAII
 DEPARTMENT OF TRANSPORTATION
 HIGHWAYS DIVISION

PAVEMENT STRIPING & RAISED PAVEMENT MARKER PLAN

ROUTE 50, KAUMUALII HIGHWAY RESURFACING
 Lawai Bridge to Omao Road
 PROJECT NO. STP-050-1(11)
 SCALE: AS SHOWN MARCH 1993

SHEET No. 10 OF 12 SHEETS